
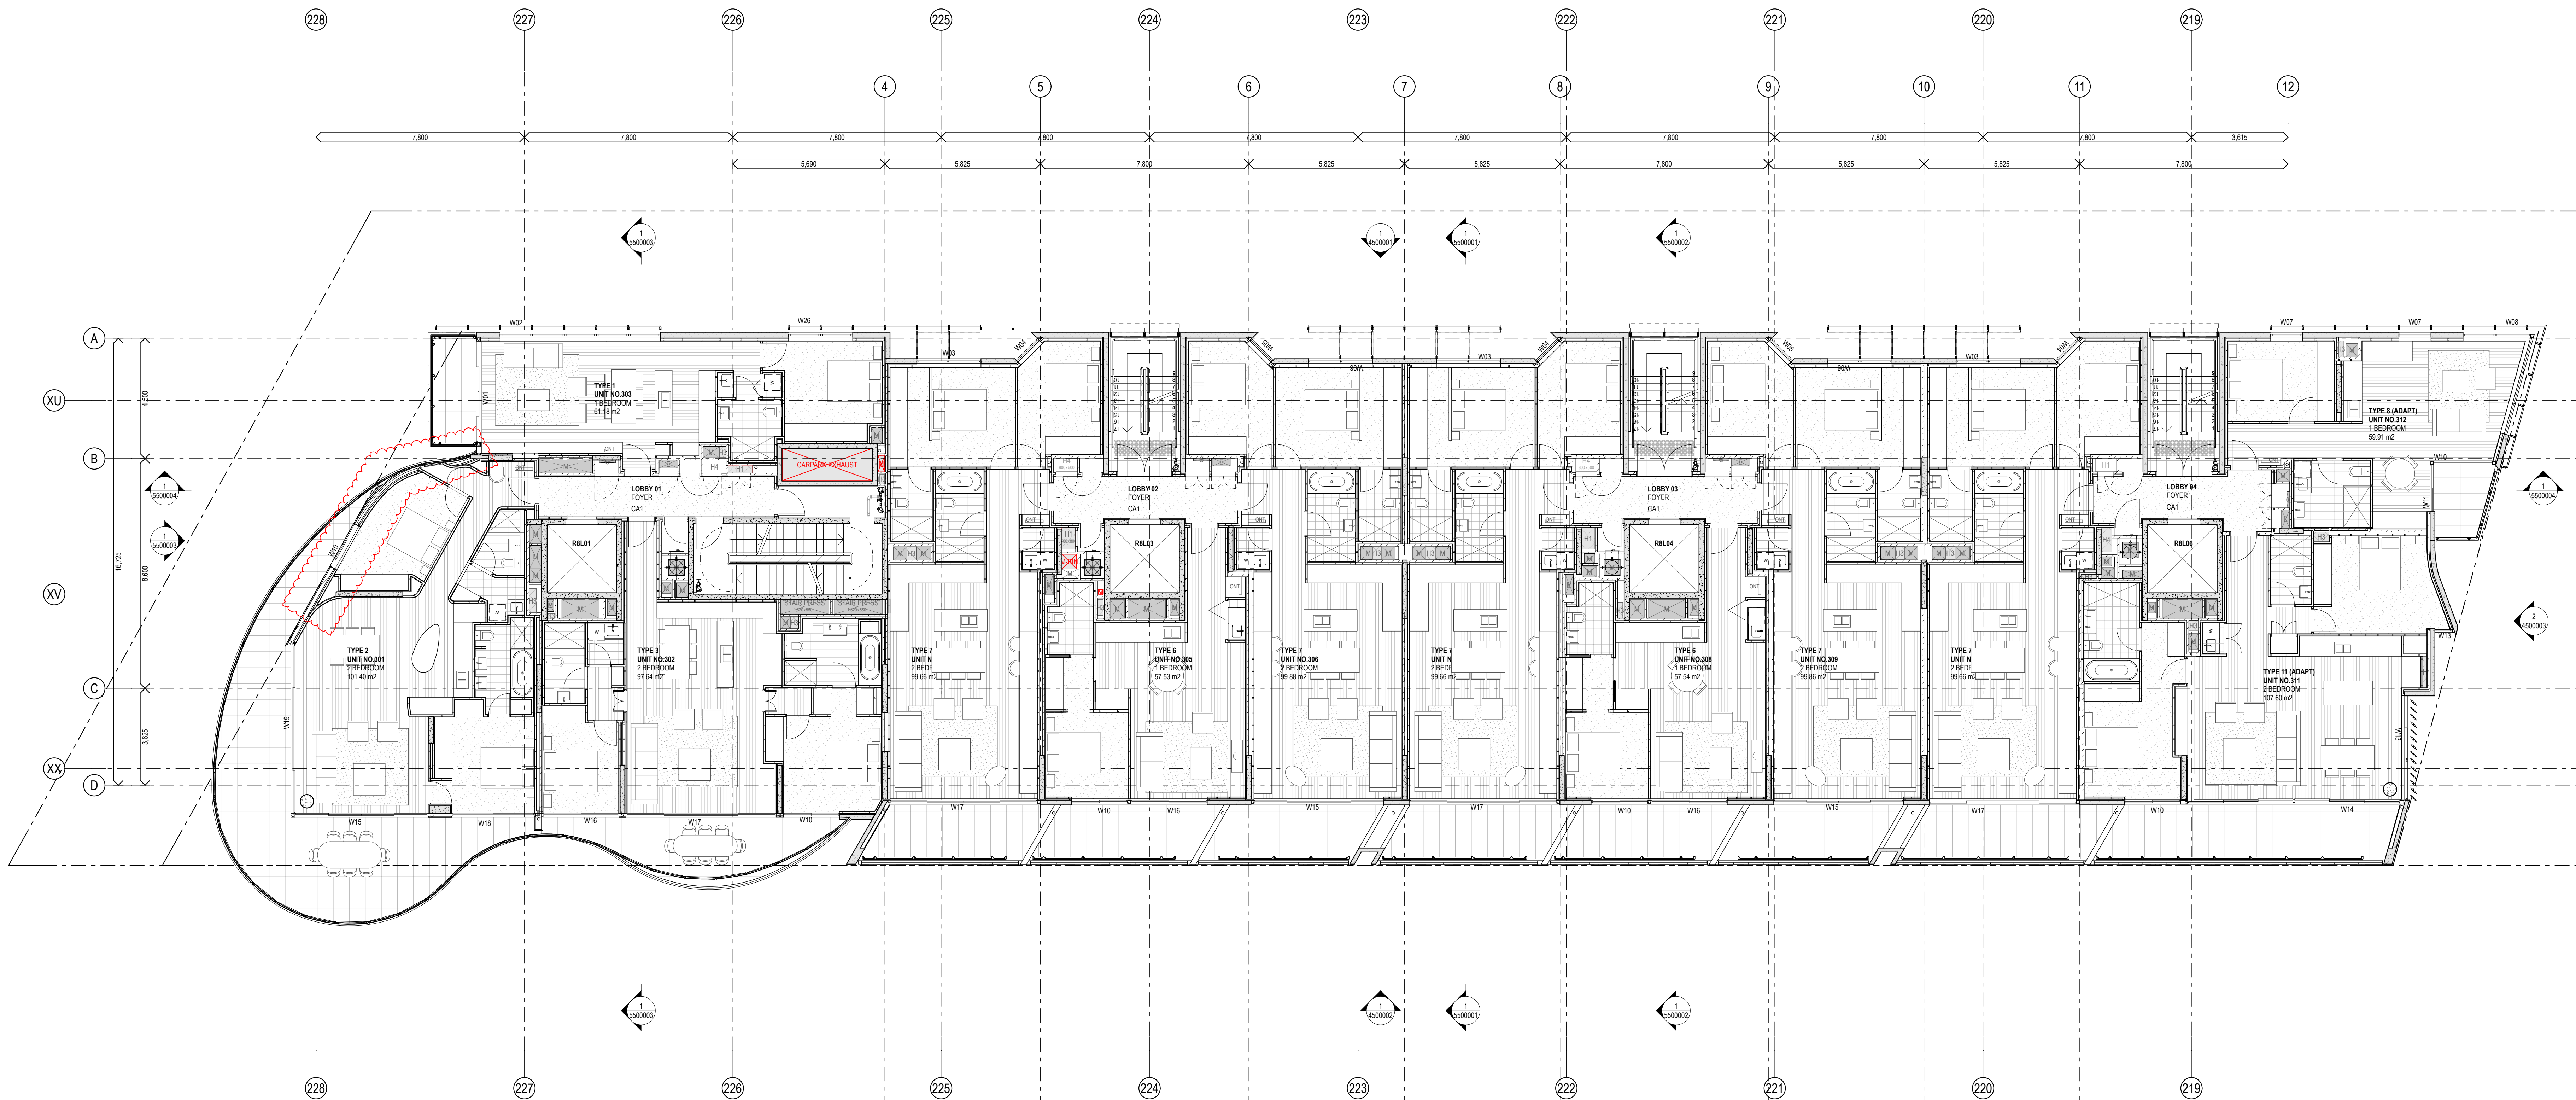


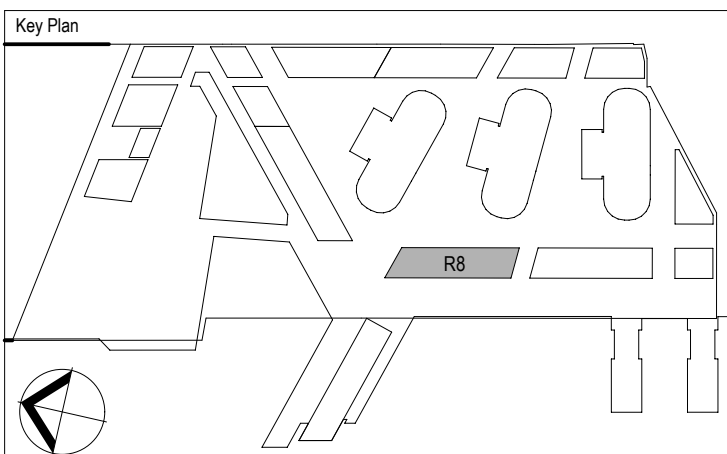

1 PLAN Level 3
1:100

NOTE - REFER TO INTERIOR ARCHITECTS PLANS FOR APARTMENT LAYOUTS, DETAIL PLANS & RCPs - DO NOT SET OUT INTERNAL WALLS OR FIXTURES FROM ARCHITECTURAL GA DRAWINGS
APARTMENT PLANS SHOWN ARE INDICATIVE OF INTERIOR ARCHITECTS LAYOUTS, SERVICES AND STRUCTURAL COORDINATION IS ONGOING
ADAPTABLE LAYOUTS PENDING APPROVAL BY BCA & ACCESS CONSULTANT
ALL PENTHOUSE APARTMENTS TO BE FINALISED BY INTERIOR ARCHITECTS
RISERS SHOWN IN RED REPRESENT BASEMENT SERVICES.

[illegible]

Architects

fjmt

francis-jones morrison thorpe

NOMINATED ARCHITECT: RICHARD FRANCIS-JONES (REG NO 5301)

SYDNEY
Level 5, 70 King Street
Sydney NSW 2000 Australia
T +61 2 9251 7077
F +61 2 9251 7072
E fjmt@fjmt.com.au
W www.fjmt.com.au

Principal



Lend Lease

Developer	Lend Lease
Project Management & Construction	Lend Lease
Design	Lend Lease

30 The Bond 30 Hickson Road
Millers Point NSW 2000

These designs, plans and specifications and the copyright therein are the property of Land Lease and must not be used, reproduced or copied wholly or in part without the written permission of Land Lease.

Project
BARANGAROO SOUTH

R8

FOR PPR ISSUE

**GENERAL ARRANGEMENT PLAN-
PPR
Level 3 Floor Plan**

Drawn By	Date	Purpose	Approved By	Date
JM	23/01/13	FOR INFO	JP	

SCALE 1:100 @ B1		1:250 @ A3
Site No.	Drawing No.	Revision
BR8	BR8AD3030000-05	