

St. Vincent's Hospital  
O'Brien Building Redevelopment  
Cnr Burton & Victoria Streets  
DARLINGHURST

BCA Capability Report to accompany a  
Development Application

15 December 2006

Prepared for:

Bligh Voller Nield Architects  
Level 6, 11 York Street,  
Sydney NSW 2000

Attention: Tim Brook

Prepared by:

Philip Chun and Associates Pty Ltd  
Accredited Certifiers, Building Regulation and Fire Safety Consultants

Suite 4, Level 4, 44 Hampden Road  
Artarmon NSW 2064  
Ph: 9412 2322  
Fax: 9412 2433

Contact: Philip Smillie

Signed.....

BUILDING REGULATION  
AND FIRE SAFETY CONSULTANTS

PHILIP CHUN AND  
ASSOCIATES PTY LTD  
TR. PHILIP CHUN AND  
ASSOCIATES (AUSTR)

ACH 007 401 949  
ABN 64 207 988 911

SUITE 4, LEVEL 4,  
44 HAMPDEN ROAD  
ARTARMON NSW

PHONE: 002 9412 2322  
FAX: 002 9412 2433

[www.pch.com.au](http://www.pch.com.au)

DIRECTORS:  
PHILIP CHUN  
GREG DE CANTAL  
ROBERT MARSHALL  
DANIE LOMATO  
PETER COZZOLINO  
MICHAEL MORAN  
RICHARD WELLS

ASSOCIATES:  
PHILIP SMILLIE  
YVONNA FLOREANCO

OFFICES IN  
MELBOURNE  
SYDNEY  
BROSBANE

## 1.0 Introduction and Designation

At the request of Bligh Volter Field Pty Ltd, this commission involves the Building Code Of Australia assessment of the proposed re-development of the O'Brien Building located at the corner of Burton and Victoria Streets, Darlinghurst.

The proposed re-development will comprise four levels of below ground car park with five levels of patient care and non-patient care above the car park. The O'Brien Building will be linked to the existing DeLacy Building in the northern end on levels 3, 4 and 5.

Following compliance with this report, we are confident that the design will meet the requirements of the deemed to satisfy provisions of BCA2006 and that where necessary alternative solutions will be proposed to meet the performance requirements of BCA2006.

The design is at a point where the inherent BCA philosophies have been checked and development consent can be sought. The finer details with respect to BCA2006 can be finalised prior to the issue of a Construction Certificate / building permit.

The drawings assessed are architectural drawings prepared by Bligh Volter Field Architects listed as follows:

Drawing No.	Drawing Title
A-02	Level 02 (RL25.66) car park
A-01	Level 01 (RL29.45) car park
A-00	Level 0 (RL31.25) car park
A-01 (B)	Level 1 (RL34.08) car park
Unnumbered plan (B)	Level 2 (RL38.88)
Unnumbered plan (B)	Level 3 (RL40.83)
Unnumbered plan (B)	Level 4 (RL44.38)
Unnumbered plan (B)	Level 5 (RL49.04)
Unnumbered plan (B)	Level 6 (RL52.64)
Unnumbered plan	Level 7 (RL58.64)
Unnumbered plan	Section 1

## 2.0 Use and Class of Buildings

Level	Use	Building Code of Australia Class
Levels 02, 01, 0 & 1	Car park	Class 7a
Level 2	Patient Care and non-Patient Care area of a Health Care Building	Class 9a
Level 3	Office	Class 5
Level 4	Office	Class 5
Level 5	Patient Care area of a Health Care Building	Class 9a
Level 6	Office	Class 5
Roof	Plant room	Class 9a

## 3.0 Construction

### Fire Resistance

The building has an effective height of 18.76m which is less than 25m. The rise in storeys is 5. Therefore, the building will be of minimum Type A construction. Refer to Appendix A for details of the required FRLs of various building elements.

Important points to note:

- Loadbearing internal wall and loadbearing fire wall must be of concrete or masonry.
- Non-loadbearing internal walls required to be fire resisting and walls forming service shafts must be of non-combustible construction.
- The roof can be of non-combustible construction if the building is protected with automatic sprinklers throughout.

### Material Control

The floor materials, floor coverings and wall and ceiling materials will be selected to comply with the fire hazard indices specified in Specification C1.10a.

## 4.0 Compartmentation

The O'Brien Building is considered as a united building under Part A4 of BCA, as it links with the adjoining buildings. It will be fire separated from the adjoining buildings at the levels where they are linked to each other. The separation will be in the form of 120/120/120 fire wall and openings will be protected with -/120/30 self closing fire door in accordance with C2.7(b) of BCA. Thus the O'Brien Building can be treated as a separate building for the purposes of Parts C, D and E of BCA. This will negate the requirement of upgrading the existing linked buildings. Thus, the adjoining buildings will be considered as another building standing on the same allotment.

The fire source feature will be the external wall of the adjoining building. Any opening in the external wall and within 6m of each other will be protected with external wall-wetting sprinklers. Furthermore, any part of the external wall which is within 15m of the highest part of the external wall of the lower building is considered exposed to the fire source feature under clause 2.1 of Specification C1.1. The external wall will require the FRL specified in Table 9 of Specification C1.1 and openings will be protected with external wall wetting sprinklers.

As the car park will consist >40 cars, automatic sprinkler protection is required. There is no limitation on the floor area for a sprinkler protected car park.

The Patient Care areas will be divided into fire compartments not exceeding 2000m<sup>2</sup>. The Ward areas will be divided into floor areas not more than 1000m<sup>2</sup> by walls with an FRL of 60/60/60 and they will further be divided into smoke compartments having a floor area not exceeding 500m<sup>2</sup>.

## 5.0 Protection of Openings

It is assumed that the O'Brien Building is within a common allotment. Hence, the fire features will be the external wall of the adjoining building. Refer to Section 4.0 above for required protection.

## 6.0 Access and Egress

### Patient Care Area

Travel distance to a point of choice of alternative exits must not exceed 12m and the distance to the nearer of the two exits must not exceed 30m. The distance between exits measured through the point of choice must not exceed 45m. Horizontal Exits will be utilised to ensure the travel distance will comply with the DTS requirements. The clear width of the Horizontal Exit will be 1250mm.

### Non-Patient Care & Office

Travel distance to a point of choice of alternative exits must not exceed 20m and the distance to the nearer of the two exits must not exceed 40m. The distance between exits measured through the point of choice must not exceed 60m. Horizontal Exits will be utilised to ensure the travel distance will comply with the DTS requirements.

### Other Requirements:

All exit swing doors, including the Horizontal Exits will swing in the direction of egress.

The balustrades will comply with D2.16 of BCA.

Access for people with disabilities will be provided to the whole of Ground floor and to those floors that are served by lifts. The circulation space at the doorway will comply with AS1428.1. The clear door width will not be less than 800mm and the door latch will be located between 900mm and 1100mm above the finished floor level. The lift will be fitted with facilities required for use by people with disabilities.

Tactile surface indicators will be provided at the top and bottom of public stairs.

Accessible toilets complying with AS 1428.1 will also be provided in accordance with F2.3 of BCA.

As the Patient Care area on Level 5 does not have direct egress to a road or open space, at least two passenger lifts will be emergency lifts. The dimension of the emergency lift must be measured clear of obstructions and must be of the followings:

Depth of car – 2200mm

Width of car – 1600mm

Floor to ceiling height – 2300mm

Door height – 2100mm

Door width – 1300mm, and

The emergency lifts will be connected to a standby power supply system where installed.

## 7.0 Fire Services and Equipment

The following essential fire safety measures will be installed (where necessary) throughout the building:

DESIGN / INSTALLATION STANDARD			
Item	Measure	BCA Clause	Relevant Australian Standard
1.	Automatic Fire Sprinkler Systems	BCA Clause, E1.5 & BCA Spec. E1.5.	AS 2116.1- 1999
2.	Building Occupant Warning System activated by the Sprinkler System.	BCA Spec. E1.5.8 Spec E2.2a Clause 6	Clause 3.27 of AS 1670.1 – 2004
3.	Emergency Lifts	BCA Clause E3.4	AS 1736.2-2001, AS 1735.11-1996 & AS 1735.12-1999 (Amnd 1, July 1999)
4.	Emergency Lighting	BCA Clause E4.4	AS/NZS 2203.1 – 2005

DESIGN / INSTALLATION STANDARD			
Item	Measure	BCA Clause	Relevant Australian Standard
5.	EWIS	BCA Clause B4.9	AS 1070.4-2004 & AS 4428.4-2004
6.	Exit Signs	BCA Clauses E4.3, E4.5 & E4.8	AS/NZS 2293.1 - 2005
7.	Fire Dampers	BCA Clause C3.15	AS 1688.1 - 1998 & AS 1682.1 & 2 - 1995
8.	Fire doors	C2.7, C3.8, C2.12, D1.11	As1905.1 - 2005
9.	Fire Hose Reels	BCA Clause E1.4	AS 2441 - 2005
10.	Fire Hydrant Systems	BCA Clause E1.3	AS 2419.1 - 2005
11.	Fire Seals	BCA Clause C3.18	AS 1530.4 - 1997 & AS 4072.1 - 1992
12.	Lightweight Construction	BCA Clause C1.8	AS 1530.4 - 2005, ASTM E72-80, ASTM E695-70 - 1985 & AS 2185 - 1991
13.	Mechanical Air Handling Systems	BCA Clause E2.2	AS/NZS 1688.1 - 1998 & AS 1688.2 - 1991
14.	Portable Fire Extinguishers	BCA Clause E1.5	AS 2444 - 2001
15.	Pressurising Systems <sup>1</sup>	BCA Clauses C1.7, E2.2 & Spec E2.2a	AS/NZS 1688.1-1998 (Amdt 1, Nov 2002)
16.	Smoke Dampers	BCA Clause E2.2	AS/NZS 1688.1-1998 (Amdt 1, Nov 2002)
17.	Smoke Doors	BCA Clause C2.5 & Spec C3.4	
18.	Smoke Hazard Management Systems <sup>2</sup>	BCA Part E2	AS 2118.1 - 1999
19.	Wall-Wetting Sprinklers	BCA Clause C3.4	AS 2118.2 - 1998
20.	Warning & Operational signs	BCA Clause D2.25, Clause 189 of EPAR2000	

## 8.0 Sanitary Facilities

Adequate sanitary facilities will be provided in the building in accordance with F2.3 of BCA. At least one toilet accessible to people with disabilities will be provided and this will be located in an area which is accessible to the occupants of the building.

## 9.0 Room Sizes

The ceiling height to all habitable spaces will not be less than 2.4m.

## 10.0 Energy Efficiency

The building and its services will be designed to comply with National Section J and the applicable NSW Section J.

<sup>1</sup> Automatic air pressurisation is the isolated stairs required in a Class 9a building with a rise in storage of more than 2. Also required in basement fire stairs as they are more than 2 below ground levels.

<sup>2</sup> Automatic sprinklers is one option of satisfying the smoke hazard management.


## 11.0 Conclusion

We have assessed the building design to date and have reviewed the scheme with respect to the Building Code of Australia. The design is at a point where the inherent BCA philosophies have been checked and development consent can be sought. The finer details with respect to BCA2008 can be finalised prior to the issue of a Construction Certificate / building permit.

## Appendix A

**Table 3 TYPE A CONSTRUCTION: FRL OF BUILDING ELEMENTS**

Building element	Class of building-FRL: (in minutes)			
	Structural adequacy/integrity/insulation			
	2, 3 or 4 part	5, 7a or 8	6	7b or 8
<b>EXTERNAL WALL</b> (including any column and other building element incorporated therein) or other external building element, where the distance from any fire-source feature to which it is exposed is-				
For loadbearing parts				
Less than 1.5m	90/90/90	120/120/120	180/180/180	240/240/240
1.5 to less than 3m	90/90/90	120/90/90	180/180/120	240/240/180
3m or more	90/90/90	120/90/90	180/120/90	240/180/90
For non-loadbearing parts				
Less than 1.5m	-/90/90	-/120/120	-/180/180	-/240/240
1.5 to less than 3m	-/90/90	-/90/90	-/180/120	-/240/180
3m or more	-/-	-/-	-/-	-/-
<b>EXTERNAL COLUMN</b> not incorporated in an external wall, where the distance from any fire-source feature to which it is exposed is-				
Less than 3m	90/-	120/-	180/-	240/-
3m or more	-/-	-/-	-/-	-/-
<b>COMMON WALLS and FIRE WALLS-</b>				
	90/90/90	120/120/120	180/180/180	240/240/240
<b>INTERNAL WALLS</b>				
Fire-resisting lift and stair shafts-				
Loadbearing	90/90/90	120/120/120	180/120/120	240/120/120
Non-loadbearing	-/90/90	-/120/120	-/120/120	-/120/120
Bounding public corridors, public lobbies and the like-				
Loadbearing	90/90/90	120/-	180/-	240/-
Non-loadbearing	-/90/90	-/-	-/-	-/-
Between or bounding sole-occupancy units-				
Loadbearing	90/90/90	120/-	180/-	240/-
Non-loadbearing	-/90/90	-/-	-/-	-/-
Ventilating, pipe, garbage, and like shafts not used for the discharge of hot products of combustion				
Loadbearing	90/90/90	120/90/90	180/120/120	240/120/120
Non-loadbearing	-/90/90	-/90/90	-/120/120	-/120/120
<b>OTHER LOADBEARING INTERNAL WALLS, INTERNAL BEAMS, TRUSSES and COLUMNS-</b>				
Floors	90/90/90	120/120/120	180/180/180	240/240/240
Roofs	90/90/90	120/90/90	180/90/90	240/90/90

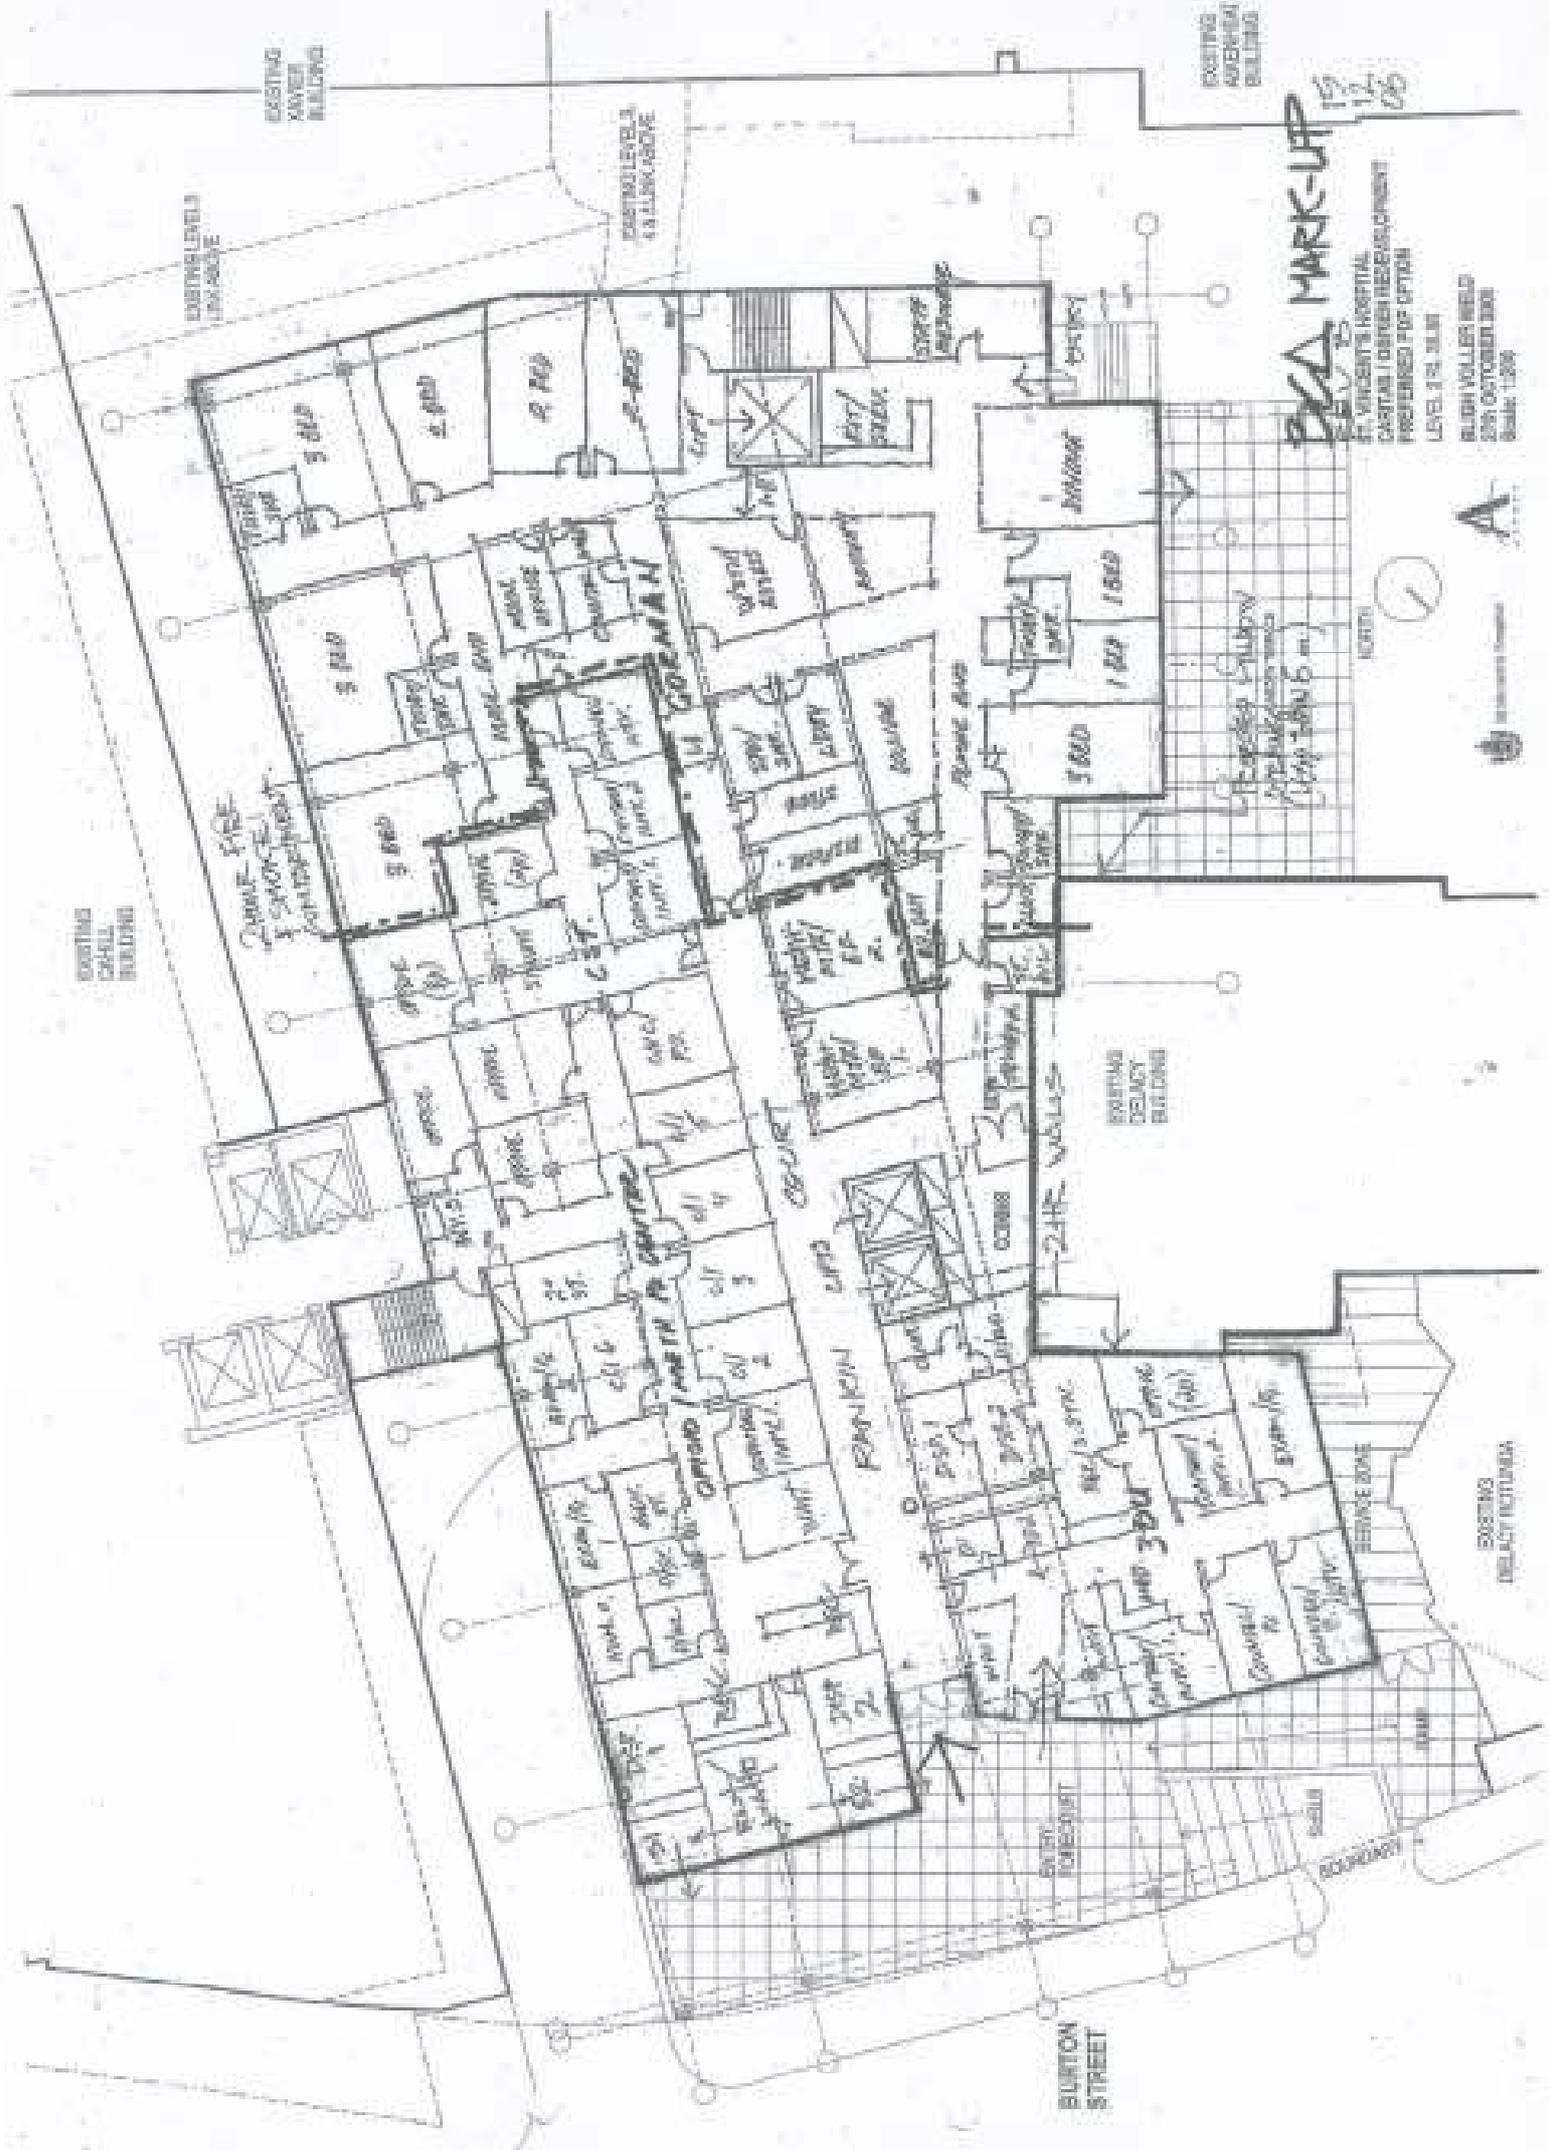

15  
12  
05  
**PDA MARK-UP**  
ST. VINCENT'S HOSPITAL  
CAPITAL / DRIVER REDEVELOPMENT  
PREFERRED PDF OPTION  
LEVEL 1 (10' BELOW)  
BLIGH VOLLER WELD  
20th OCTOBER 2004  
Scale: 1:200





EXISTING  
OWNER  
BUILDING

EXISTING  
KANSAS  
BUILDING

**BA MARK-UP**  
27  
11  
06

ST. VINCENT'S HOSPITAL  
CAPITAL / OPERATIVE REBUILD  
PREPARED FOR OPTION

LEVEL 3 PL. AREA  
BLUSH VALLEY HILLS  
270, OCTOBER 2005  
Scale: 1/8" = 1'-0"



**A**

EXISTING  
DENTAL  
BUILDING

EXISTING LEVEL  
LINK ABOVE

EXISTING LEVEL  
LINK

CAIT  
LABORATORY

Horizontal  
System  
from  
delay

EXISTING  
DEBRIS  
BUILDING  
ZONOR  
FIRE  
COMPARTMENT  
WALL

FUTURE CANAL  
LINK

RESEARCH

LABORATORY  
PREPARATION



**BCA MARK-UP**  
 REV. 10/11/08  
 ST. VINCENT'S HOSPITAL  
 GARDEN / GREEN REDEVELOPMENT  
 PROPOSED POP OPTION  
 LEVEL 4 PL. 44-18  
 OLIVER COLLIER HILL  
 27th OCTOBER 2008  
 Scale 1:200






**BCA MARK-UP**  
 ST VINCENT'S HOSPITAL  
 CARDIAC / CORONARY DEVELOPMENT  
 PREPARED FOR OPTION

LEVEL 5 R.L. 45.14  
 BLOH VOLLER HOLD  
 23A OCTOBER 2008  
 Scale: 1:50

NORTH  
 1  
 A  
 10/10/08

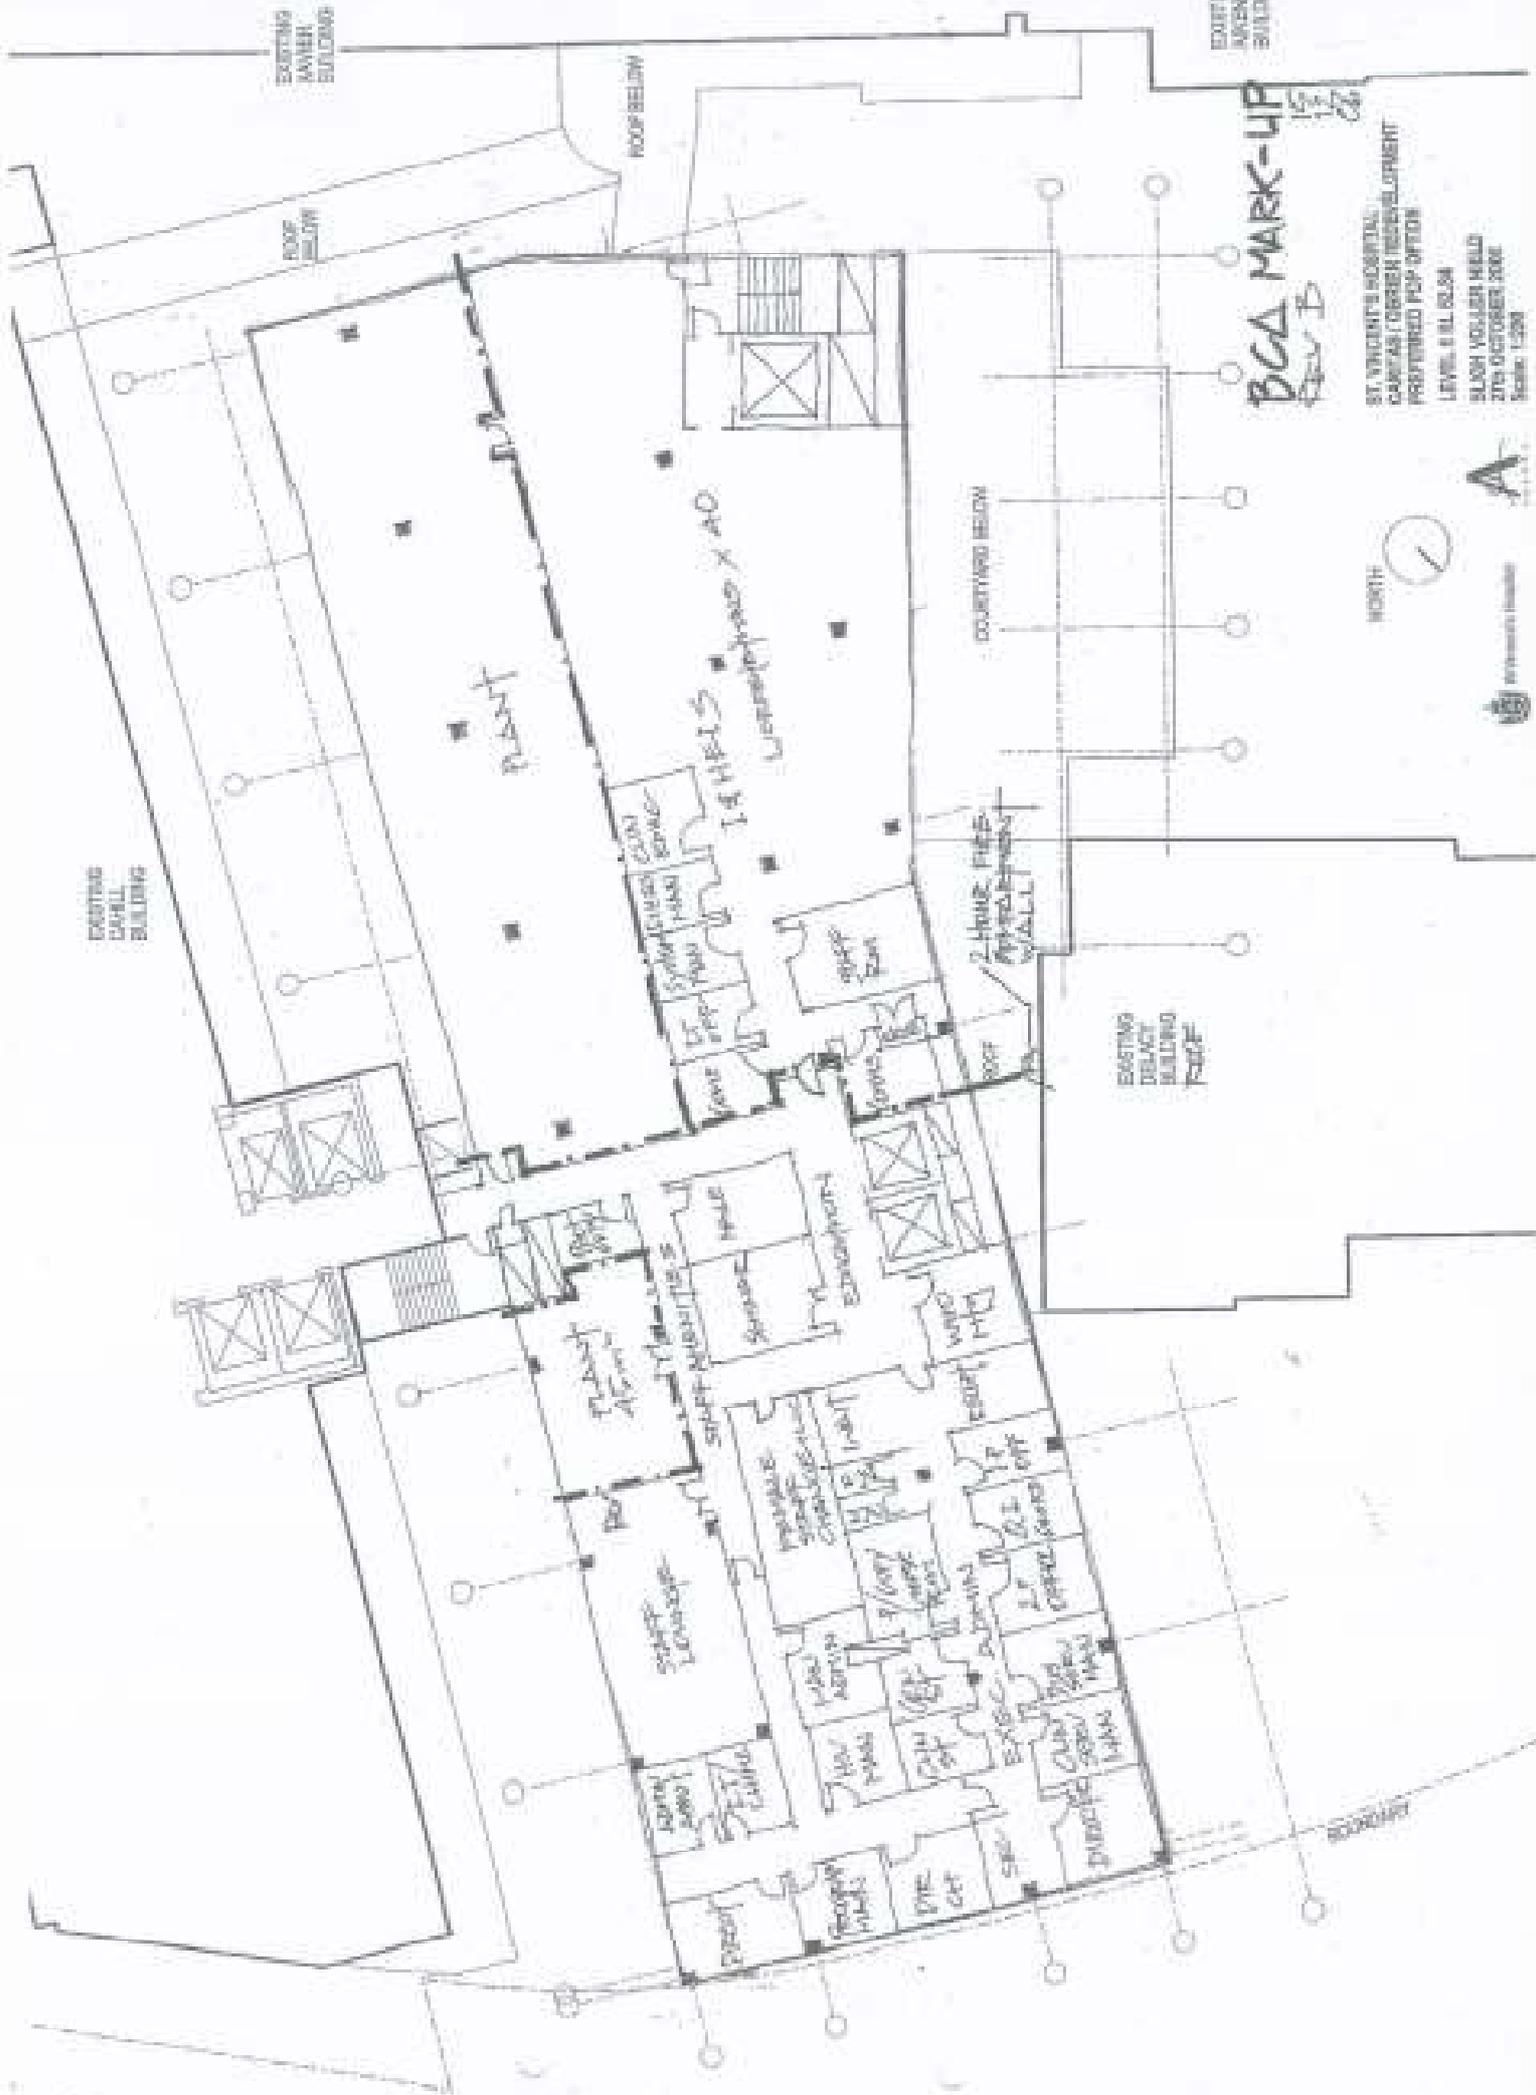

**BGA MARK-UP**  
 Rev B

ST VINCENT'S HOSPITAL  
 GARDENS (GARDEN REDEVELOPMENT)  
 PROPOSED POP-OFFS  
 LEVEL: 0.1 L. 02.04  
 SLASH VOLUME FIELD  
 27th OCTOBER 2006  
 Scale: 1:500



Architect's mark: **A**

EXISTING CANAL BUILDING

EXISTING JACUZZI BUILDING

EXISTING JACUZZI BUILDING

EXISTING DELAUX BUILDING

ROOFBELOW

ROOF BELOW

COURTYARD BELOW

BOUNDARY

Plant

1.4 HVELS  
 1.4 HVELS

2 HOUR FIRE  
 Applied to  
 WALL

STAFF PLUNGE  
 SHOWER  
 TOILET

STAFF RESTROOMS  
 SHOWER  
 TOILET

STAFF LOUNGE  
 SHOWER  
 TOILET

STAFF OFFICE  
 SHOWER  
 TOILET


RECEPTION  
 SHOWER  
 TOILET

ADMIN  
 SHOWER  
 TOILET

CLINICAL  
 SHOWER  
 TOILET

RECEPTION  
 SHOWER  
 TOILET

CLASSROOM  
 SHOWER  
 TOILET

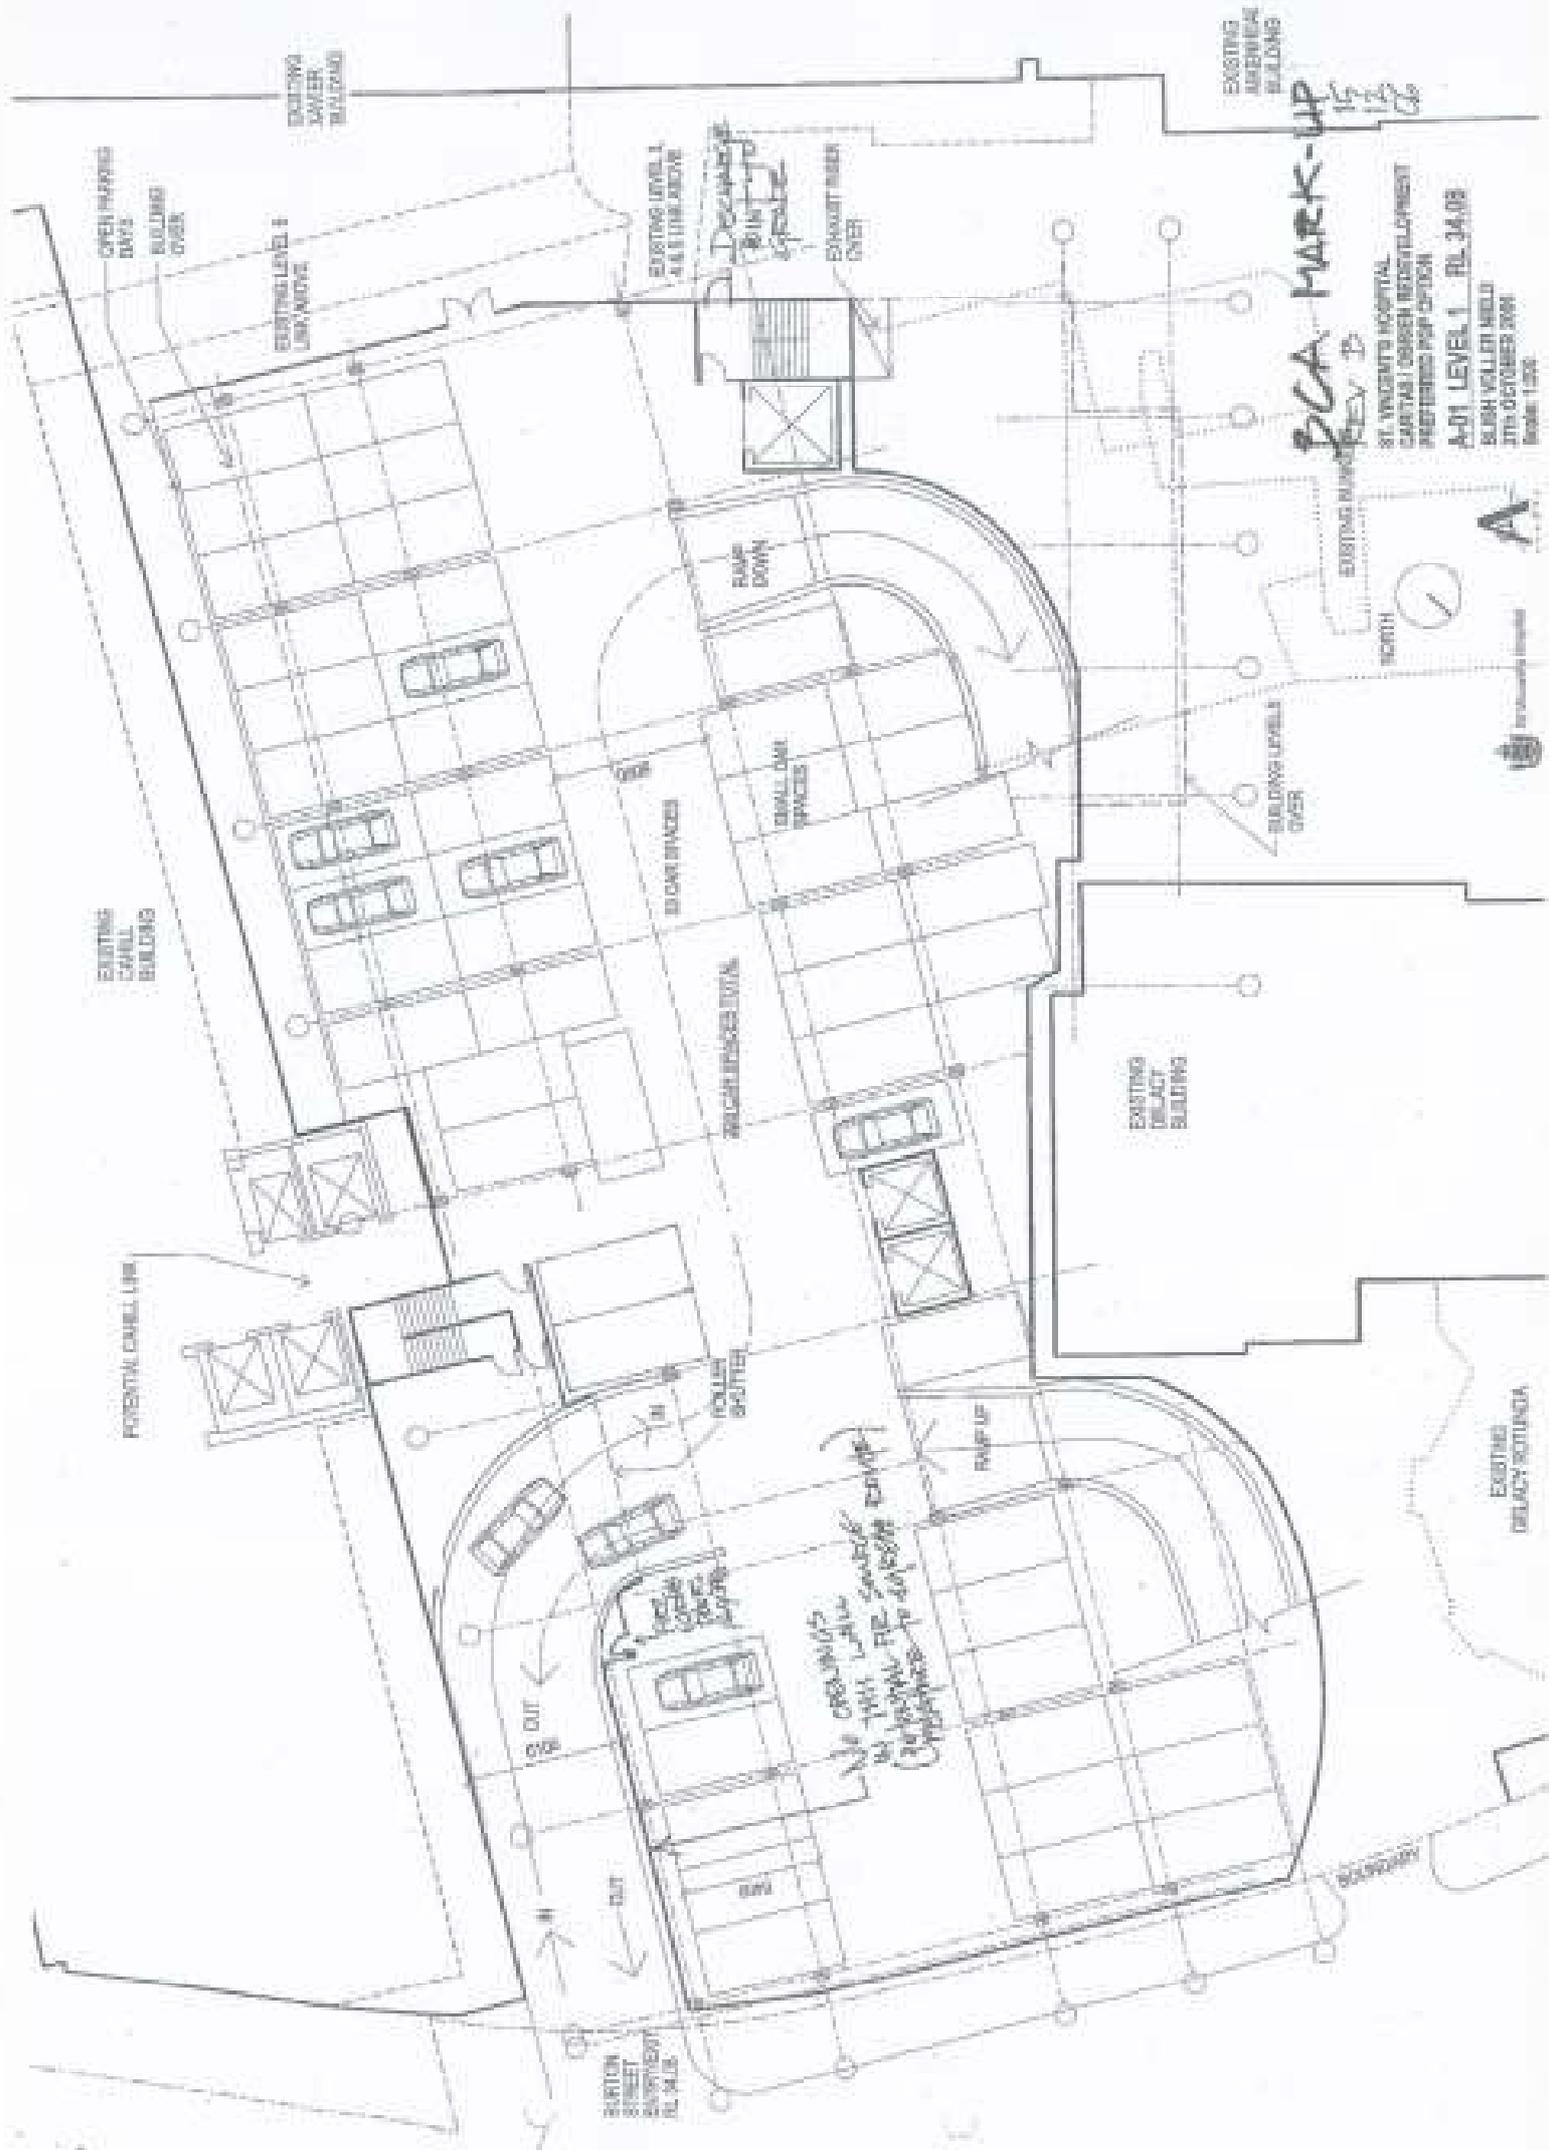

**PCA MARK-UP**  
 15  
 13  
 Co

ST. VINCENT'S HOSPITAL  
 CAPITAL CONSTRUCTION REDEVELOPMENT  
 PROPOSED P&I SECTION  
 A-01 LEVEL 1 - RL 34.08  
 SLUSH VALLEY HILL  
 31st OCTOBER 2001  
 SCALE 1:500

**A**



BURTON STREET  
 BURTON STREET  
 RL 34.15

EXISTING DELAYCOTTING