



Issued under the Environmental Planning and Assessment Act 1979


Approved Section 75W Modification Application

No. 2 granted on the 5-5-2015

in respect to MP.10-0116....

Signed: 

Sheet No. 1

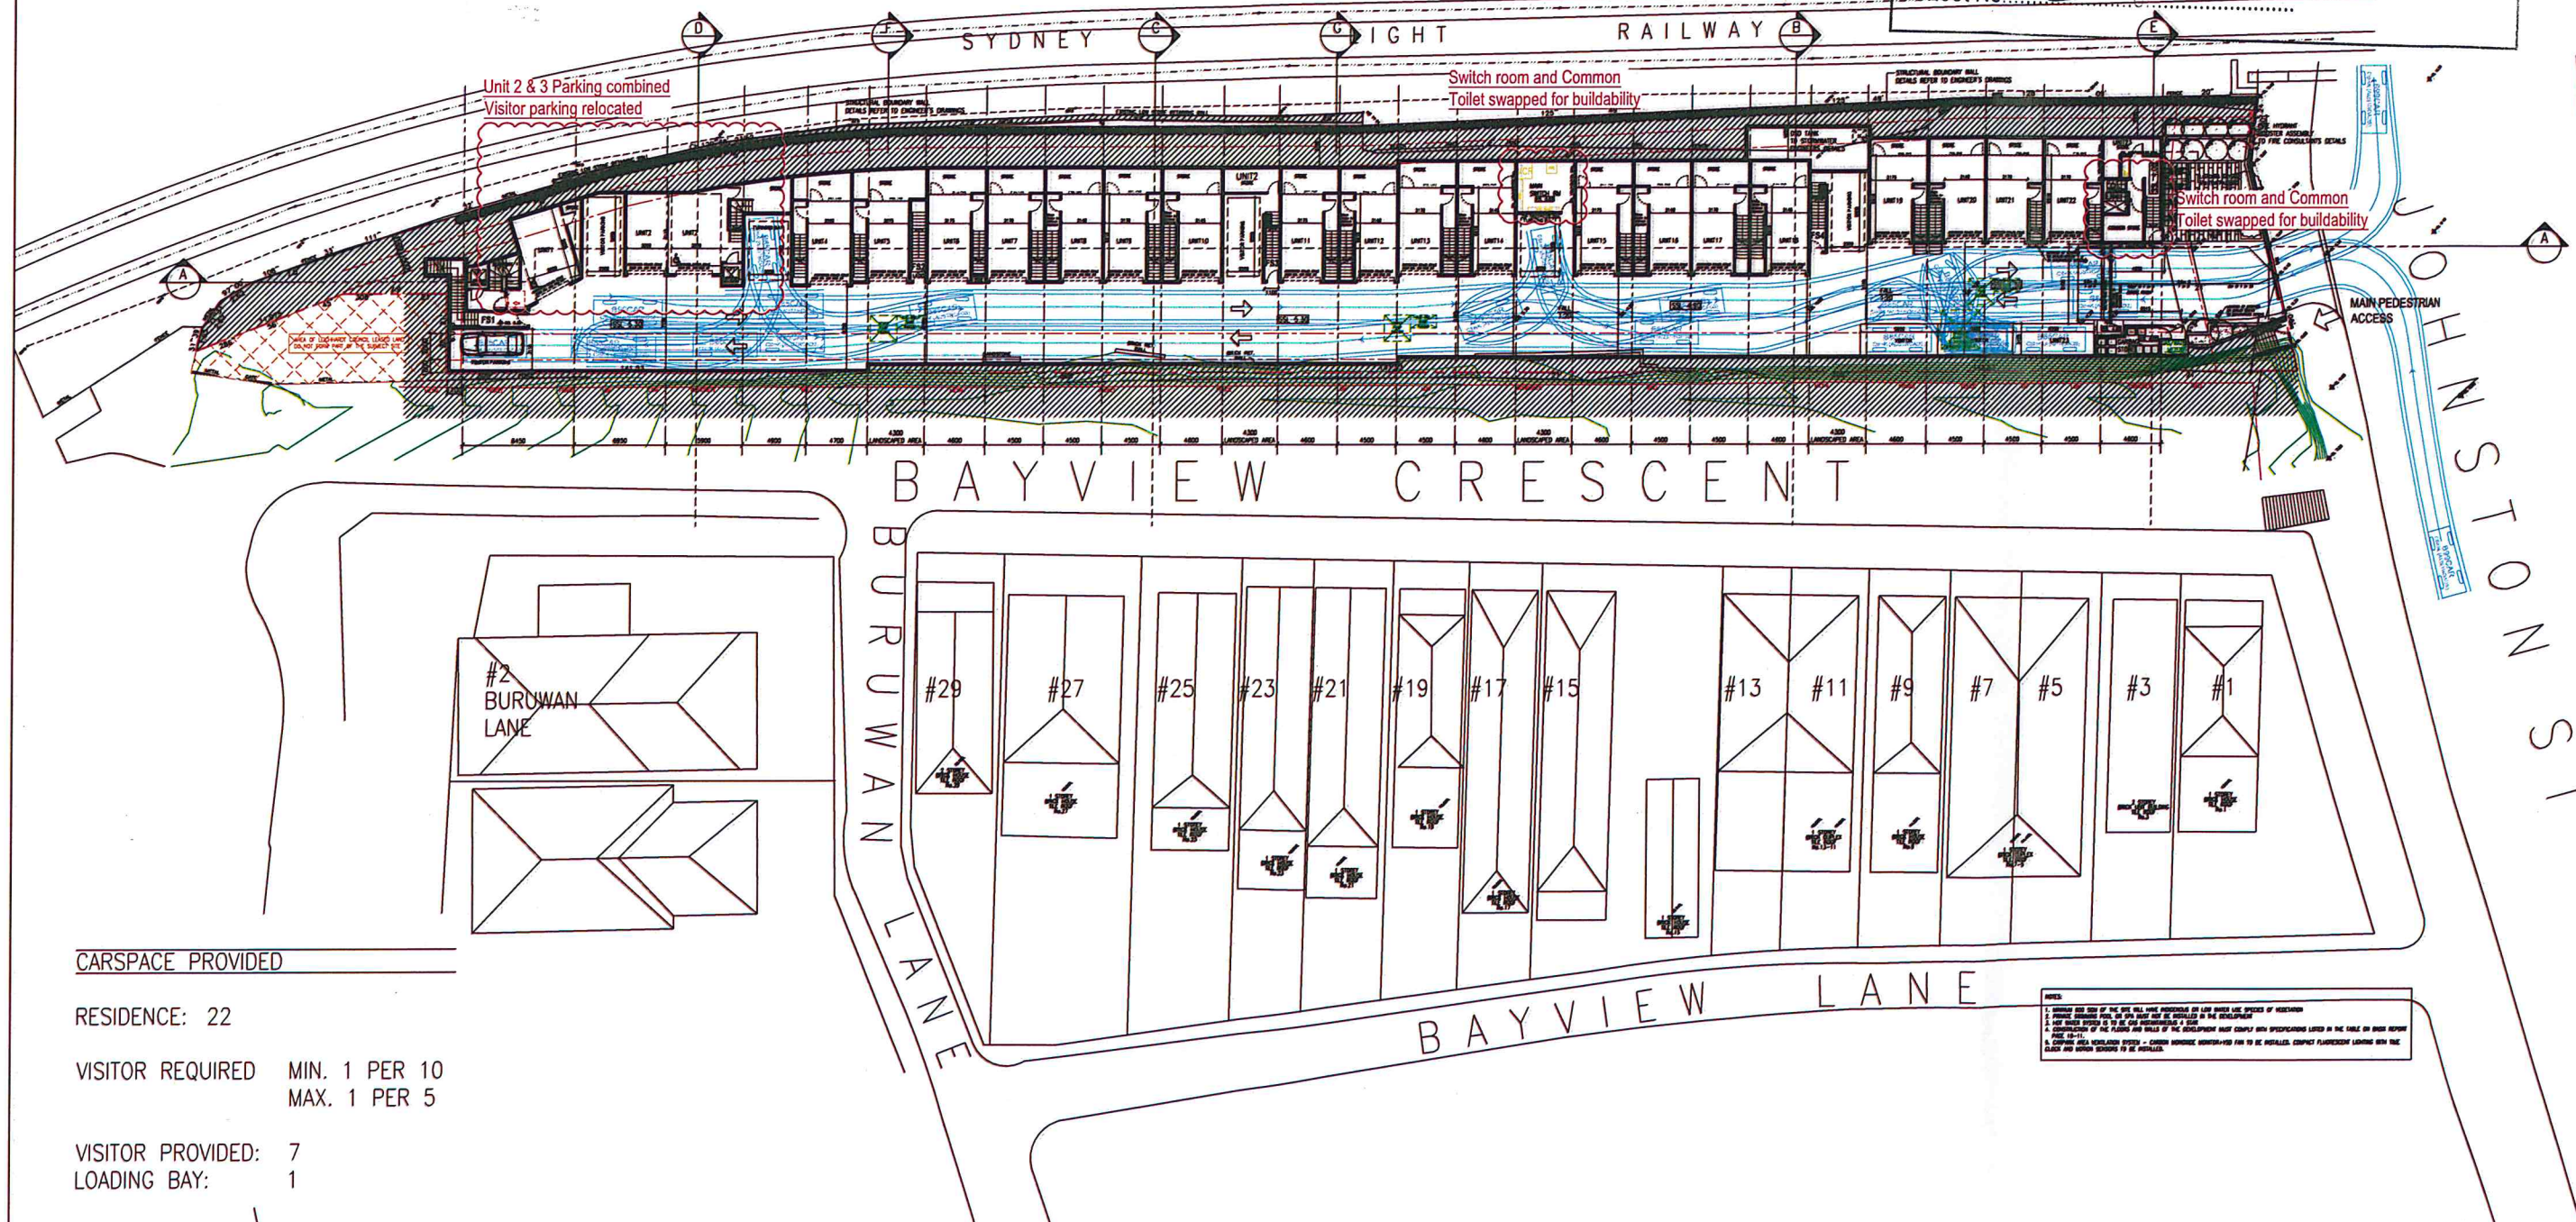

CARSPACE PROVIDED

RESIDENCE: 22

VISITOR REQUIRED MIN. 1 PER 10
MAX. 1 PER 5

VISITOR PROVIDED: 7
LOADING BAY: 1

[illegible]



Issued under the Environmental Planning and Assessment Act 1979


~~Approved Section 75W Modification Application~~

No. 2 granted on the 5-5-2015

in respect to MP.10-0116....

Signed 

Sheet No. 2 of 10

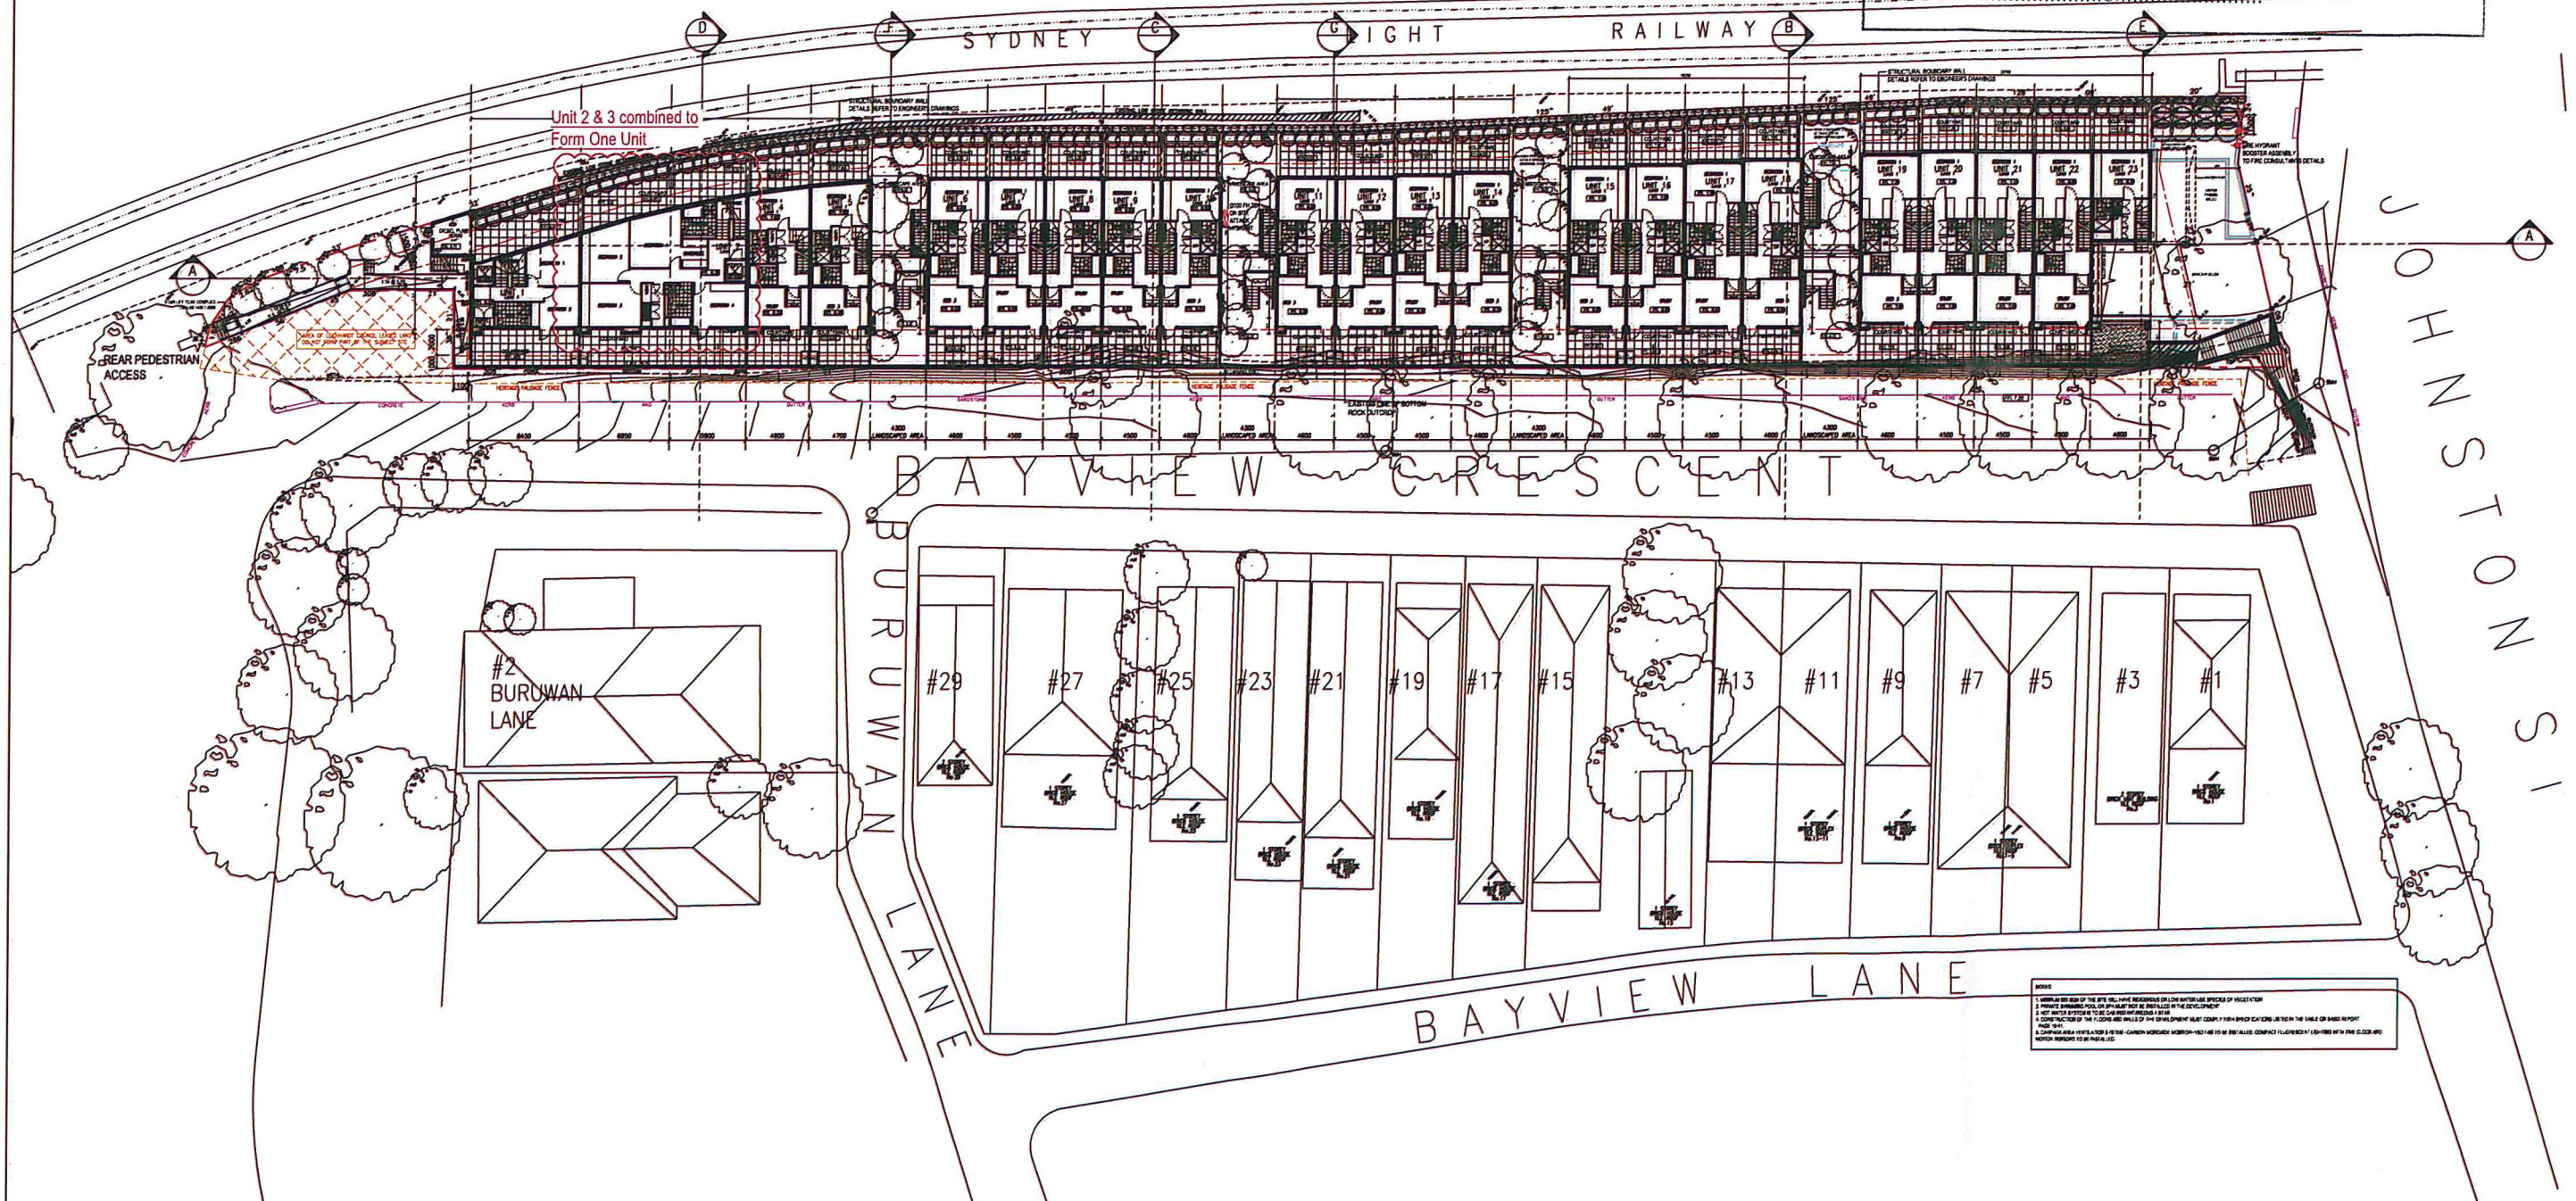

Rev	Description	By	Date	Classifier	Notes	Important Notes:	Consultants	Client	Architects	Project	Key plan	Scale 1:200 @ A1	Date
A	CONCEPT PLAN SUBMISSION FOR PART 3A OF THE ENVIRONMENTAL PLANNING AND ASSESSMENT ACT	WT	06/APR/11		"THESE DRAWINGS ARE PRELIMINARY DRAWINGS AND ARE SUBJECT TO REVISION. THE CLIENT AGREES TO ACCEPT THE PRELIMINARY DRAWINGS MADE TO A SMALLER SCALE AND FOR MORE GENERAL PURPOSES."	1. Consultant should design with caution following: a. AS 1546:2005 b. AS 1546:2005 c. AS 1546:2005 d. AS 1546:2005 e. AS 1546:2005 f. AS 1546:2005 g. AS 1546:2005 h. AS 1546:2005 i. AS 1546:2005 j. AS 1546:2005 k. AS 1546:2005 l. AS 1546:2005 m. AS 1546:2005 n. AS 1546:2005 o. AS 1546:2005 p. AS 1546:2005 q. AS 1546:2005 r. AS 1546:2005 s. AS 1546:2005 t. AS 1546:2005 u. AS 1546:2005 v. AS 1546:2005 w. AS 1546:2005 x. AS 1546:2005 y. AS 1546:2005 z. AS 1546:2005 aa. AS 1546:2005 ab. AS 1546:2005 ac. AS 1546:2005 ad. AS 1546:2005 ae. AS 1546:2005 af. AS 1546:2005 ag. AS 1546:2005 ah. AS 1546:2005 ai. AS 1546:2005 aj. AS 1546:2005 ak. AS 1546:2005 al. AS 1546:2005 am. AS 1546:2005 an. AS 1546:2005 ao. AS 1546:2005 ap. AS 1546:2005 aq. AS 1546:2005 ar. AS 1546:2005 as. AS 1546:2005 at. AS 1546:2005 au. AS 1546:2005 av. AS 1546:2005 aw. AS 1546:2005 ax. AS 1546:2005 ay. AS 1546:2005 az. AS 1546:2005 ba. AS 1546:2005 bb. AS 1546:2005 bc. AS 1546:2005 bd. AS 1546:2005 be. AS 1546:2005 bf. AS 1546:2005 bg. AS 1546:2005 bh. AS 1546:2005 bi. AS 1546:2005 Issued under the Environmental Planning and Assessment Act 1979


~~Approved Section 75W Modification Application~~


No. 2 granted on the 5-5-2015

in respect to MP...10-0116.....

Signed.....

Sheet No. 3 of 10

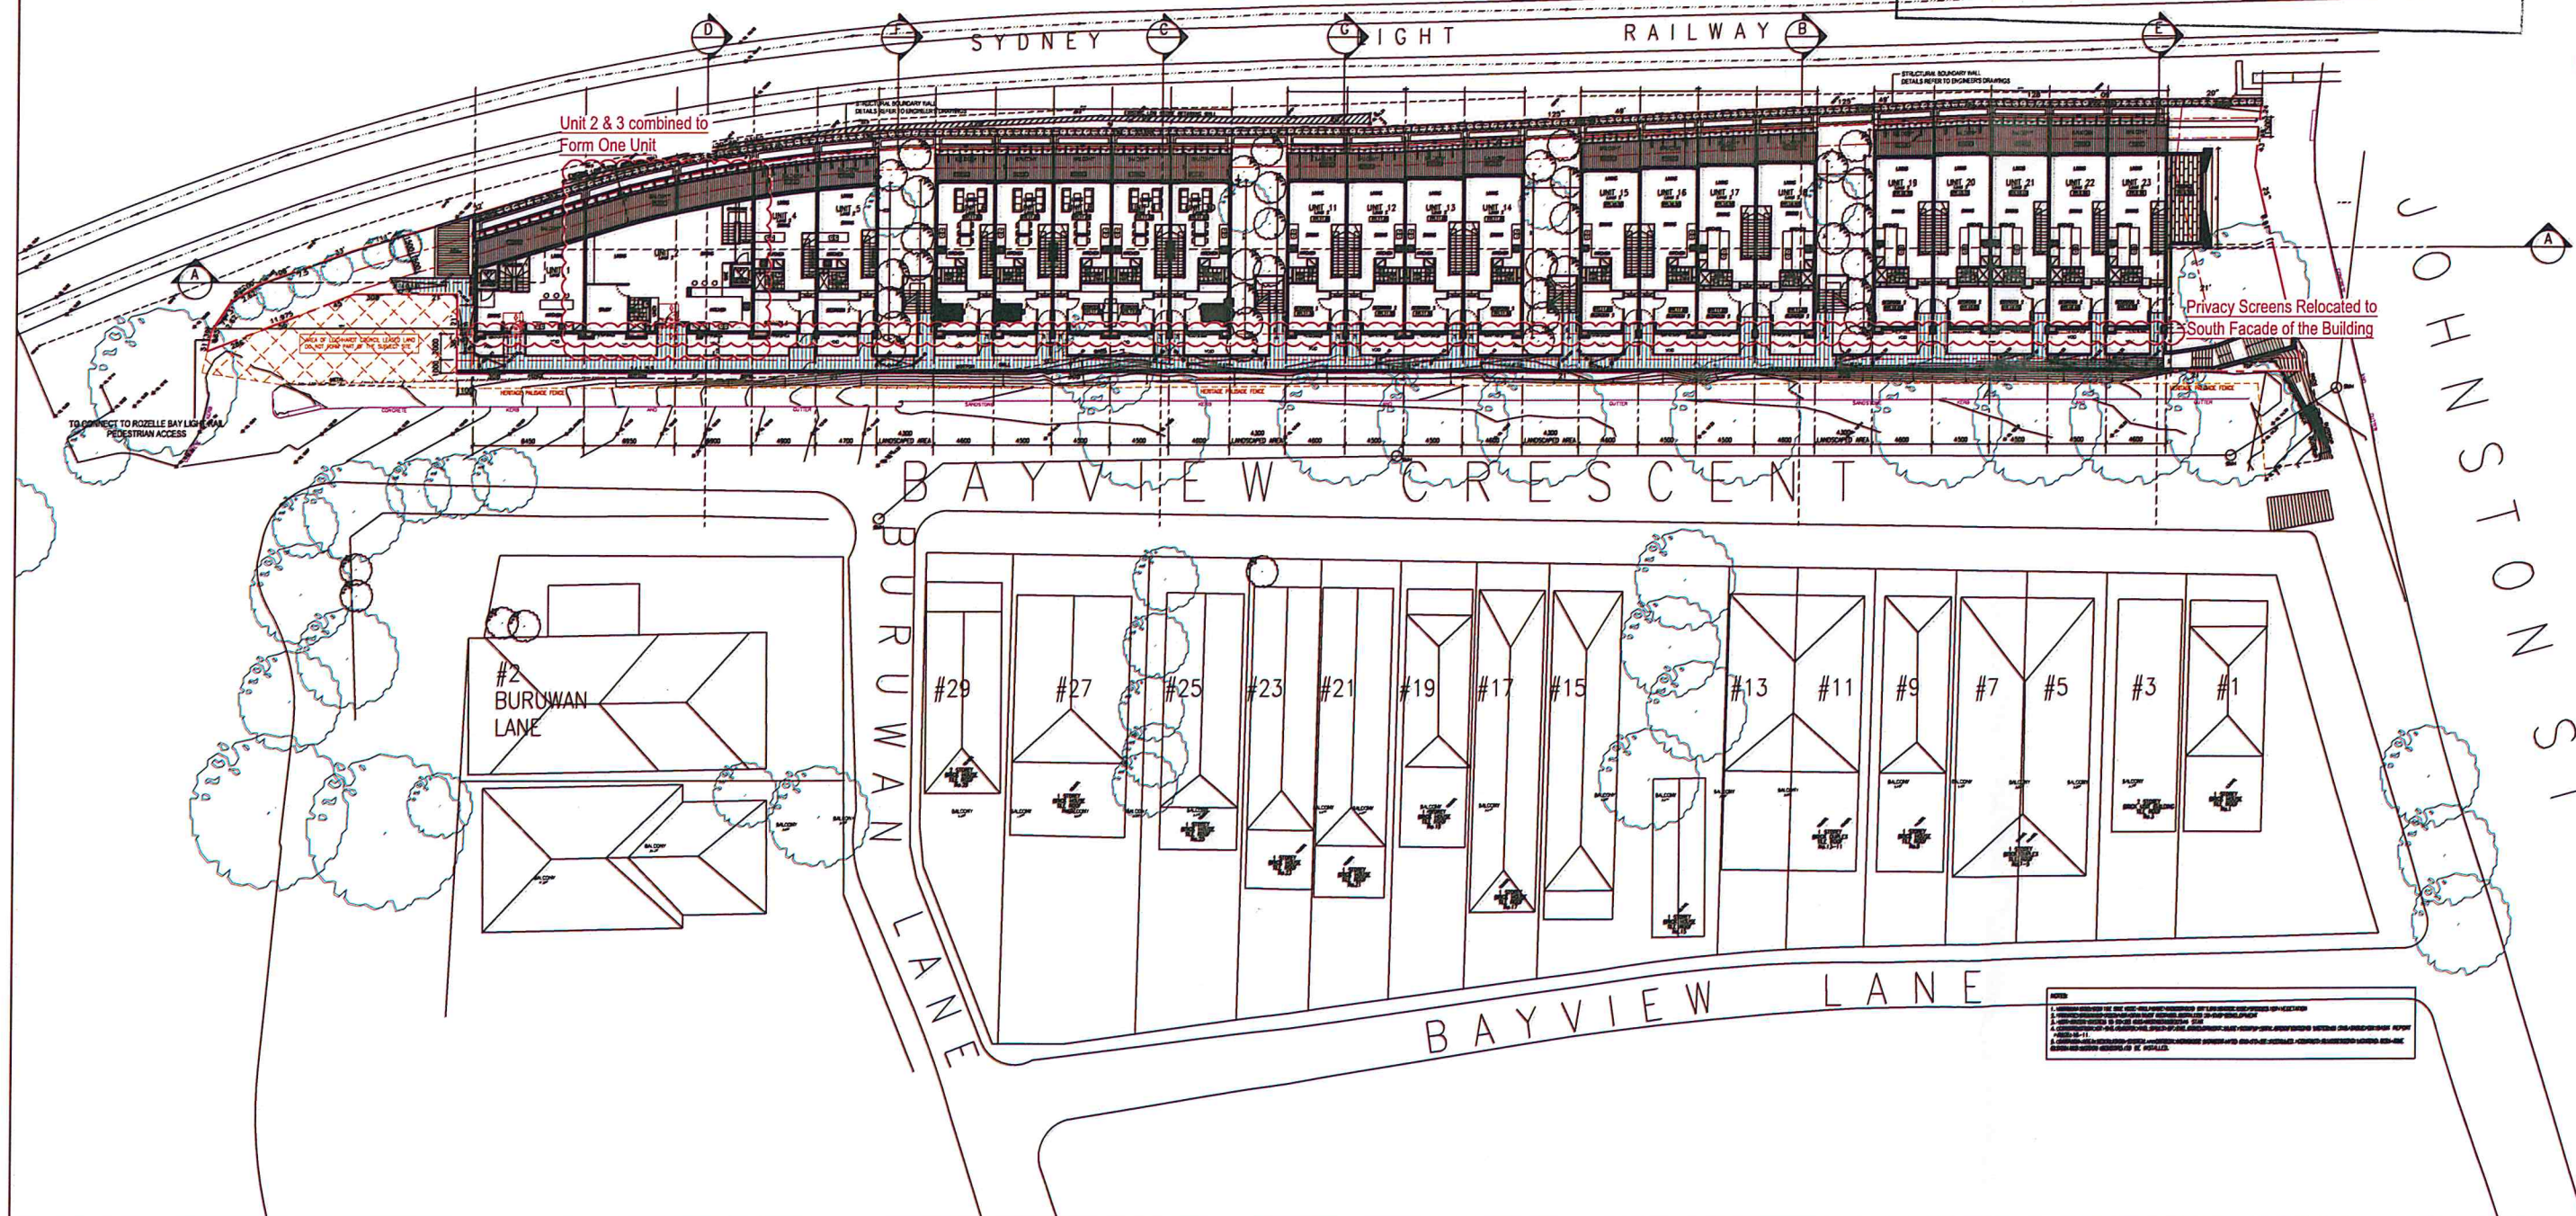[illegible]

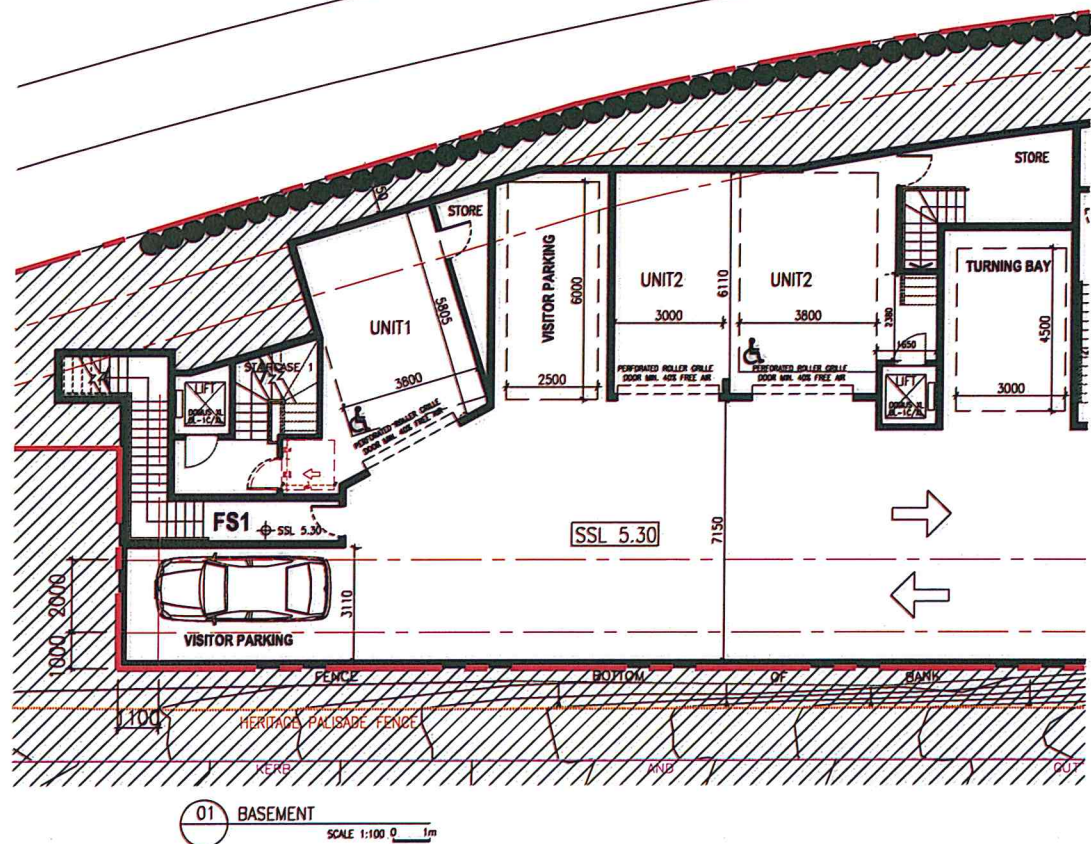

NSW GOVERNMENT
Planning

Issued under the Environmental Planning and Assessment Act 1979

Approved Section 75W Modification Application





No. 2 granted on the 5.5.2015

in respect to MP 10-0116

Signed [Signature]

Rev.	Description	By	Date
A	CONCEPT PLAN SUBMISSION FOR PART 3A OF THE ENVIRONMENTAL PLANNING AND ASSESSMENT ACT	WT	28.03.2012
B	FOR INFORMATION	WT	15.05.2012
B2	FOR RE-SUBMISSION	WT	03.12.2014
C	SECTION 98		

Important Notes:
1. Applicant must lodge all relevant documents with the Council.
2. Documents must be submitted to the Council in triplicate.
3. Documents must be submitted to the Council in triplicate.
4. Documents must be submitted to the Council in triplicate.

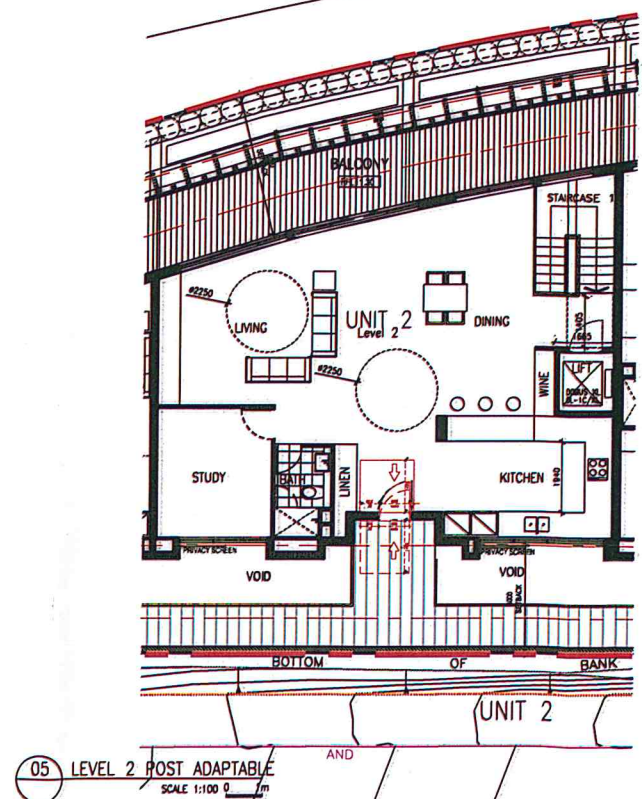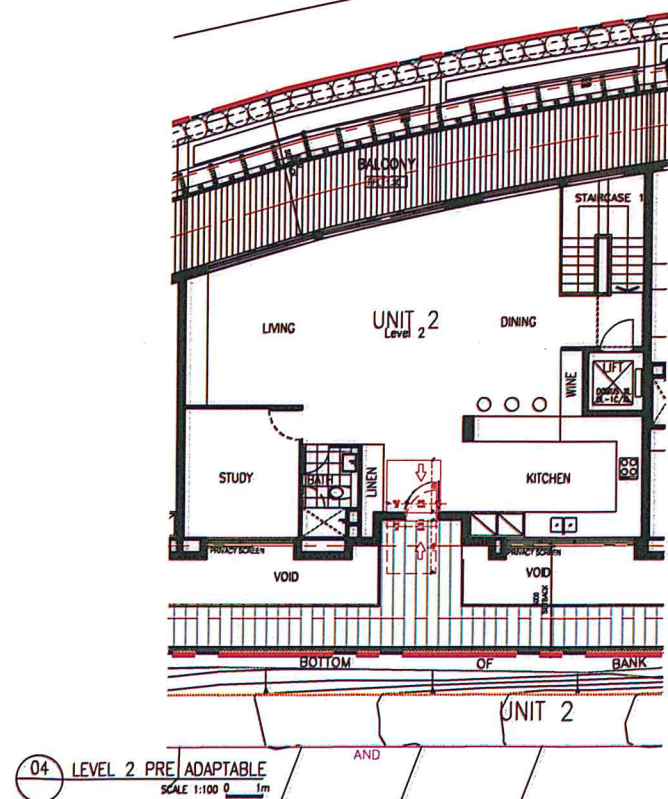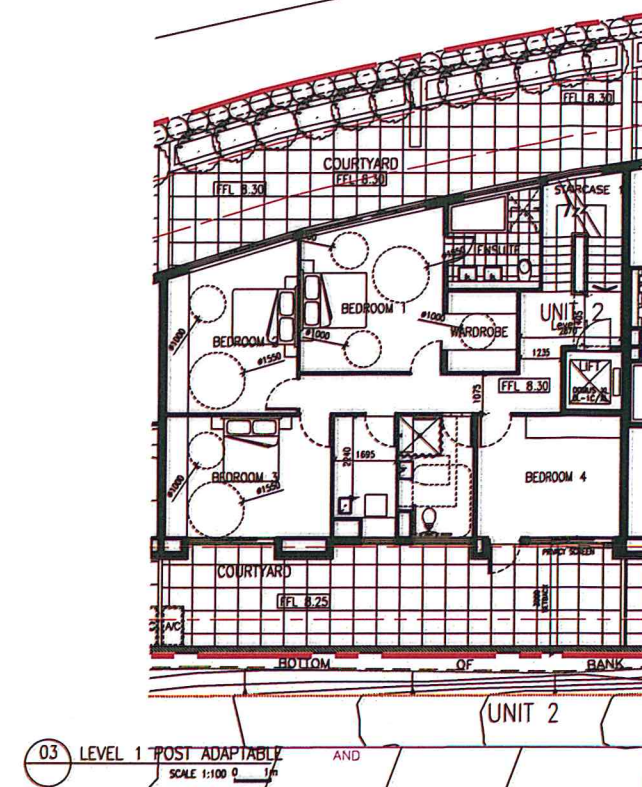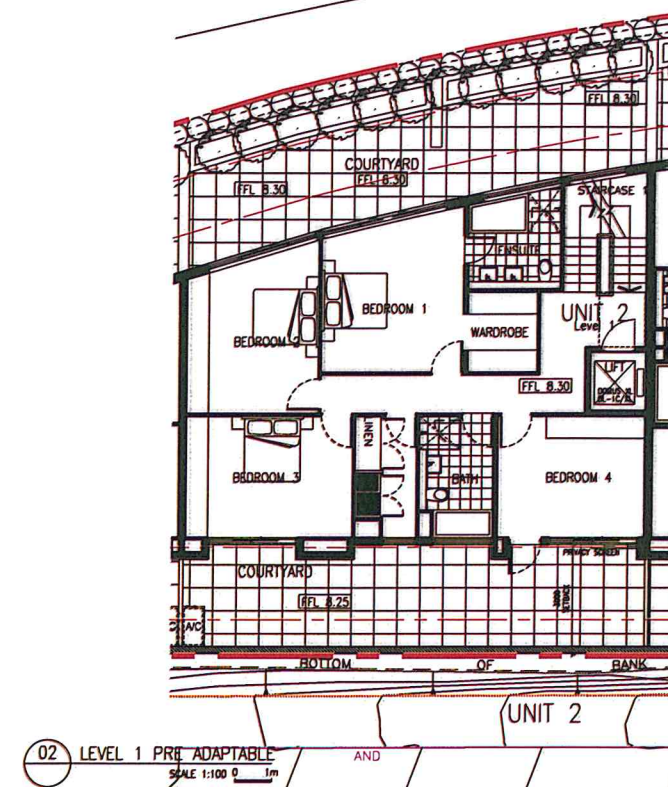

Consultants	Client	Architects	Project	Key plan	Scale	Dist
CONSULTANTS - CIVIL & STRUCTURAL 1. CIVIL & STRUCTURAL 2. CIVIL & STRUCTURAL 3. CIVIL & STRUCTURAL 4. CIVIL & STRUCTURAL 5. CIVIL & STRUCTURAL 6. CIVIL & STRUCTURAL 7. CIVIL & STRUCTURAL 8. CIVIL & STRUCTURAL 9. CIVIL & STRUCTURAL 10. CIVIL & STRUCTURAL	NEIL FREELAND Gosford Quarries 300 Johnston Street Annandale, NSW - 2038	tony owen pears	Gosford Quarries Project address 300 JOHNSTON STREET ANNANDALE, NSW, 2038	Key plan Scale Dist	Scale Dist	Dist

Issued under the Environmental Planning and Assessment Act 1979





Approved Section 75W Modification Application

No. 2 granted on the 5-5-2015

MP10-0116

SALE

Sheet No. 5 of 10

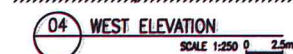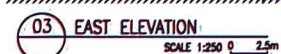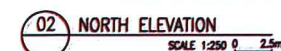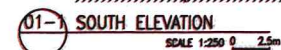

EXTERNAL FINISHES LEGEND

- 01 SANDSTONE CLADDING - GOSFORD QUARRIES MT WHITE - WHITE OR SIMILAR
- 02 SANDSTONE CLADDING - GOSFORD QUARRIES MT WHITE - BROWN OR SIMILAR
- 03 SANDSTONE CLADDING - DARK GREY BROWN OR SIMILAR
- 04 SANDSTONE CLADDING - DARK BROWN OR SIMILAR
- 05 BRONZE CLADDING - CENTAURI - LIGHT BROWN BRONZE CLEAR MATT OR SIMILAR
- 06 BRONZE CLADDING - CENTAURI - DARK BROWN BRONZE CLEAR MATT OR SIMILAR
- 07 LASER CUT VERTICAL BRONZE LOUVRE TYPE B - CENTAURI - LIGHT BROWN BRONZE CLEAR MATT OR SIMILAR
- 08 LASER CUT VERTICAL BRONZE LOUVRE TYPE B - CENTAURI - DARK BROWN BRONZE CLEAR MATT OR SIMILAR
- 09 TIMBER FINISH ENTRY DOOR
- 10 FIXED LOUVRES - TIMBER BROWN OR SIMILAR
- 11 GLASS LOUVRE WINDOWS
- 12 RENDER AND PAINT FINISH - DULUX USA WHITE OR SIMILAR
- 13 RENDER AND PAINT FINISH - DULUX BROWN OR SIMILAR
- 14 FIXED ALUMINIUM WINDOWS - DULUX BROWN OR SIMILAR
- 15 GLASS BALLSTRADE WITH HANDRAILS
- 16 ~~GLASS SLIDE WITH TIMBER FEATURE SLIDE~~
- 17 VERTICALLY CURVED STEEL FRAMES
- 18 OPERABLE LOUVRES SILVER OR SIMILAR
- 19 SLIDING DOORS - ANODISED ALUMINIUM PAINT FINISH
- 20 IRON PALISADE FENCE - SILVER OR SIMILAR
- 21 GARAGE DOOR - SILVER METAL FINISH OR SIMILAR
- 22 GATE - SILVER METAL FINISH OR SIMILAR
- 23 LASER CUT VERTICAL BRONZE LOUVRE TYPE A
- 24 ALUMINIUM FRAMED AWNING WINDOWS

[illegible]

- (01) SANDSTONE CLADDING - GOSFORD QUARRIES MT WHITE - WHITE OR SIMILAR
- (02) SANDSTONE CLADDING - GOSFORD QUARRIES MT WHITE - BROWN OR SIMILAR
- (03) SANDSTONE CLADDING - DARK GREY BROWN OR SIMILAR
- (04) SANDSTONE CLADDING - DARK BROWN OR SIMILAR
- (05) BRONZE CLADDING - CENTAURI - LIGHT BROWN BRONZE CLEAR MATT OR SIMILAR
- (06) BRONZE CLADDING - CENTAURI - DARK BROWN BRONZE CLEAR MATT OR SIMILAR
- (07) LASER CUT VERTICAL BRONZE LOUVER TYPE 8 - CENTAURI - LIGHT BROWN BRONZE CLEAR MATT OR SIMILAR
- (08) LASER CUT VERTICAL BRONZE LOUVER TYPE 8 - CENTAURI - DARK BROWN BRONZE CLEAR MATT OR SIMILAR
- (09) TIMBER FINISH ENTRY DOOR
- (10) FIXED LOUVRES - TIMBER BROWN OR SIMILAR
- (11) GLASS LOUVER WINDOWS
- (12) RENDER AND PAINT FINISH - DULUX USA WHITE OR SIMILAR
- (13) RENDER AND PAINT FINISH - DULUX BROWN OR SIMILAR
- (14) FIXED ALUMINIUM WINDOWS - DULUX BROWN OR SIMILAR
- (15) GLASS BALUSTRADE WITH HANDRAILS
- (16) GLASS BLADE WITH TIMBER FEATURE SLIDE
- (17) VERTICALLY CURVED STEEL FRAMES
- (18) OPERABLE LOUVRES SILVER OR SIMILAR
- (19) SLIDING DOORS - ANODISED ALUMINIUM PAINT FINISH
- (20) IRON PALISADE FENCE - SILVER OR SIMILAR
- (21) GARAGE DOOR - SILVER METAL FINISH OR SIMILAR
- (22) GATE - SILVER METAL FINISH OR SIMILAR
- (23) LASER CUT VERTICAL BRONZE LOUVER TYPE A
- (24) ALUMINIUM FRAMED AWNING WINDOWS


 EXTEND OF TYPICAL FRITTED FROSTED PATTERN GLASS
 FROSTED GLASS
 CLEAR GLASS

WINDOW ABBREVIATION LEGEND:

F.:	FIXED GLAZING - CLEAR GLAZING OR AS SPECIFIED
SL:	SLIDING DOOR / WINDOW
H.W:	HINGED/AWNING WINDOW
	OBSOLETE GLASS

01 SOUTH ELEVATION

APPROX. TOTAL: 151 PRIVACY GLASS SCREEN PANELS

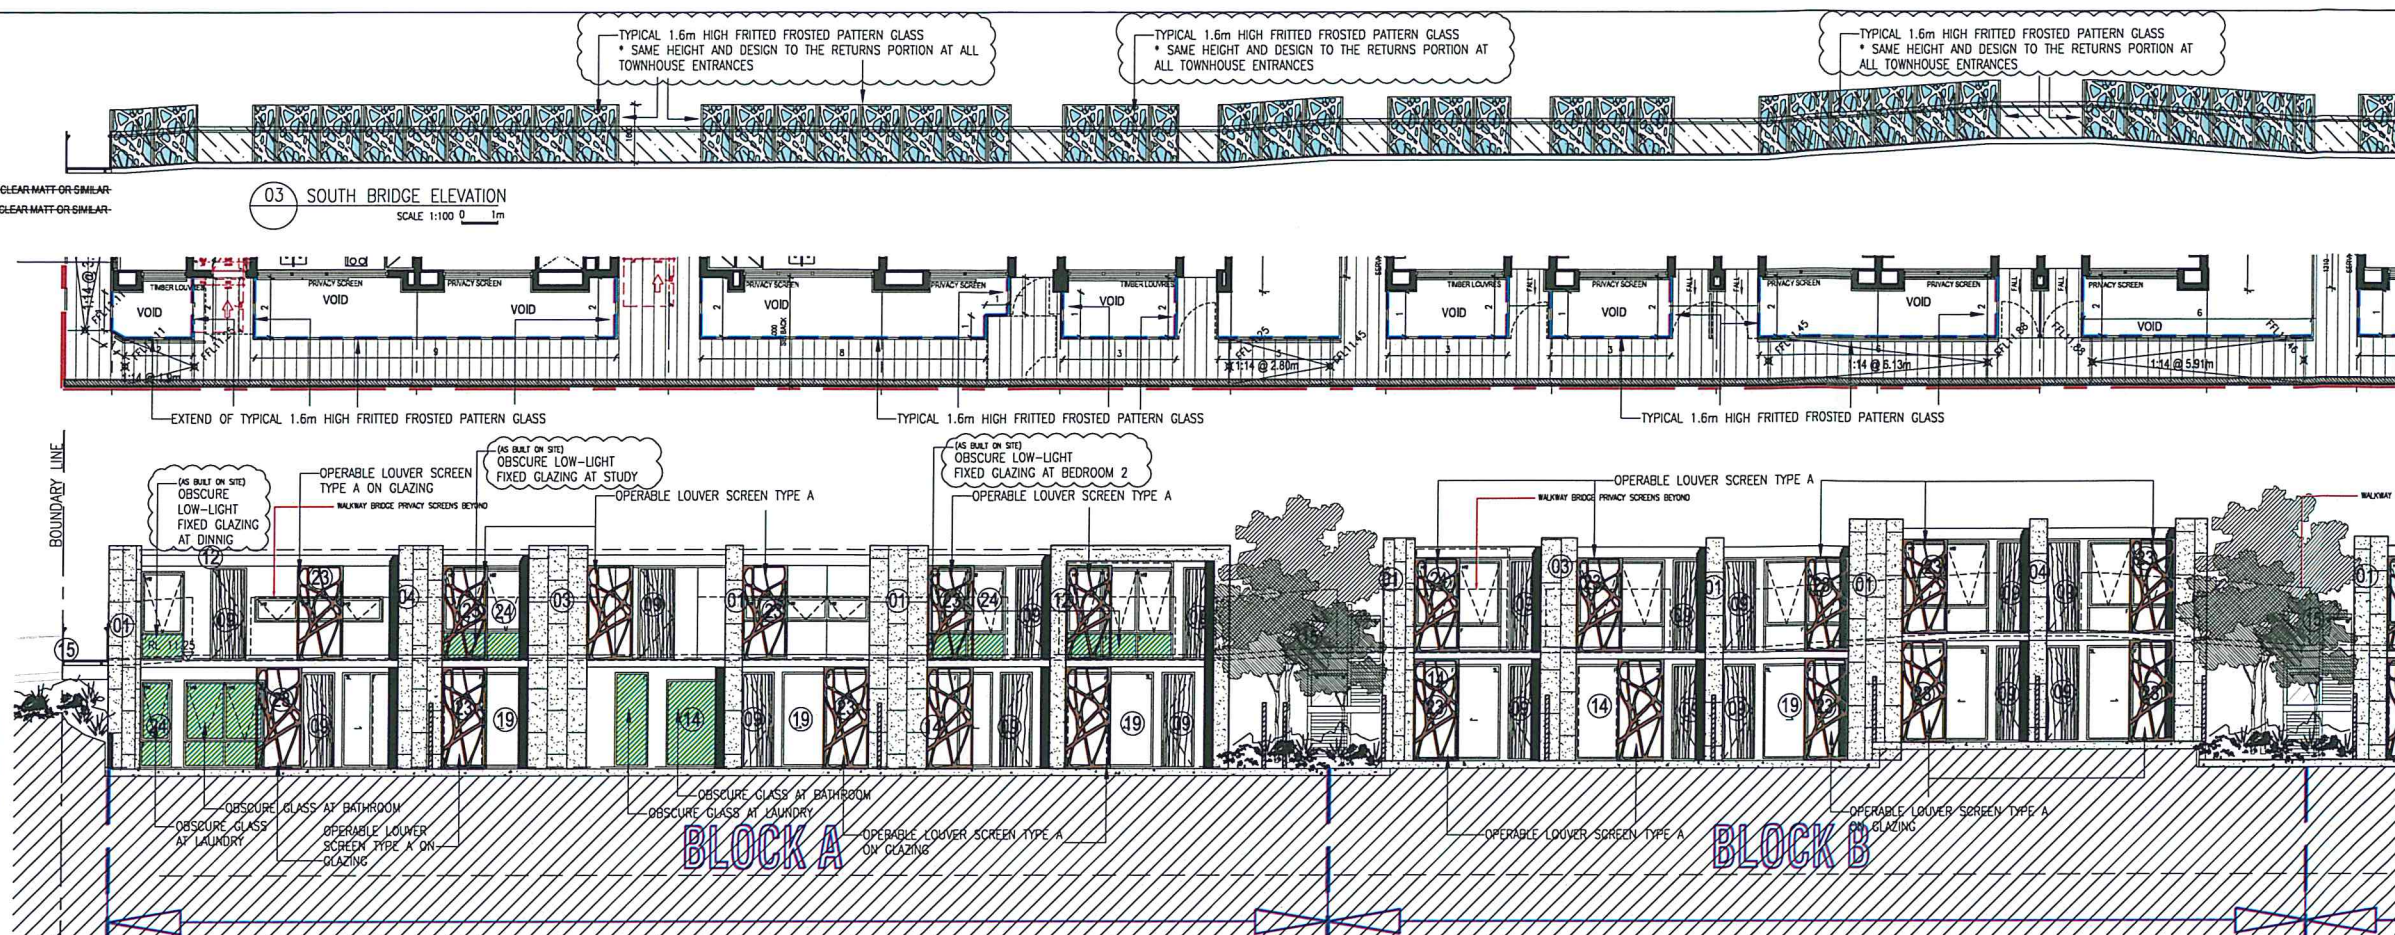

04 SOUTH BRIDGE ELEVATION
SCALE 1:100 0 1m

02 SOUTH ELEVATION

Rev	Description	By	Date	Disclaimer	Notes	Important Notes:	Consultants	Client	Architect	Project	Key plan	Scale	Date
A	SECTION 96 - ADDITIONAL INFORMATION	WT	03.12.2014	THIS DOCUMENT AND ANY WORK HEREIN THAT IS DERIVED FROM THESE DOCUMENTS SHALL BE SUBJECT TO THE COPYRIGHT AND/OR PATENT RIGHTS OF THE CONSULTANTS AND/OR PROVIDERS OF INFORMATION AND SHALL BE THE PROPERTY OF THE CONSULTANTS AND/OR PROVIDERS OF INFORMATION. NO PART OF THIS DOCUMENT OR ANY WORK HEREIN THAT IS DERIVED FROM THESE DOCUMENTS SHALL BE REPRODUCED OR TRANSMITTED IN ANY FORM OR BY ANY MEANS, ELECTRONIC OR MECHANICAL, INCLUDING PHOTOCOPYING, RECORDING, OR BY ANY INFORMATION STORAGE AND RETRIEVAL SYSTEM, WITHOUT THE WRITTEN PERMISSION OF THE CONSULTANTS AND/OR PROVIDERS OF INFORMATION. BEFORE CHANGING ANY WORK HEREIN THAT IS DERIVED FROM THESE DOCUMENTS THAT IS									



Issued under the Environmental Planning and Assessment Act 1979

Approved Section 75W Modification Application


No. 2 granted on the 5-5-2015

in respect to MP. 10-0116


Signed.....

SOLAR PENETRATION TO TOWNHOUSE

JOHNSTON STREET

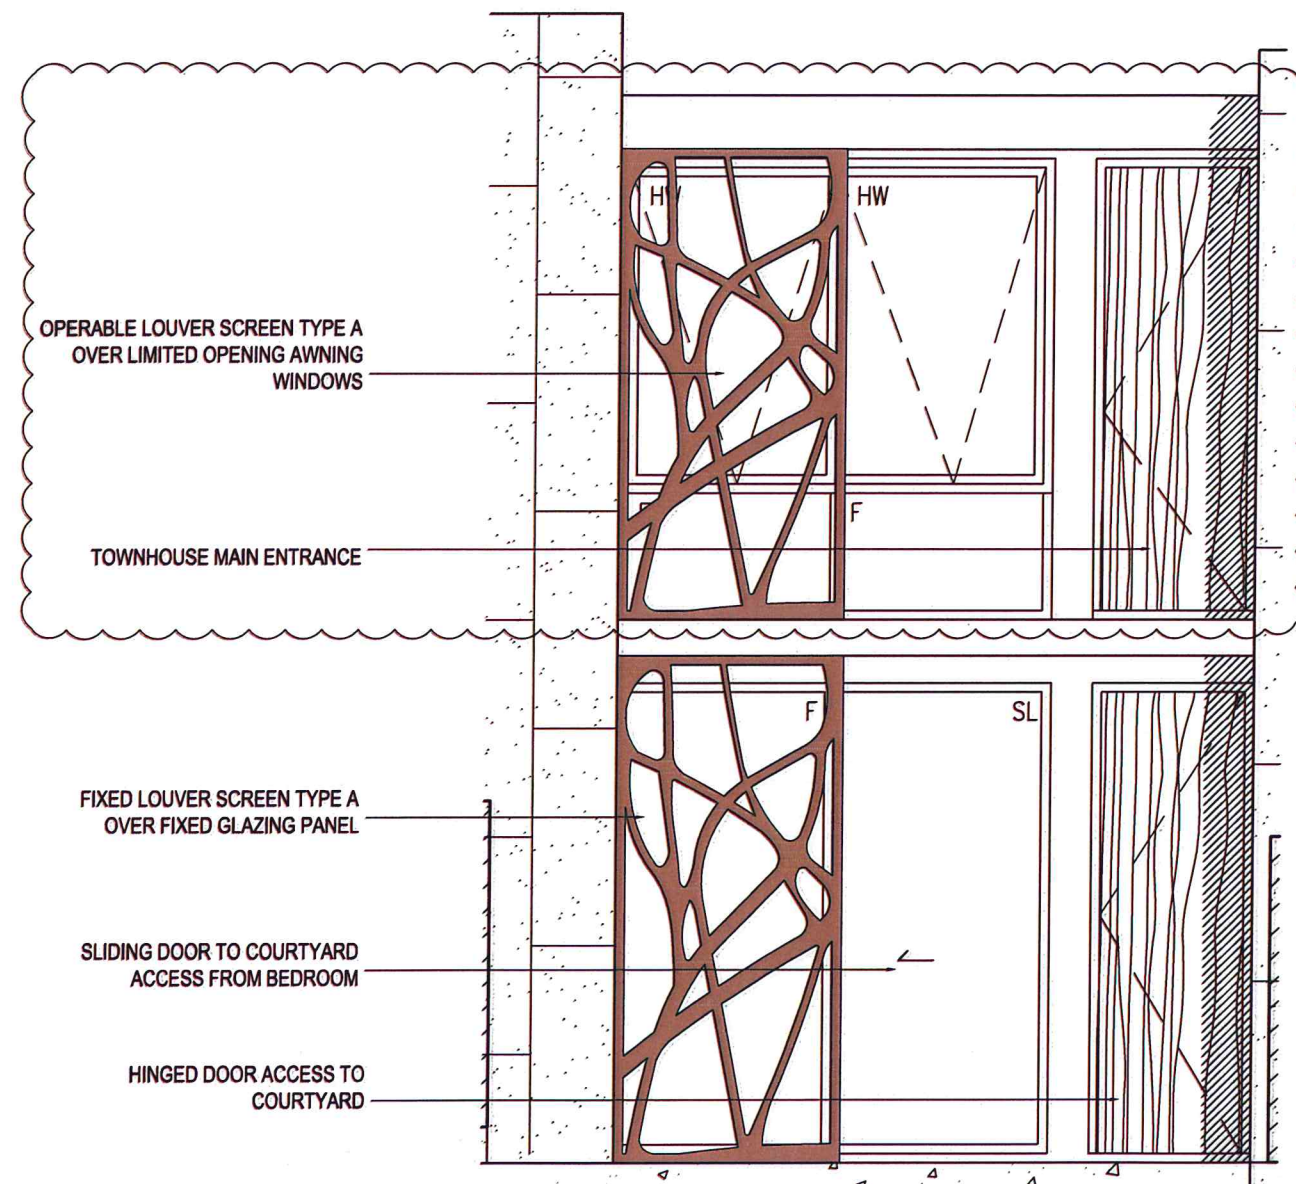

01 TYPICAL SCREEN LOCATION
SOUTH ELEVATION SCALE 1:20 0 1

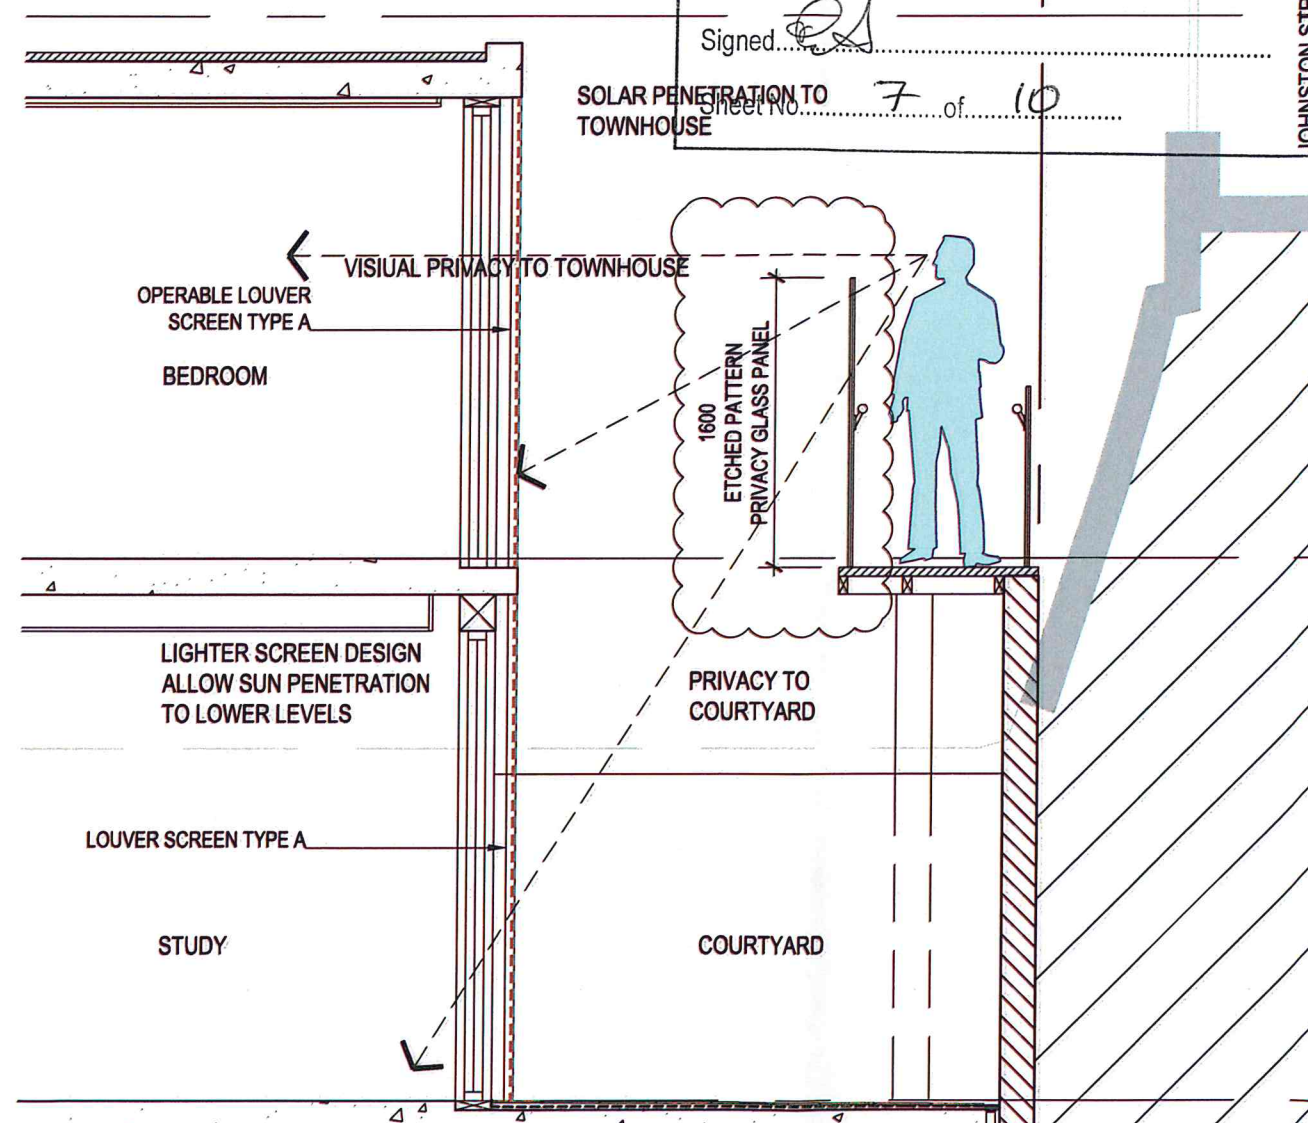

02 TYPICAL SCREEN LOCATION
SECTION SCALE 1:20 0 1




LEGEND :

F.: FIXED GLAZING - CLEAR GLAZING OR AS SPECIFIED

S.L.: SLIDING DOOR / WINDOW

H.W: HINGED/AWNING WINDOW


[illegible]

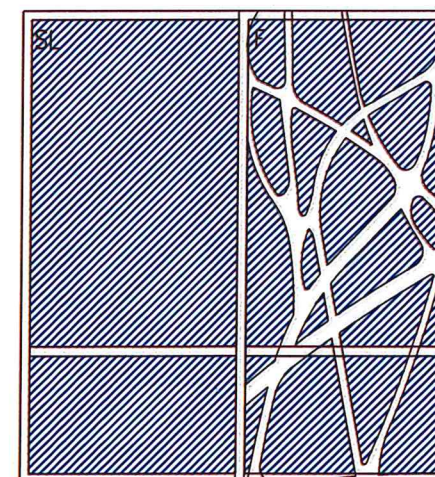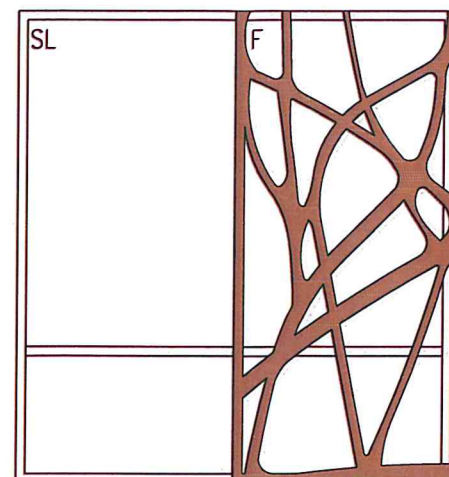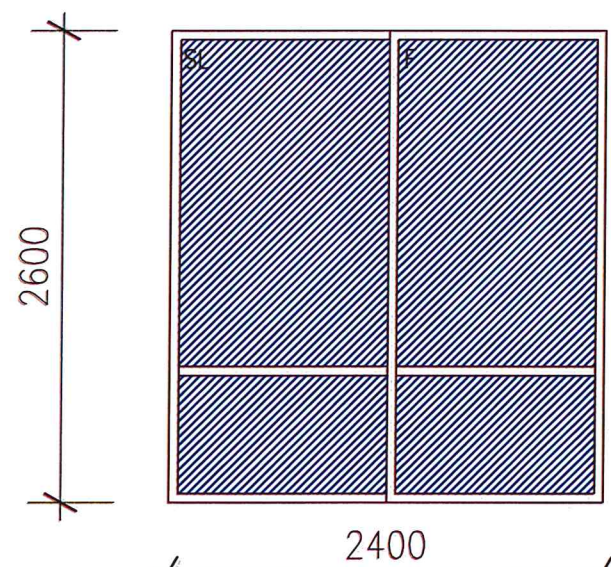

GLAZING AREA
5.6m²
NON-SCREENED
GLAZING AREA
5.0m²
= 90% OPENING
= 10% COVERED

03 PRIVACY SCREEN - SOLAR PENETRATION ANALYSIS
SOUTH ELEVATION SCALE 1:20 0 1

CONTROL:
NORMAL SOUTH FACING GLAZING CONDITIONS FOR OTHER PROJECTS

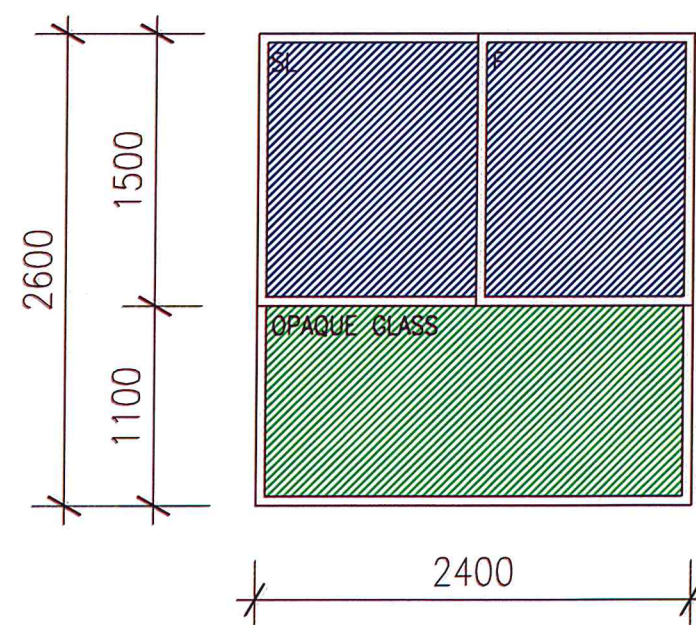

GLAZING AREA
3.2m²
OPAQUE GLASS GLAZING
AREA
2.4m²
TOTAL GLAZING AREA
5.6m²

= 57.15% CLEAR GLASS
= 42.85% OPAQUE GLASS

04 TYPICAL SYDNEY CONDITION
SOUTH ELEVATION SCALE 1:20 0 1

 NSW GOVERNMENT
Planning

Issued under the Environmental Planning and Assessment Act 1979

Approved Section 75W Modification Application

No. 2 granted on the 5-5-2015

in respect to MP. 10-0116

Signed. [Signature]

Sheet No. 8 . of 10

LEGEND :


F.: FIXED GLAZING - CLEAR GLAZING OR AS SPECIFIED

→ S.L.: SLIDING DOOR / WINDOW

H.W: HINGED/AWNING WINDOW

PRIVACY SCREEN SOLAR PENETRATION ANALYSIS

[illegible]

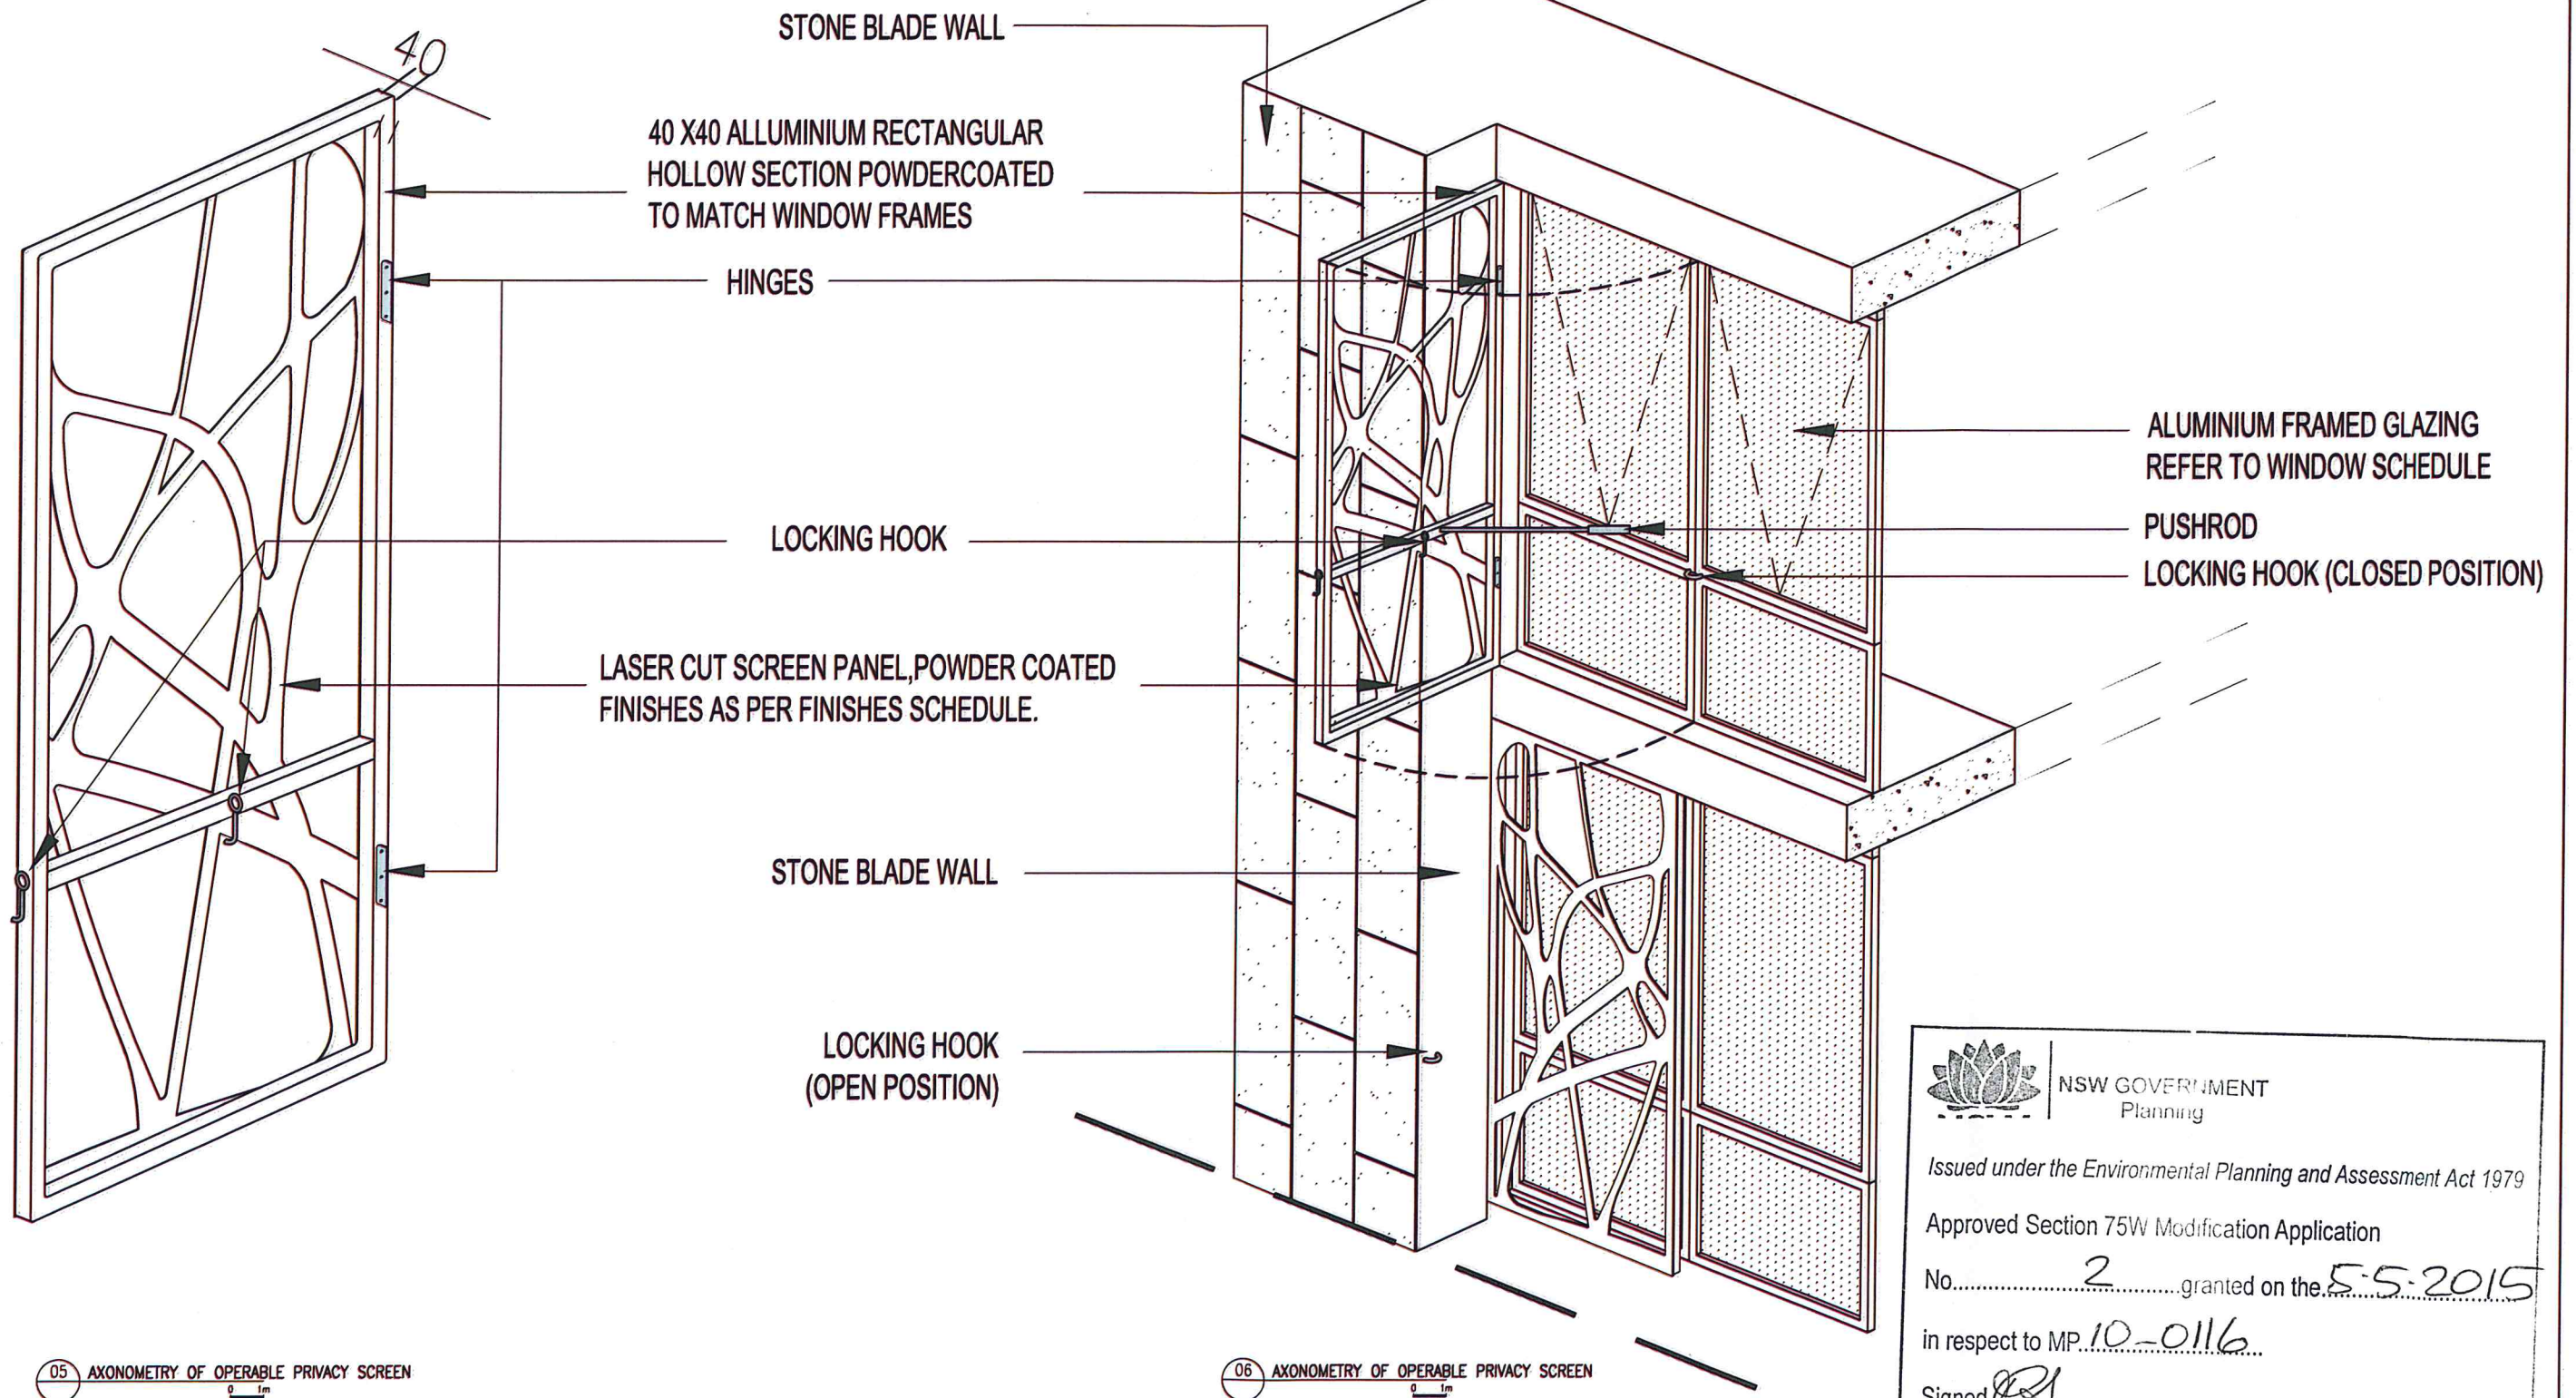

NSW GOVERNMENT
Planning

Issued under the Environmental Planning and Assessment Act 1979

Approved Section 75W Modification Application

No. 2 granted on the 5-5-2015

in respect to MP 10-0116

Signed [Signature]

Sheet No. 9 of 10

Rev.	Description	By	Date	Disclaimer	Notes	Important Notes:	Consultants	Client	Architects	Project	Key plan	Scale	Date
A	SECTION 96 - ADDITIONAL INFORMATION	WT	03.03.2015	THESE DRAWINGS ARE PRELIMINARY DRAWINGS AND ARE SUBJECT TO CHANGE WITHOUT NOTICE DURING THE COURSE OF THE PROJECT DEVELOPMENT AND IN ORDER TO COMPLY WITH ALL RELEVANT LEGISLATION AND STANDARDS. THE DRAWING IS NOT TO BE USED FOR CONSTRUCTION OR FOR ANY OTHER PURPOSE WITHOUT THE WRITTEN AUTHORIZATION OF THE ARCHITECT. THE ARCHITECT ACCEPTS NO LIABILITY FOR ANY LOSS OR DAMAGE, INCLUDING CONSEQUENTIAL DAMAGES, ARISING FROM THE USE OF THESE DRAWINGS. THE ARCHITECT'S LIABILITY IS LIMITED TO THE DESIGN AND CONSTRUCTION OF THE WORK SHOWN HEREIN. THE ARCHITECT'S LIABILITY DOES NOT EXTEND TO ANY OTHER WORK OR TO ANY OTHER PARTY. THE ARCHITECT'S LIABILITY IS LIMITED TO THE DESIGN AND CONSTRUCTION OF THE WORK SHOWN HEREIN. THE ARCHITECT'S LIABILITY DOES NOT EXTEND TO ANY OTHER WORK OR TO ANY OTHER PARTY.	THESE DRAWINGS ARE PRELIMINARY DRAWINGS AND ARE SUBJECT TO CHANGE WITHOUT NOTICE DURING THE COURSE OF THE PROJECT DEVELOPMENT AND IN ORDER TO COMPLY WITH ALL RELEVANT LEGISLATION AND STANDARDS. THE DRAWING IS NOT TO BE USED FOR CONSTRUCTION OR FOR ANY OTHER PURPOSE WITHOUT THE WRITTEN AUTHORIZATION OF THE ARCHITECT. THE ARCHITECT ACCEPTS NO LIABILITY FOR ANY LOSS OR DAMAGE, INCLUDING CONSEQUENTIAL DAMAGES, ARISING FROM THE USE OF THESE DRAWINGS. THE ARCHITECT'S LIABILITY IS LIMITED TO THE DESIGN AND CONSTRUCTION OF THE WORK SHOWN HEREIN. THE ARCHITECT'S LIABILITY DOES NOT EXTEND TO ANY OTHER WORK OR TO ANY OTHER PARTY.	1. Consultant shall retain all rights in the design and drawings. 2. Design shall be shown above existing conditions. 3. Design shall be shown above existing conditions.	PLANNING - NSW GOVERNMENT ARCHITECTS - TONY OWEN PARTNERS CLIENT - NEIL FREELAND Gosford Quarries PROJECT - 300 JOHNSTON STREET, ANNANDALE, NSW, 2038	NEIL FREELAND Gosford Quarries 300 Johnston Street, Annandale, NSW - 2038	TONY OWEN PARTNERS Level 11, 11-13 Market St, Sydney, NSW - 2000	Gosford Quarries Project address: 300 JOHNSTON STREET ANNANDALE, NSW, 2038	Key plan	Scale 1:100	Date: APRIL 2015

Technical drawing of a window assembly. The overall height is 2600 and the overall width is 2400. The assembly is divided into three main sections: a top-left pane labeled 'SL' (Safety Glass), a top-right pane labeled 'SG' (Safety Glass), and a bottom section labeled 'OPAQUE GLASS'. The height of the bottom section is 1100, and the height of the top section is 1500.

04 TYPICAL SYDNEY CONDITION
SOUTH ELEVATION SCALE 1:20 0 1



Issued under the Environmental Planning and Assessment Act 1979

No. 2 granted on the 5-5-2015

in respect to MP. 10-0116.....

Signed.....

Sheet No. 10 of 10

LOSS OF CLEAR GLASS: 0.9%

H.W: HINGED/AWNING WINDOW

05 PRIVACY SCREEN - SOLAR PENETRATION ANALYSIS
SOUTH ELEVATION SCALE 1:20 0 1

[illegible]