


CONCEPT PLAN FOOTPRINT - MARKUP OF REQUIRED AMENDMENT

LEGEND - FLOOR PLANS

- BOUNDARY
- SETBACK
- EASEMENT
- VEHICLE CIRCULATION ROAD
- APZ
- EXISTING BUILDINGS
- PROPOSED BUILDINGS

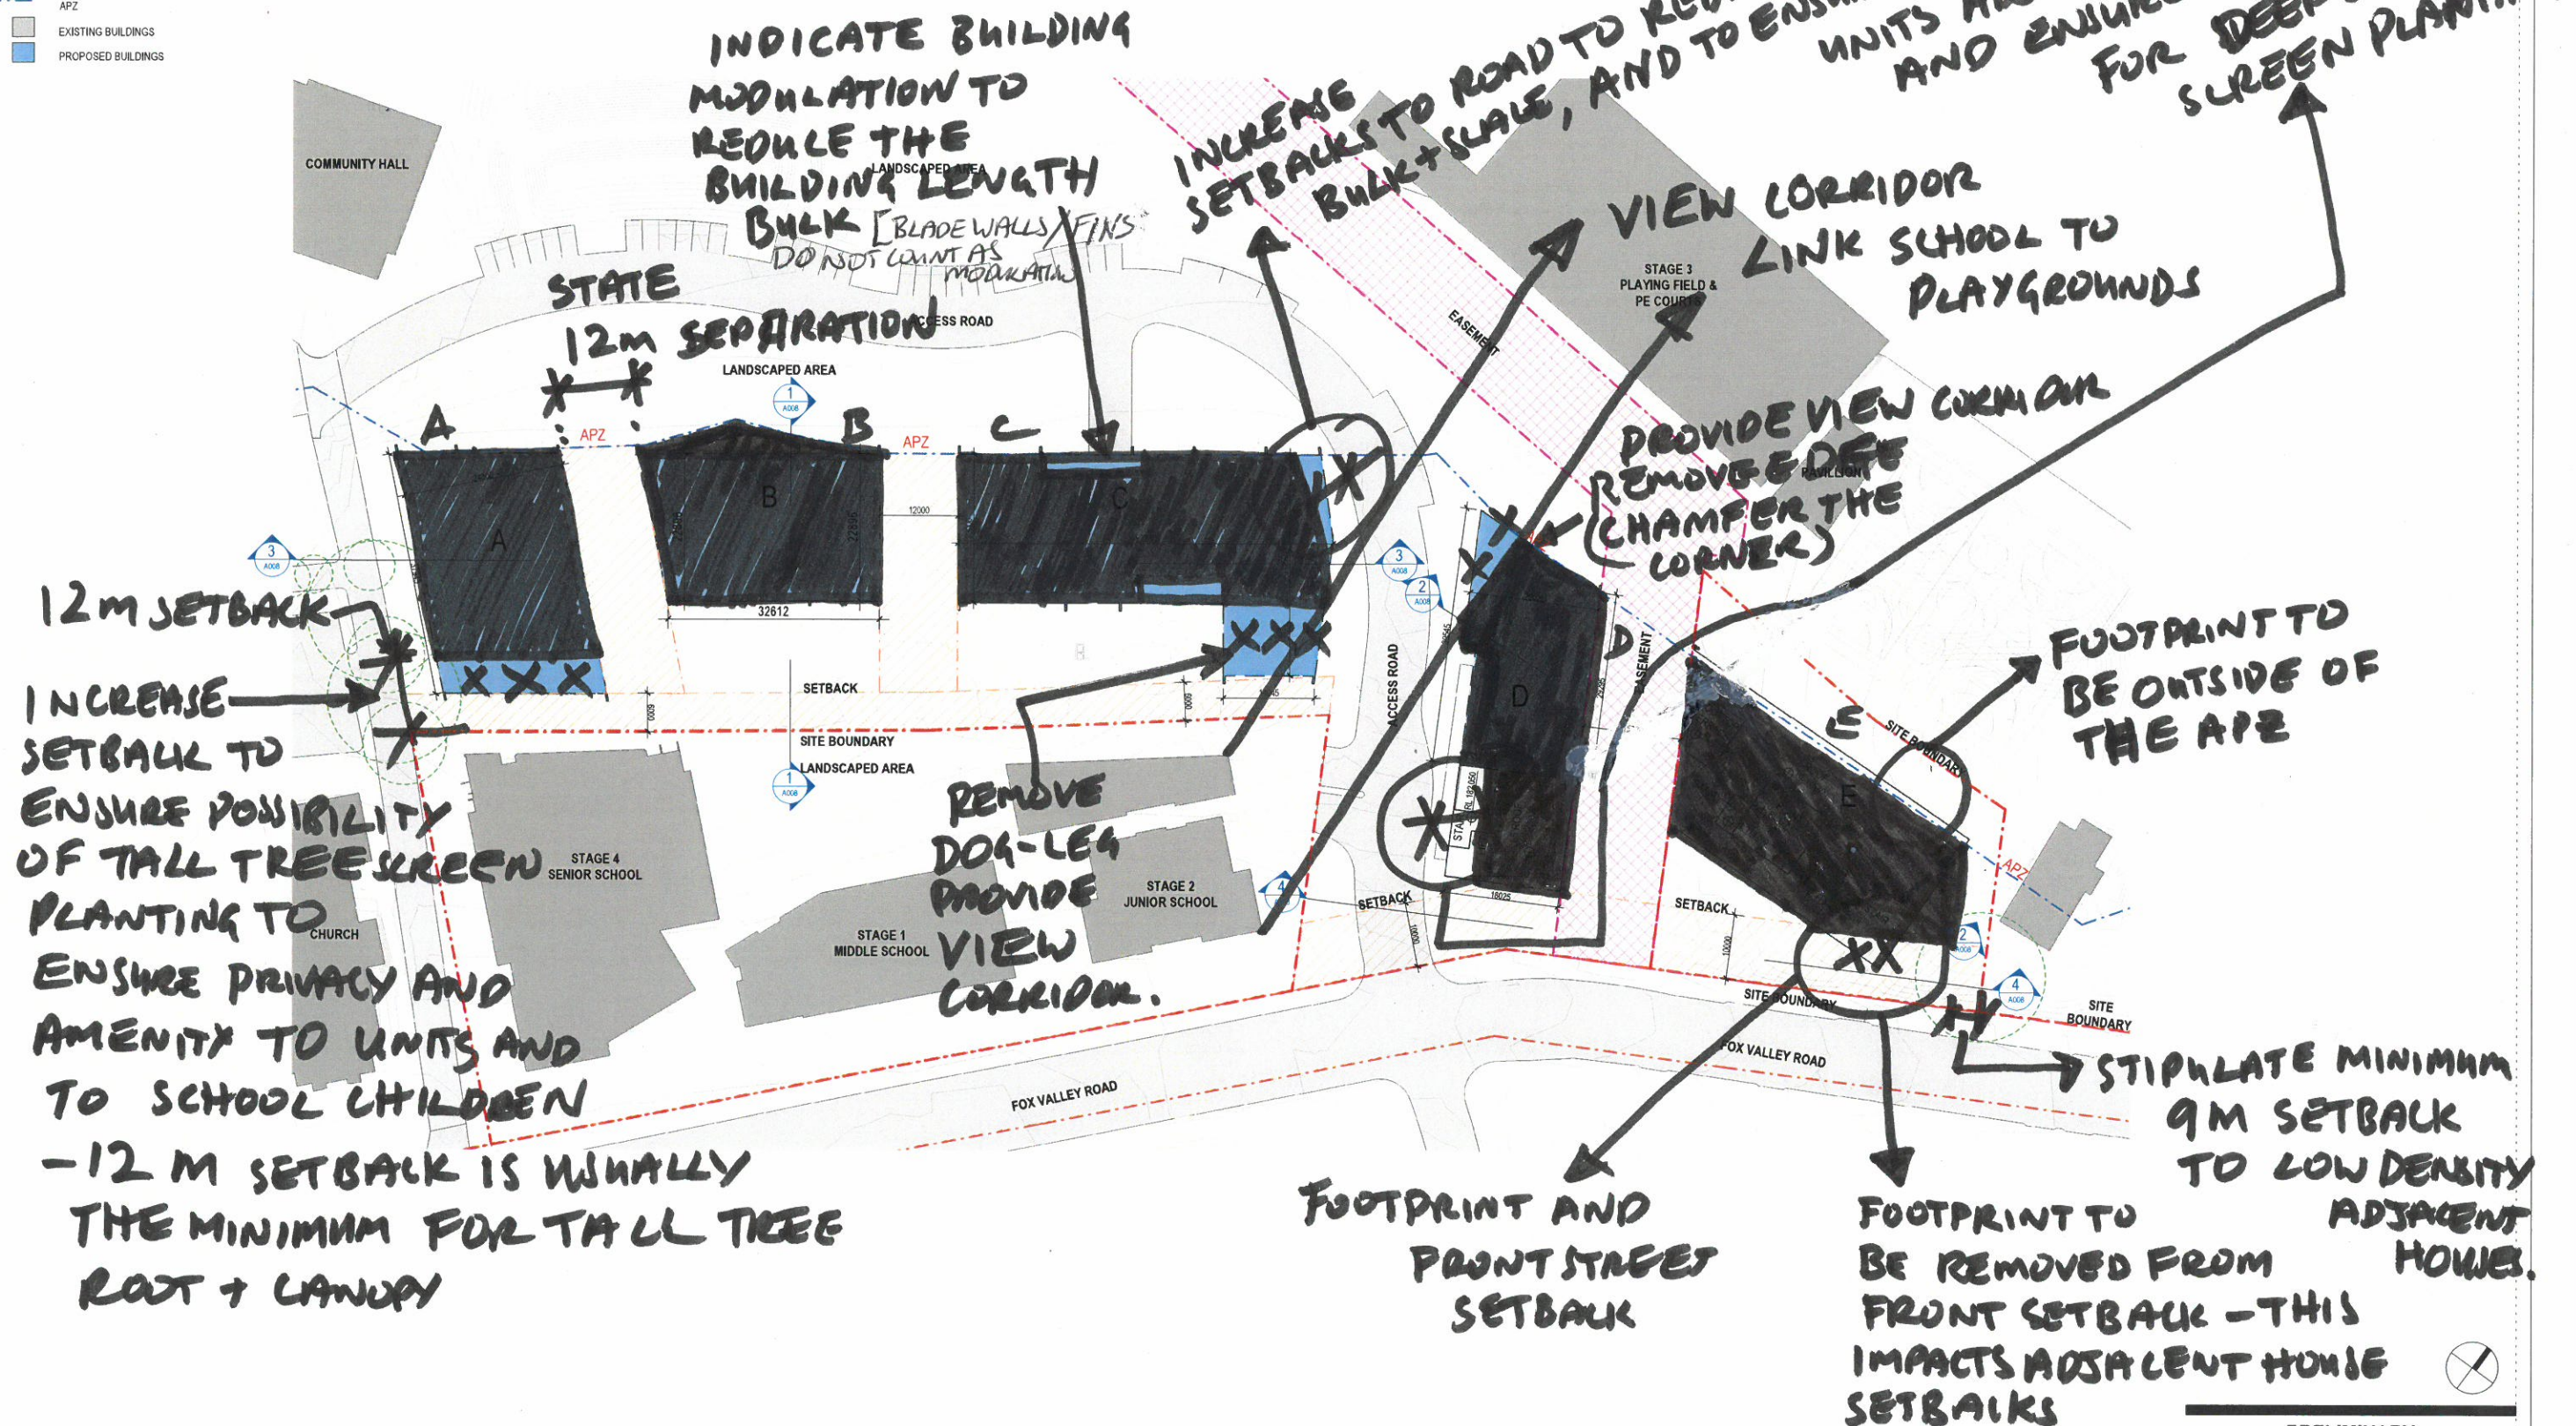

Issue	Description	Date
A	DRAFT S75W ISSUE	12.12.2017
B	S75W ISSUE	14.12.2017
C	REVISED S75W ISSUE	30.01.2018

Issue	Description	Date
A	DRAFT S75W ISSUE	12.12.2017
B	S75W ISSUE	14.12.2017
C	REVISED S75W ISSUE	30.01.2018

Consultant	Capital Bluestone
Consultant	Company
Consultant	Company
Consultant	Company
Consultant	Company

Client
CAPITAL BLUESTONE
Client Details

GROUP GSA

Group GSA Pty Ltd ABN 76 002 113 779
Level 7, 80 William St East Sydney NSW
Australia 2011
www.groupgsa.com

T +612 9361 4144 F +612 9332 3458

architecture interior design urban design landscape
nom architect M. Sheldon 3990

Project Title
WAHROONGA ESTATE

Drawing Title

SECTION 75W - URBAN FORM
CONTROL DIAGRAM - LEVEL 5

This drawing is the copyright of Group GSA Pty Ltd and may not be altered, reproduced or transmitted in any form or by any means in part or in whole without the written permission of Group GSA Pty Ltd.
All levels and dimensions are to be checked and verified on site prior to the commencement of any work, making of shop drawings or fabrication of components.
Do not scale drawings. Use figured dimensions.

PRELIMINARY			
Plotted and checked by	NM/LL	Verified	Approved
Drawing Created (date)	2018	Drawing Created (by)	NM/LL
Scale	Project No	Drawing No	Issue
1:500	15044	A006	C

30/01/2018 10:28 AM