


DRAWING NOT TO SCALE




LEGEND

- ELECTRICITY POLE
- FIBRE OPTIC CABLE
- CABLE CONDUIT (TRENCHING)
- CABLE CONDUIT (BORE TUNNELLING)
- UE P2 PIT
- UE P5 PIT
- UE P6 PIT
- UE P8 PIT
- UE P9 PIT
- BUILDING LINE
- BOK - BACK OF KERB
- CL - CENTRELINE OF CONDUIT
- TP - TURNING POINT OF CONDUIT
- FENCE LINE, FL
- TELSTRA MANHOLE
- TELSTRA PIT
- OPTICAL FIBRE JOINT
- JOINT LOOP (m) - POLE / UNDERGROUND
- CABLE HEAD POLE
- CABLE DEPTH

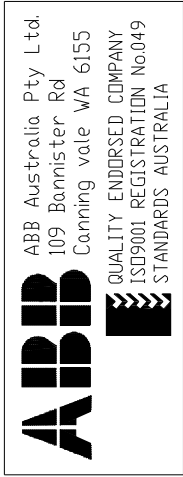

Note:

- Conduit depths quoted are approximate only and may change due to unforeseen circumstances.
- In all instances it is recommended that the position of conduits & cables should be proved on site by hand, prior to commencement of works.
- Loop in all pits unless otherwise stated.

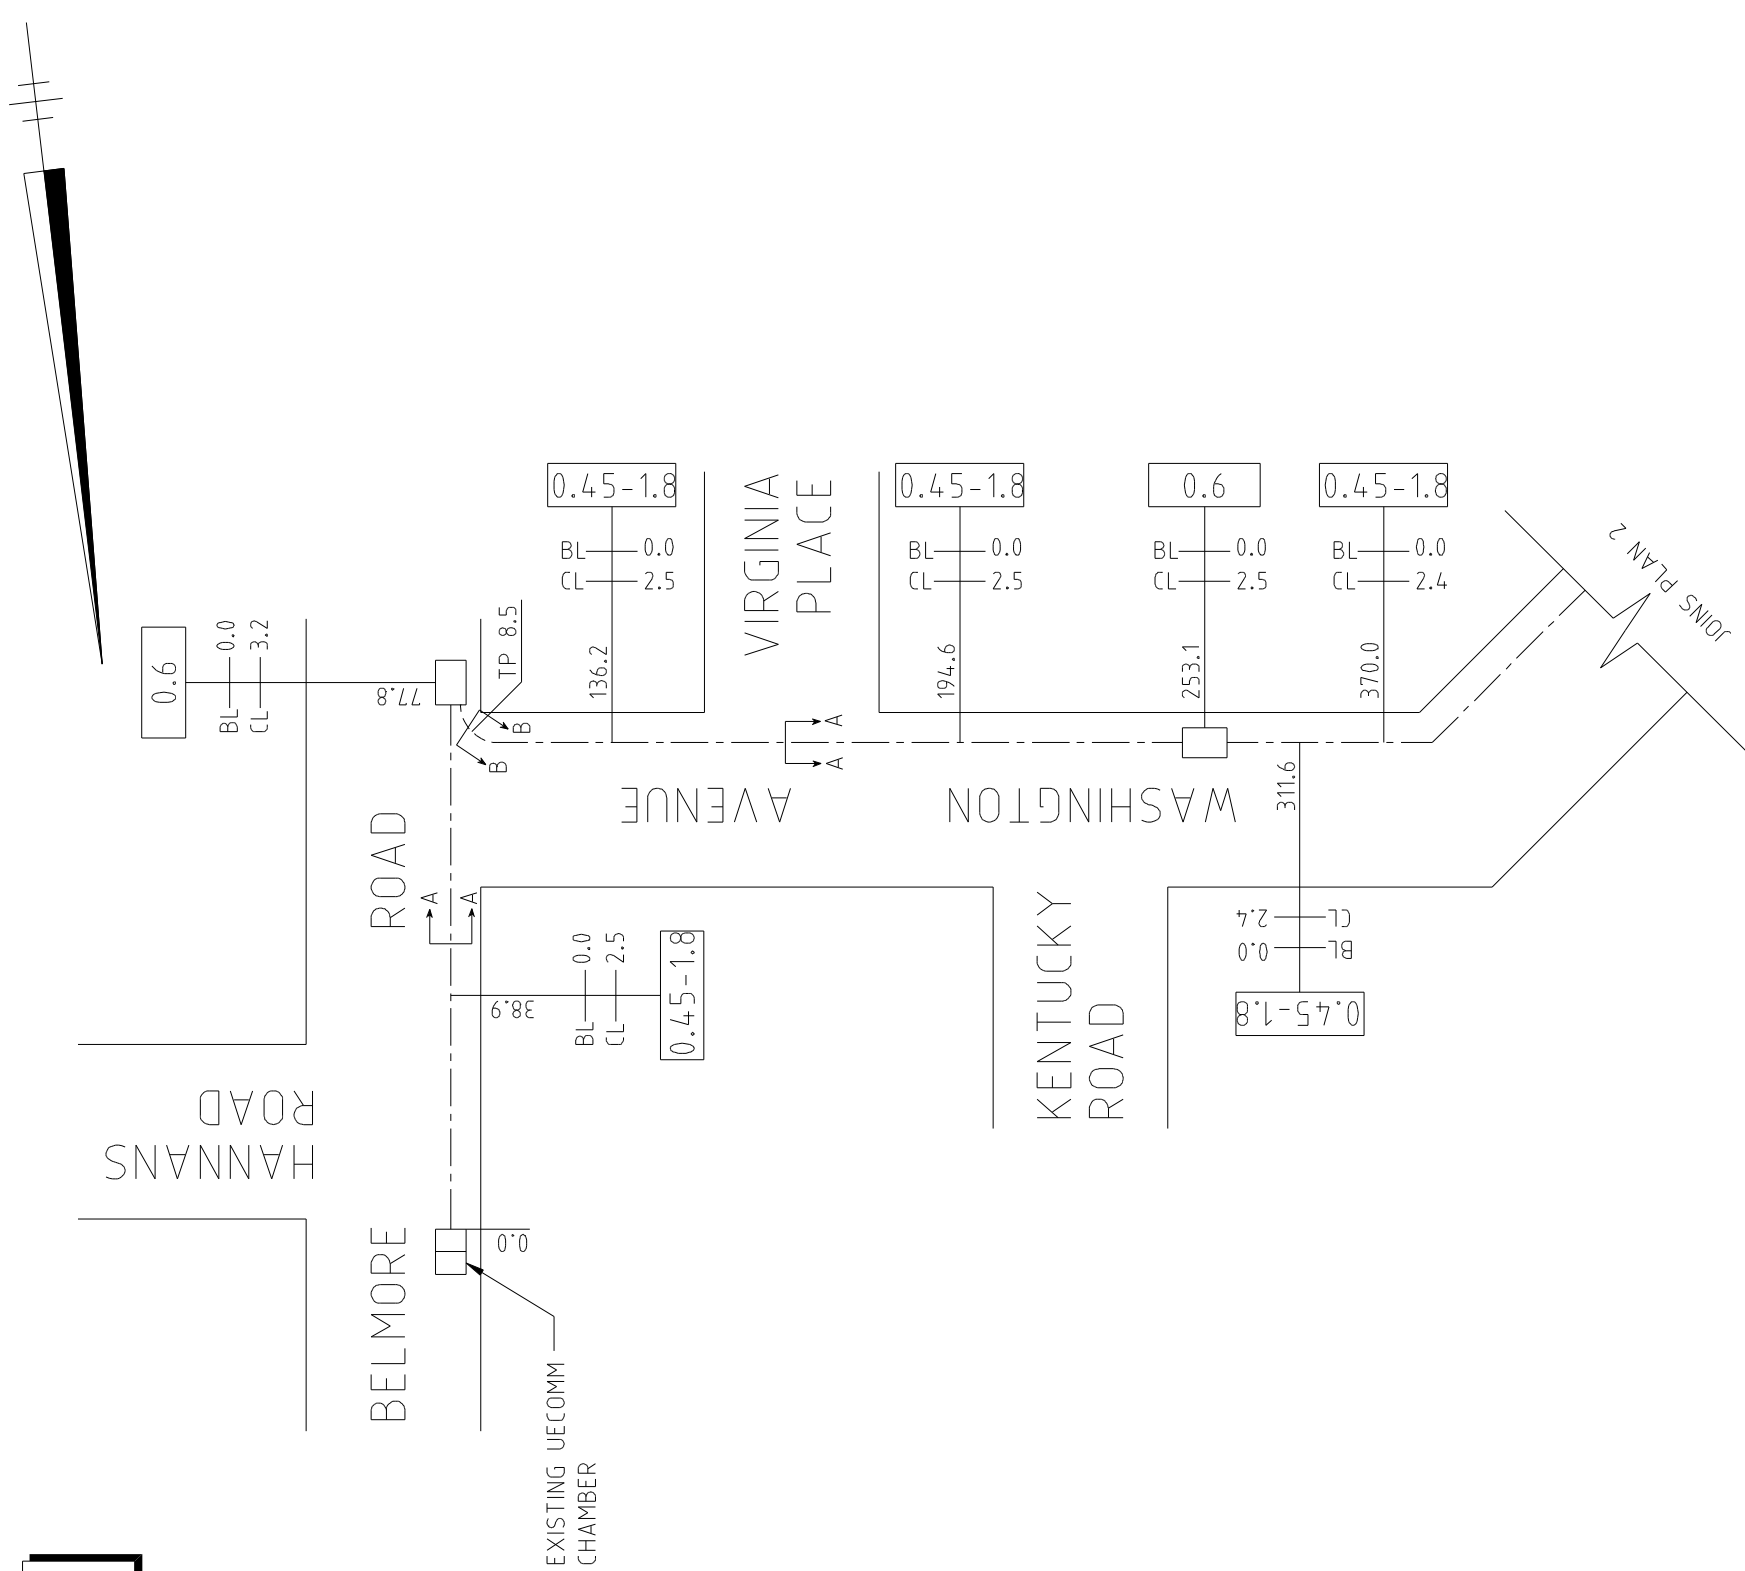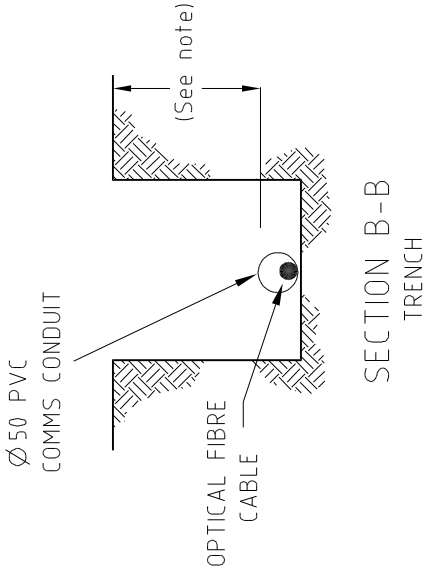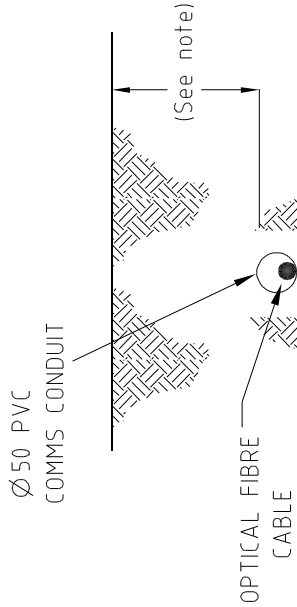

| REVISION | 14.08.03 | 0                    | AS BUILT | MW     | DC |
|----------|----------|----------------------|----------|--------|----|
|          |          |                      |          |        |    |
|          |          |                      |          |        |    |
|          |          |                      |          |        |    |
| DATE     | REV.     | REVISION DESCRIPTION | CHECKED  | APP'D. |    |

|                 |                                    |
|-----------------|------------------------------------|
| CONTACT OFFICER | TREVOR SMITH<br>PH: (02) 8226 3244 |
| PROJECT NUMBER  | UEC-DE&TS-382                      |
| PLAN No.        | -                                  |
| UBD REF         | 272-E13                            |

|                                                                                                                |                                                                     |
|----------------------------------------------------------------------------------------------------------------|---------------------------------------------------------------------|
| <br>UECOMM<br>MEL/SYD/QLD | DRAWN JMK<br>1408.03<br>DESIGN CHECKED<br>MW<br>1408.03<br>APPROVED |
|----------------------------------------------------------------------------------------------------------------|---------------------------------------------------------------------|

|                                |    |
|--------------------------------|----|
| DRG No. OFN5-SYD-2460-1        |    |
| EXTERNAL ROUTE (1 OF 2)        |    |
| RIVERWOOD PUBLIC SCHOOL (3743) |    |
| UNION STREET                   |    |
| RIVERWOD 2210                  | A3 |