
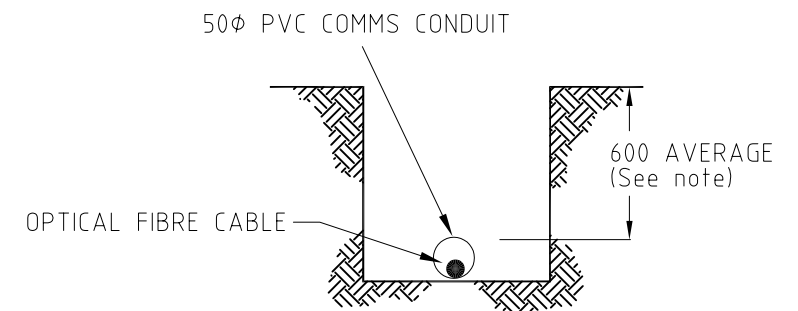
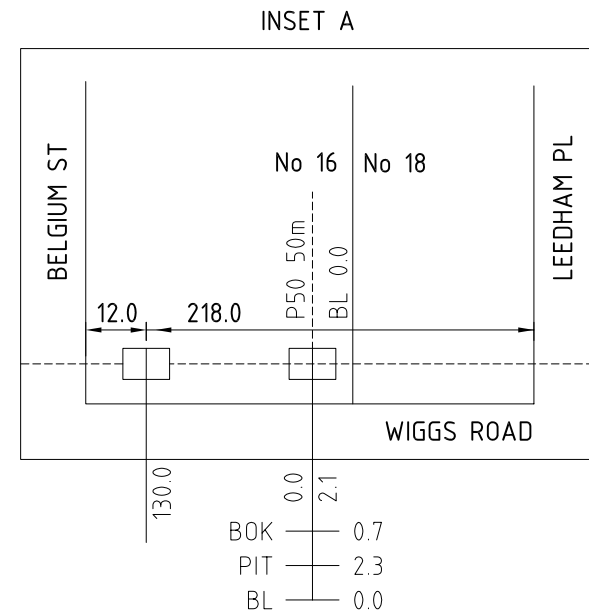



PREPARED BY: S & S QUIRK PTY LTD PH:(02) 9482 7944 FAX:(02) 9482 7955, ON BEHALF OF BCE FOR UE COMM.

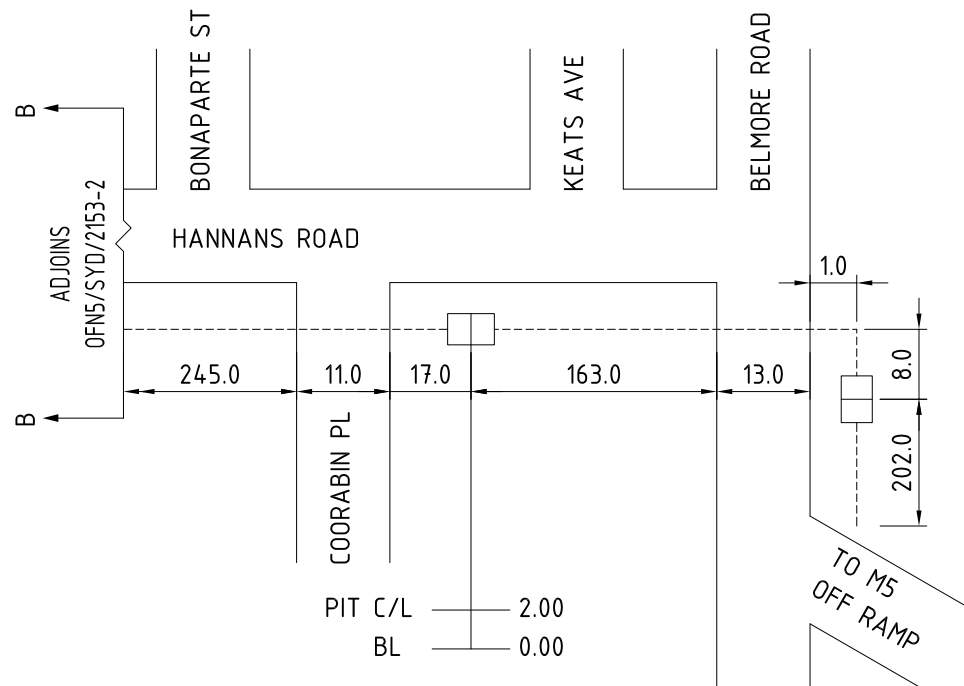

Note:
Conduit depths quoted are approximate only and may change due to unforeseen circumstances.
Excavate by hand until conduit depth is determined.

LEGEND

- - ELECTRICITY POLE
- - FIBRE OPTIC CABLE
- - UE P5 PIT
- ▢ - UE P6 PIT
- BL - BUILDING LINE
- PIT C/L - PIT CENTER LINE FROM BL
- BOK - BACK OF KERB
- CO - COVER
- - FENCE LINE
- ▴ - TELSTRA MANHOLE
- Ⓣ - TELSTRA PIT
- TT - TELSTRA 6 PIT

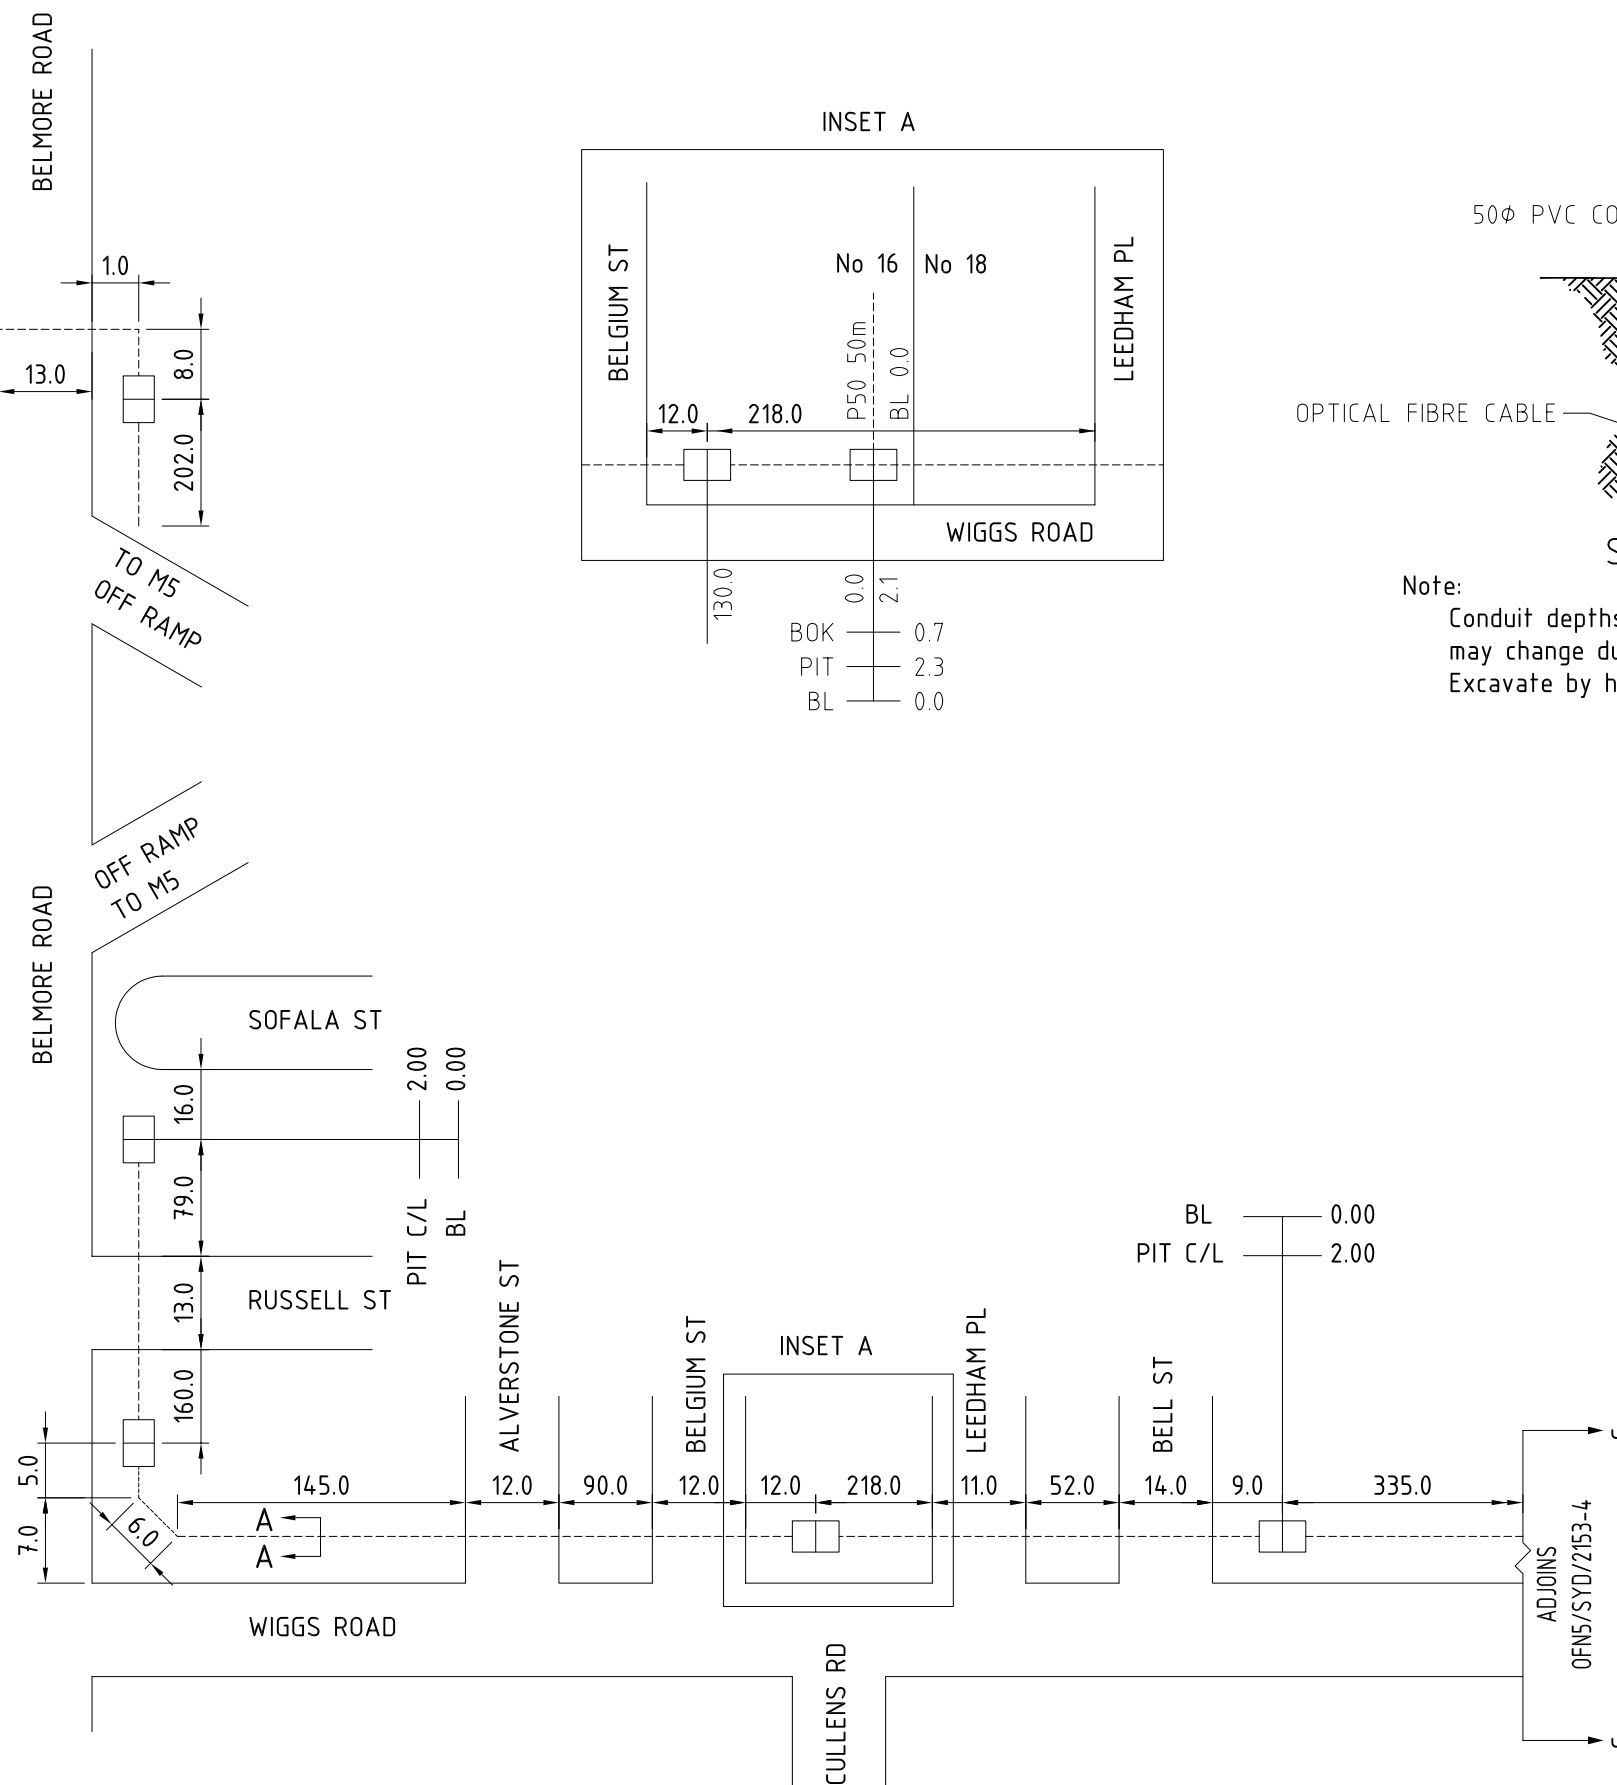

"AS-BUILT"
PLANS

NOTE: - ALL DIMENSIONS ARE SHOWN IN METRES UNLESS NOTED OTHERWISE.

REVISIONS					
	REV	DESCRIPTION	DATE	CHECKED	APPROVED
	B	NEW PIT & PIPE (YKPPS-101)	10.07.08	SG	
	A	RENUMBERED. WAS BCE-00-0074	26.02.01		

BCE
Brice Civil Engineering Pty Ltd
A.B.N. 13 087 182 581
P.O. Box 378 Cherrybrook NSW 2126 Ph:(02) 8850 7550 Fax: (02) 8850 7551

Uecomm
MAKING THE CONNECTION
ACN 079 083 195

APPROVED
R.Browne
26.02.01
UBD REF:
272-J13,H13,H12,H11,
H10,G10,F10,E9

PROJECT:
HANNANS ROAD -
WIGGS ROAD
RIVERWOOD NSW 2210
CONDUIT: 50mm
DEPTH: 0.5 - 0.7m

METHOD: DIRECTIONAL BORE AND EXCAVATION		
SCALE: NOT TO SCALE	DRAWN SSQ P/L	SIZE A3
DOCUMENT No: OFN5/SYD/2153-3	DATE: 10.02.01	REVISION: B