



Sandon Point Flood Study

Addendum No. 1

106062-03 Report 002 rev 2

Prepared for Stockland Development Pty Ltd

18 May 2009



Cardno Forbes Rigby Pty Ltd

ABN 41 003 936 981

278 Keira Street, Wollongong

NSW 2500 Australia

Telephone: 02 4228 4133

Facsimile: 02 4228 6811

International: +61 2 4228 4133

cfr@cardno.com.au

www.cardno.com.au

Document Control

| Version | Date | Author | | Reviewer | |
|-------------------------------|-------------|--------------|-----|------------------------|-----|
| Report 002 Rev 2 Final Rpt | 18 May 2009 | Mark Favetta | MBF | Anthony Barthelmess | AJB |

"© 2008 Cardno Forbes Rigby Pty Ltd All Rights Reserved. Copyright in the whole and every part of this document belongs to Cardno Forbes Rigby Pty Ltd and may not be used, sold, transferred, copied or reproduced in whole or in part in any manner or form or in or on any media to any person without the prior written consent of Cardno Forbes Rigby Pt Ltd."

Anthony Barthelmess
Project Director

Mark Favetta
Environmental Engineer

Table of Contents

| | | |
|----------|--|-----------|
| 1 | Introduction | 1 |
| 1.1 | Background | 1 |
| 1.2 | Purpose of This Addendum Report..... | 1 |
| 2 | Discussion of SKM Peer Review Comments..... | 2 |
| 2.1 | SKM Report Recommended Actions – March 2009 | 2 |
| 2.1.1 | Reduced Roughness Configuration of Creek Channel | 2 |
| 2.1.2 | Beach Berm Migration | 2 |
| 2.1.3 | Alternate Bridge Modelling Approaches..... | 2 |
| 2.1.4 | No Upgrade to Woodlands Creek Culvert..... | 2 |
| 2.1.5 | Design Flow Increase of 20% | 3 |
| 2.1.6 | Woodlands Creek Transitioning | 3 |
| 2.1.7 | Alternate Approach to Creek Design..... | 4 |
| 2.1.8 | Geomorphic Assessment | 4 |
| 2.1.9 | Post Construction Monitoring | 5 |
| 2.2 | SKM Letter – 12 March 2009 | 5 |
| 2.2.1 | Sediment Deposition in Woodlands Creek | 5 |
| 2.2.2 | Erosion Protection Treatment | 6 |
| 2.2.3 | Construction of Rock Treatments..... | 6 |
| 2.2.4 | Establishment-Stage Vegetation Management..... | 6 |
| 3 | Additional Hydraulic Modelling | 7 |
| 3.1 | Alternative Bridge Modelling Approaches | 7 |
| 3.1.1 | Original Method: Energy Equation | 8 |
| 3.1.2 | Alternative Method #1: Momentum Balance for Low Flow | 8 |
| 3.1.3 | Alternative Method #2: Weir Plus Pressurised Flow for High Flow..... | 9 |
| 3.1.4 | Comparison between Methods | 9 |
| 3.2 | Beach Berm Migration..... | 12 |
| 4 | Conclusions..... | 15 |
| | References | 16 |

List of Figures

| | |
|---|----|
| Figure 1: HECRAS Cross-Section Computation Near and Inside a Bridge..... | 8 |
| Figure 2 Comparison of Bridge Modelling Techniques for Hewitts Creek | 9 |
| Figure 3 Comparison of Bridge Modelling Techniques for Woodlands Creek..... | 10 |
| Figure 4 Shade Plot of Hewitts, Woodlands and Tramway Creeks Entrance to Ocean..... | 12 |
| Figure 5 Photograph of Scour in Hewitts Creek Just After August 1998 Flood..... | 13 |
| Figure 6 Conservative Climate Change Beach Berm Effects | 14 |

Annexes

- A. Hydraulic Model Results
- B. Creek Design Plans
- C. Additional Plans

1 Introduction

1.1 Background

The NSW Department of Planning engaged Sinclair Knight Merz (SKM) to undertake a peer review assessment of the flood and climate change assessments undertaken for the Sandon Point development (MP07_0032).

SKM issued their preliminary draft report on 9 December 2008, containing a suite of recommendations to the Department of Planning outlining where SKM believed further work was required. The issues related to stream stability, flooding and climate change.

A meeting was held on 27th February 2009 at the Department of Planning, attended by representatives from the Department of Planning, Stockland, Don Fox Planning, Cardno Forbes Rigby and SKM. The purpose of this meeting was to discuss in more detail the issues SKM required addressing prior to the development approval being granted, and to attempt to settle any resolvable issues during the meeting.

CFR tabled two different plans (see **Appendix C** of this report) showing historic geomorphic data through the site, which were at odds with SKM's position that channel failures were possible.

As SKM's geomorphologist had not had the benefit of visiting the site prior to making comments, it was agreed that SKM would attend a joint site inspection. This inspection was undertaken on 9 March 2009 attended by Anthony Barthelmess (CFR), Lih Chong (SKM) and Peter Sandercock (SKM). The historical geomorphic data extracted from the previous Hewitts Creek studies was discussed with SKM showing how the site, and the catchment, had responded geomorphically to various historic flood events.

SKM issued their final Peer Review Report on 6th March 2009 which included specific 'recommended actions' to be undertaken. SKM further issued a letter dated 12 March 2009 outlining their further requirements and modified 'list of issues' after having the benefit of the site inspection.

1.2 Purpose of This Addendum Report

This report responds to:

1. The recommended actions in the SKM 6 March 2009 report
2. The additional issues contained in the SKM letter of 12 March 2009

2 Discussion of SKM Peer Review Comments

The following sections have been structured to align with SKM's comments for ease of review.

2.1 SKM Report Recommended Actions – March 2009

2.1.1 Reduced Roughness Configuration of Creek Channel

SKM state:

Undertake sensitivity analysis in the hydraulic modelling, incorporating lower Manning's' n values than the design values of 0.1 – 0.15, to estimate flow velocities and shear stresses for comparison against stability thresholds for the selected channel lining materials

SKM further advise in their 12 March 2009 letter that they consider this issue to be resolved. SKM states that they *have since received a response from Cardno on this issue, and is satisfied that the adopted channel roughness values relate to an established, vegetated state of the channel.*

2.1.2 Beach Berm Migration

SKM state:

Consider the impact of climate change-induced beach berm migration (associated with sea level rise and shoreline recession) on flooding behaviour in Woodlands and Hewitts Creeks

We have undertaken additional modelling as recommended, and presented this in detail at **Section 3.2** of this report. The modelling conclusively shows that such impacts will have no effect on flood levels through the subject site. We consider this issue to be resolved.

2.1.3 Alternate Bridge Modelling Approaches

SKM state:

Undertake further flood modelling, utilizing the appropriate bridge modelling approaches for the proposed bridges on Woodlands and Hewitts Creeks, and subsequently provide the flood modelling results to demonstrate the sensitivity of the design flood levels to the change in bridge modelling approach;

We have undertaken additional modelling as recommended, and present this in detail at **Section 3.1** of this report. The modelling conclusively shows that such impacts will have minimal effect on flood levels through the subject site. We consider this issue to be resolved.

2.1.4 No Upgrade to Woodlands Creek Culvert

SKM state:

Undertake sensitivity analysis of "no culvert upgrade" scenario (Woodlands Creek railway culverts) in the climate change scenario, and assess its impact on flood flows and flood behaviour;

In an email from SKM's Lih Chong to CFR's Anthony Barthelmess dated 2 March 2009, SKM advise that *SKM is satisfied with CFR's assurance that Council is committed to upgrading the Woodlands Creek railway culvert in the near future. Highly unlikely that the "no culvert upgrade" scenario will occur in the climate change scenario. No further action required on this issue.*

This is further reinforced by the advice on Wollongong Council's website, which advises:

Woodlands Creek, Bulli - upgrade of railway culvert. Significant flooding is also known to occur in the area immediately upstream of the Illawarra Railway line embankment (including the Princes Highway) due to the inadequate capacity of the existing culvert beneath the railway line and its potential to block with debris. This project aims to reduce the incidence of flooding along the section of Woodlands Creek immediately upstream of the railway embankment by upgrading the existing culvert system. As a result, the capacity of the upgraded system will be significantly increased, therefore reducing its potential to block, and resulting in lower flood levels upstream of the railway line. The project is currently in the preliminary design phase. <http://www.wollongong.nsw.gov.au/environment/hewittscreek.asp>

We understand that SKM have been engaged to undertake this preliminary design work which is noted on the website as being underway. We therefore consider this issue to be resolved.

2.1.5 Design Flow Increase of 20%

SKM state:

Undertake sensitivity analysis in the hydraulic modelling, incorporating a 20% increase in the design flows in the 100 year ARI event (existing climate scenario).

CFR sees little point in undertaking a 20% sensitivity model run for this scenario, when our modelling already provides for a 30% increase in design flows through the site. The modelling for this 30% increase in design flows shows that the proposed development, and the proposed floor levels and compliance with Council's DCP54 are not adversely impacted by a 30% increase in design flow.

Further, the sensitivity analysis already undertaken (and the adopted design flows) are well in excess of DECC's 'Practical Considerations of Climate Change' guidelines (2007). This guideline suggests only a 7% increase in extreme rainfall for the Illawarra, whereas our design adopts a 30% increase in extreme rainfall. CFR considers it inappropriate to conduct a further sensitivity of a 20% increase in flow, on top of a 30% increase in flow which is already excessive when compared with DECC's best practice guideline.

As such, we consider the assessment of a 20% increase in design flow to be not in accordance with current DECC guidelines, and have not included such an assessment in this addendum. We consider this issue to be resolved.

2.1.6 Woodlands Creek Transitioning

SKM state:

Provide clear demonstration of effective transitioning between the Woodlands Creek re-diversion and the area downstream of the site on the design plans. More detailed topographic data required for the downstream area.

The diversion works are required by Council, under the Hewitts Creek Floodplain Risk Management Study & Plan (2002) and are not required to support the development. SKM accepts that the proposed tail-out works are only an interim stage for the purpose of designing and constructing the proposed Woodlands Creek floodway. SKM also accepts that the tail-out works can be upgraded once Council negotiates permission with the affected landowner.

Stockland is proposing to carry out tail-out works for a length of approximately 15m along Woodlands Creek and approximately 75m along Hewitts Creek. As SKM correctly observe the upgrades (i.e. further works identified in the Hewitts Creek FRMS&P) would be carried out by Council, once Council has obtained permission from the affected landowner.

This is not work that will be undertaken by Stockland and an experienced civil engineering designer would have little difficulty in transitioning into the downstream landscape. If Council had foreseen engineering difficulties when preparing the Hewitts Creek FRMS&P, then the Council and community might not have supported or adopted the Hewitts Creek FRMS&P.

We also note that the Woodlands Creek diversion was deemed as having a 'high priority' for upgrade in the Hewitts Creek FRMS&P. Measures that are given a 'high priority' contribute the most to a schemes benefit, and for this reason the Hewitts Creek FRMS&P states that such works should be implemented as soon as funding is made available. It is anticipated that this may occur over a 1-5 year time frame.

As the Hewitts Creek FRMS&P was published in 2002, such works should have been implemented by 2007. We infer that these works are still 'high priority' and as such will likely be implemented in the immediate future. Given the above, it is likely that the Woodlands Creek diversion works may be undertaken by Council prior to the work being undertaken by Stockland, given that the works are overdue for completion.

2.1.7 Alternate Approach to Creek Design

SKM state:

Develop an alternative approach for the creek design, in agreement with DoP / peer reviewer;

This comment was provided by SKM prior to their geomorphologist inspecting the site. A subsequent inspection was undertaken on 9 March 2009 and historic geomorphic information was provided to SKM. Further issues came out of this site inspection and were provided in SKM's 12 March 2009 letter. We have also addressed these additional issues in this report.

We contend that this peer review process constitutes the outcome of an alternate design developed in agreement with DoP's peer reviewer. SKM have made direct comments and contributions to the design and the current design represents their inputs. Revised design plans are included in **Appendix B**, which introduce additional creek bed armouring and rock bed controls in both Hewitts and Woodlands Creeks. We consider this issue to be resolved.

2.1.8 Geomorphic Assessment

SKM state:

Undertake appropriate geomorphic assessments to support proposed creek design, with consideration of stability/erodibility of fill material on site;

Again, we contend that this peer review process constitutes the outcome of an appropriate geomorphic assessment being undertaken. CFR prepared the original design put forward for approval, and through the peer review process SKM's expert geomorphologist has made several comments relating to how the designs could be improved and made more robust. CFR has acknowledged and responded to each and every comment and this direct input from SKM is reflected in the current design (see plans in **Appendix B**). We consider this issue to be resolved.

2.1.9 Post Construction Monitoring

SKM state:

Monitor the post-construction creek for any impacts of the Woodlands Creek re-diversion on downstream habitats. The monitoring will identify any necessary adaptive maintenance actions.

No action is required at this stage. Stockland are implementing a flood mitigation scheme on behalf of Council; in other words these works would have occurred irrespective of the Sandon Point development. Ongoing monitoring of the performance of these works is a general requirement of these works, and if Council were to have implemented these works prior to it being undertaken by Stockland, Council would have been required to undertake such monitoring.

As the works are required by Council, under the Hewitts Creek Floodplain Risk Management Study & Plan (2002), and not required to support the development, we recommend Council undertake inspections after each flood event to monitor the need for any adaptive maintenance requirements.

Further, the Statement of Commitments references a 2 year maintenance period for WSUD features and a 5 year maintenance period for vegetation and open space. This maintenance period is from the release of the final subdivision certificate. The post construction monitoring requested by SKM is already covered under this maintenance plan referenced in the Statement of Commitments.

2.2 SKM Letter – 12 March 2009

2.2.1 Sediment Deposition in Woodlands Creek

SKM state:

There is potential for sediment deposition to occur in the reconstructed creeks, particularly Woodlands Creek once the railway culvert is opened up and the proposed vegetation is established. This may reduce the hydraulic capacity of the creeks. The proponent needs to coordinate with Council to ensure that monitoring of sedimentation and adequate maintenance occurs.

No action is required at this stage. Stockland are implementing a flood mitigation scheme on behalf of Council; in other words these works would have occurred irrespective of the Sandon Point development. Ongoing monitoring of the performance of these works is a general requirement of these works, and if Council were to have implemented these works prior to it being undertaken by Stockland, Council would have been required to undertake such monitoring. As the works are required by Council, under the Hewitts Creek Floodplain Risk Management Study & Plan (2002), and not required to support the development, we recommend Council undertake inspections after each flood event to monitor sediment accumulation (if any).

Further, the Statement of Commitments references a 2 year maintenance period for WSUD features and a 5 year maintenance period for vegetation and open space. This maintenance period is from the release of the final subdivision certificate. The post construction monitoring requested by SKM is already covered under this maintenance plan referenced in the Statement of Commitments.

2.2.2 Erosion Protection Treatment

SKM state:

Sizing of rocks in the erosion protection treatments is potentially undersized, considering the estimated shear stresses and velocities, and the shear stress and velocity thresholds presented in Fischenich (2001), on which Cardno's rock armour sizing is based. While the general nature of the treatments are acceptable, the size of the rocks which make up the treatment may need to be increased to provide sufficient stability (given the Director-General's requirements for a 20 year ARI design event). Therefore, it is recommended that Cardno reconsider the required sizing of the rocks in the erosion protection treatments.

CFR has amended the design plans to show a general increase in the application of rock to the creek bed, to cater for SKM's concerns regarding a potential under sizing of this material. The updated design plans are included in this report as **Appendix B**. CFR will further consider such changes to the rock armouring details at detailed design stage. We consider no further action is required.

2.2.3 Construction of Rock Treatments

SKM state:

Details on how individual rocks will be keyed in/interlocked with each other, plus how the ends of the rock treatments will be constructed (to prevent outflanking) should be provided. As this may be considered a detailed design issue, it would be satisfactory to provide this information at the detailed design stage.

No action is required at this stage. As SKM suggest, further details can be readily provided at detailed design stage and an additional Statement of Commitment can be proposed.

2.2.4 Establishment-Stage Vegetation Management

SKM state:

In the Final Report, SKM identified the issue that the adopted channel roughness in the hydraulic modelling for the proposed reconstructed creeks was excessively high. SKM has since received a response from Cardno on this issue, and is satisfied that the adopted channel roughness values related to an established, vegetated state of the channel. The proposed vegetation will help to manage erosion and scour when established by reducing flow velocities and physically binding the creek bed material.

However, details on establishment-stage erosion control should be provided measures to demonstrate that the un-vegetated channel would not be eroded by the higher flow velocities expected during the establishment stage. As this may be considered a detailed design issue, it would be satisfactory to provide this information at the detailed design stage.

No action is required at this stage. As SKM suggest, further details can be readily provided at detailed design stage and an additional Statement of Commitment can be proposed.

3 Additional Hydraulic Modelling

This chapter builds upon previous hydraulic modeling undertaken for our March 2008 report titled Sandon Point Flood Study: Concept Plan Application – Climate Change Assessment. The additional hydraulic modeling performed for this report is based on recommendations made in SKM's peer review of the flooding and climate change impacts of the Sandon Point development.

3.1 Alternative Bridge Modelling Approaches

Hydraulic models are constructed to determine flood levels along watercourses and through urban areas where flooding could potentially be an issue. Bridges may be represented in hydraulic models in a number of ways. When modelling clear span bridges which have the soffit (i.e. the underside of the bridge deck) located above flood levels, the choice of bridge modelling approach has a very minor effect on resulting flood levels.

The HECRAS hydraulic model prepared for the March 2008 version of the Sandon Point Flood Study utilised the Energy Equation standard step method bridge modelling approach in HECRAS for both low flow and high flow conditions through proposed bridge structures on Hewitts and Woodlands Creeks.

Low flow exists when the flow through the bridge opening is open channel flow. This means that water is below the underside of the bridge deck.

HECRAS automatically computes the class of low flow by solving the momentum equation at critical depth inside the bridge at the upstream and downstream ends. It uses the end with the most constricted section as the controlling section in the bridge. The momentum at critical depth of the controlling section is then compared to the momentum of the flow downstream of the bridge when performing a subcritical profile and upstream of the bridge for a supercritical profile.

If the momentum downstream of the bridge is greater than the critical depth momentum inside the bridge, the class of flow is considered to be completely subcritical (i.e. class A low flow). If the momentum downstream is less than the momentum at critical depth in the controlling bridge section, then it is assumed that constriction will cause the flow to pass through the critical depth and a hydraulic jump will occur at some distance downstream (i.e. class B low flow). If the profile is completely supercritical through the bridge, then it is considered class C low flow (USACE, 2004).

High flow exists when the flow through a bridge opening contact with the underside of the bridge deck.

At the request of SKM we have assessed the effect of using alternative bridge modelling approaches.

The effect of using an alternative energy equation to assess water levels and velocities through a bridge structure is more pronounced when a constricted cross-sectional area is available for flow. We have thus performed all sensitivity analysis to assess the effects using alternative bridge modelling approaches on the 25% bottom-up bridge blockage scenario. It is noted the 25% is blockage scenario was selected as Council requires assessment of this case for water levels in accordance with their conduit blockage policy. We have also performed the sensitivity analysis using the adopted upper bound climate change flows to representative of a thirty percent increase in rainfall intensity.

3.1.1 Original Method: Energy Equation

HECRAS solves the energy equation in the same manner for both low flows and high flows. Computations are based on balancing the energy equation in three steps through the bridge. Energy losses are based on friction and contraction and expansion losses. The energy based method performs all computations as though they are in open channel flow. This is done in the same manner as a natural river cross section would be solved. Where cross-sectional area is obstructed by bridge piers, abutments, and deck, this area is subtracted from the flow area and additional wetted perimeter is added.

The sequence of calculations for solving the energy equation is performed in three standard steps (refer to **Figure 1** for bridge cross-section locations).

1. From just downstream of the bridge (section 2) to just inside the downstream section of bridge (section BD)
2. Inside the bridge from section BD to section BU
3. From just inside the upstream section of the bridge (section BU) to the just upstream of the bridge (section 3)

The energy based method requires input of Manning's n values for friction losses and contraction and expansion coefficients for transition losses.

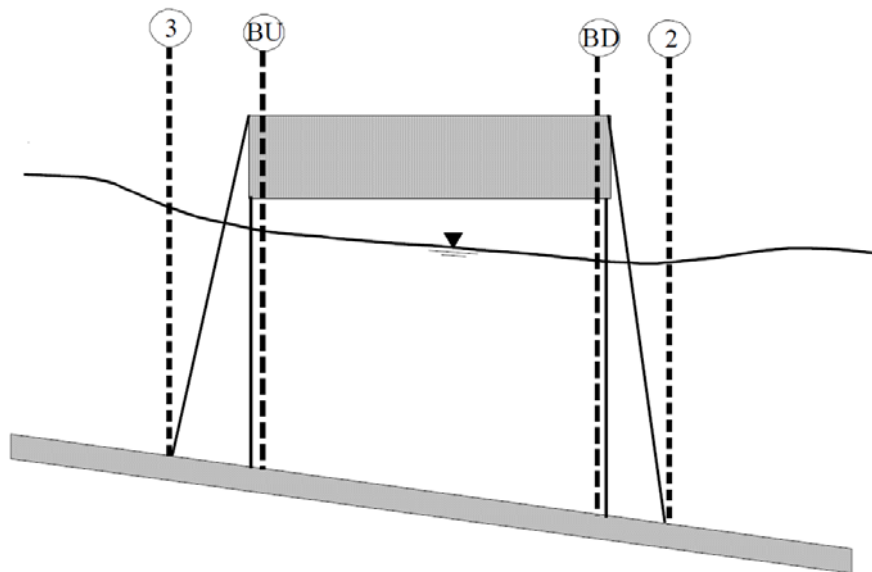


Figure 1: HECRAS Cross-Section Computation Near and Inside a Bridge

3.1.2 Alternative Method #1: Momentum Balance for Low Flow

The momentum balance method is based on performing a momentum balance from cross-section 2 to cross-section 3 (refer to **Figure 1** above for cross-section location). The sequence of calculations is performed in the same order as energy equation standard steps. The momentum balance method requires the use of roughness coefficients for the estimation of friction force and a drag coefficient for the force of drag on piers. Drag coefficients are used to estimate the force due to the water moving around the piers, the separations of the flow, and the resulting wake that occurs downstream (USACE, 2004).

We have selected a circular pier shape with a drag coefficient C_D of 1.20 to represent the piers on the bridges in accordance with the proposed design. It is noted that if water touches the underside of the bridge, the momentum equation is assumed to be invalid.

3.1.3 Alternative Method #2: Weir Plus Pressurised Flow for High Flow

This approach separates the hydraulic equations to compute flow as pressure and/or weir flow. Pressure flow occurs when the flow touches the underside of the bridge. A backwater will occur and orifice flow is established. HECRAS automatically selects the appropriate orifice flow equation depending on the flow situation. The discharge coefficient used in this equation will vary based on the amount the inlet is submerged. HECRAS has been set to automatically calculate this. Flow over the bridge is calculated using the standard weir equation. The approach velocity is included in the calculation by using the energy grade line elevation in lieu of the upstream water surface elevation for computing the head (USACE, 2004). The program performs a series of iterations to calculate the proportion of each type of flow i.e. weir or pressurised flow.

3.1.4 Comparison between Methods

HEWITTS CREEK

Flow through the Hewitts Creek Bridge operates under low flow conditions (i.e. channel flow) for events up to the 100 year ARI and high flow conditions for the PMF. This assessment was performed with the bridge 25% blocked and using the future upper bound climate change scenario flows. During the 100 year ARI, when using the momentum balance equation, flood levels reach a maximum of 0.10 m higher on the upstream side of the bridge. It is noted that there is no change in the 100 year ARI flood levels when using the weir plus pressurised flow for high flow conditions as the water level does not reach the underside of the bridge deck (so pressurised flow does not occur).

When using the weir plus pressurised flow for high flow conditions during the PMF, the resulting flood levels are a maximum of 0.08 m higher on the upstream side of the bridge. It is noted the momentum balance equation becomes invalid for this flow scenario as water touches the underside of the bridge.

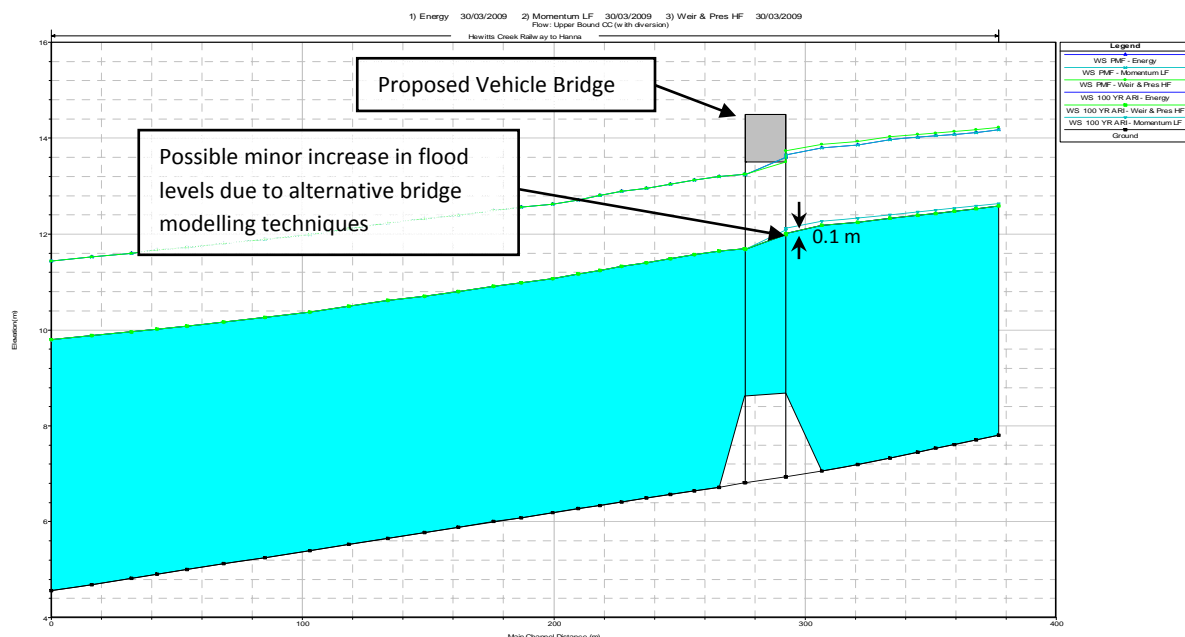


Figure 2 Comparison of Bridge Modelling Techniques for Hewitts Creek

We confirm that using alternative bridge modelling techniques does not adversely affect flood levels in Hewitts Creek. The minor increase in flood levels just upstream of the proposed vehicle bridge

during the 100 year ARI (a maximum of 0.1 m) is within the 0.5 m of freeboard incorporated into the development (above the 100 year ARI flood level) to cater for modelling uncertainties. Floor levels for all proposed dwellings should therefore be based on flood levels presented in the March 2008 Sandon Point Flood Study.

WOODLANDS CREEK

Flow through the Woodlands Creek Bridge operate under low flow conditions (i.e. channel flow) for events up to the 100 year ARI and high flow conditions for the PMF. This assessment was performed with the bridge 25% blocked and using the future upper bound climate change scenario flows.

During the 100 year ARI, when using the alternate momentum balance equation, flood surface levels on the upstream side of the vehicle bridge remain the same. It is noted that there is no change in the 100 year ARI flood levels upstream of the vehicle bridge when using the weir plus pressurised flow model configuration for high flow conditions, as the water level does not reach the underside of the bridge deck (so pressurised flow does not occur).

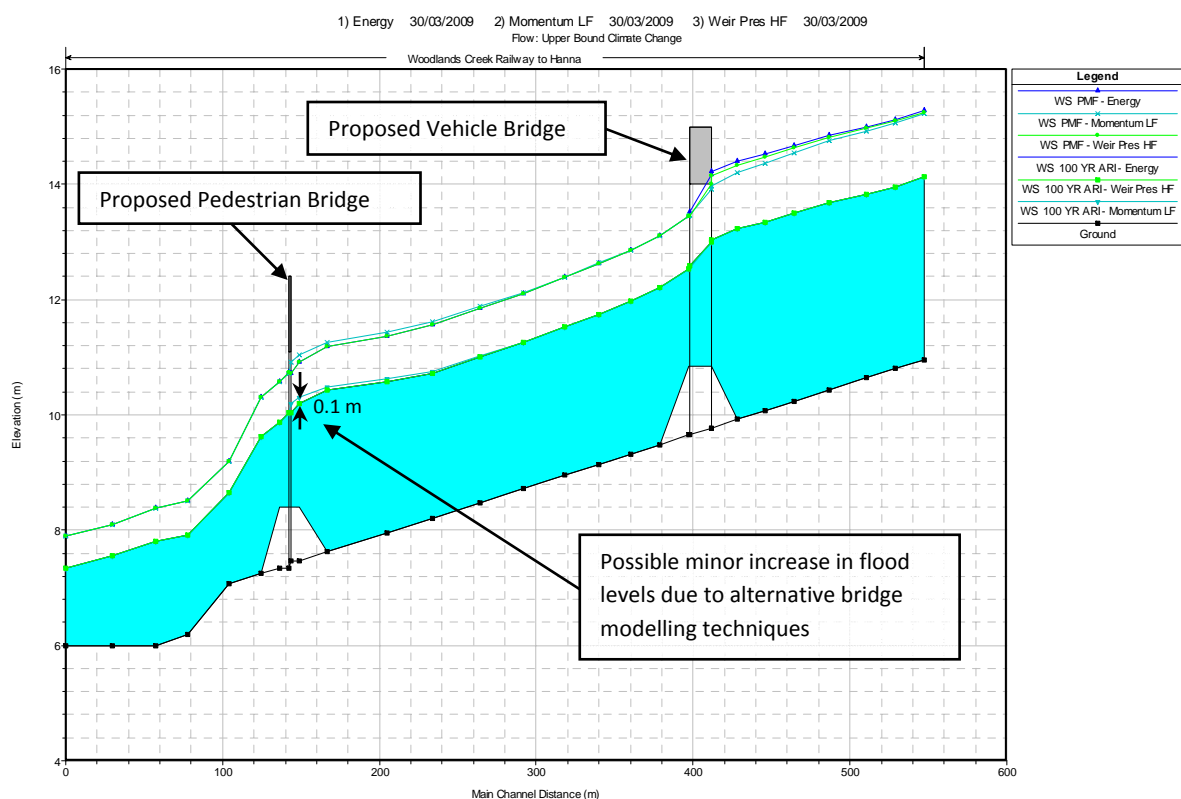


Figure 3 Comparison of Bridge Modelling Techniques for Woodlands Creek

However upstream of the proposed pedestrian bridge during the 100 year ARI when using the weir plus pressurised flow model configuration for high flow conditions, flood surface levels are lowered by up to 0.1 m. There is no change in flood levels using the momentum equation at this location.

When using the momentum balance equation method for the PMF, the resulting flood levels are up to 0.25 m lower on the upstream side of the vehicle bridge and water does not reach the underside of the bridge. Flood surface levels are also lower, using the weir plus pressurised flow model configuration for high flow conditions, by up to 0.09 m on the upstream side of the vehicle bridge.

Upstream of the pedestrian bridge, water levels are marginally higher by up to 0.11 m when using the momentum balance equation in the PMF event. No change occurs near the pedestrian bridge using the weir plus pressurised flow for high flow conditions method as the water level does not reach the underside of the bridge deck (so pressurised flow does not occur).

We confirm that using alternative bridge modelling techniques does not adversely affect flood levels in Woodlands Creek. The minor increase in flood levels during the 100 year ARI (a maximum of 0.11 m) just upstream of the pedestrian bridge is within the 0.5 m of freeboard incorporated into the development (above the 100 year ARI flood level) to cater for modelling uncertainties. Floor levels for all proposed dwellings should therefore be based on flood levels presented in the March 2008 Sandon Point Flood Study.

3.2 Beach Berm Migration

The coastal hazard assessment prepared by Cardno Lawson Treloar as part of our March 2008 Sandon Point Flood Study states that the shoreline would recede by approximately 70m to a distance of 190 m eastward of the site boundary, assuming a climate change induced sea level rise of 0.91 m by 2100. SKM have recommended we increase the level of the berm to a similar level to the magnitude of sea level rise (as this is what is believed by SKM to likely occur).

The aerial laser survey data (ALS) indicates that in 2004 the beach berm height was approximately 2.1 m AHD. Based on SKM's recommendations, berm height would reach a level of 3.0 m AHD. Figure 4 is a shade plot of Hewitts, Woodlands and Tramway Creeks with contours in 0.25 m increments which provides a good indication of where the existing beach berm is located and SKM's believed future location for the berm.

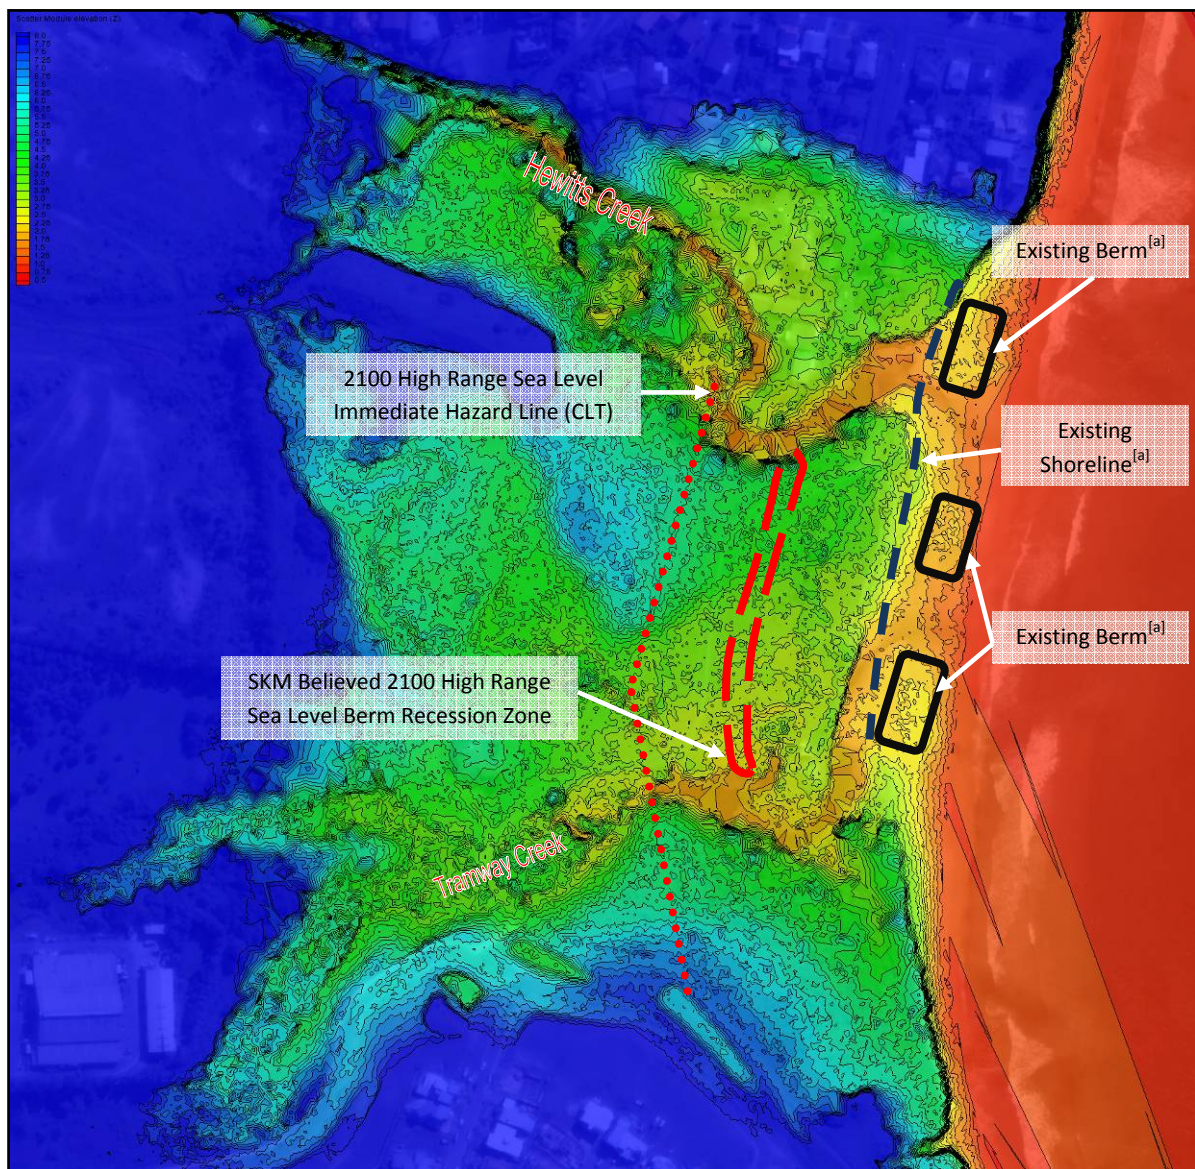


Figure 4 Shade Plot of Hewitts, Woodlands and Tramway Creeks Entrance to Ocean

The shading shown on the above figure shows change in elevation in 0.25 m increments (between black contours) up to RL +8.0 m AHD. The shade plot was constructed to determine the height and location of the existing beach berm at the time the aerial laser survey was flown on [a] 23 May 2005.



Figure 5 Photograph of Scour in Hewitts Creek Just After August 1998 Flood

The sandy bed, banks of Hewitts Creek and adjacent beach berms at the entrance to the ocean were scoured out due to the flow in Hewitts Creek. The Hewitts Creek foot bridge shown in this photograph is located 25 m upstream of McCauley's Beach and some 350 m downstream of the subject sites eastern boundary.

As recognised by SKM it is difficult to quantify effects of the inland shift of the beach berm shift and the coastal lagoon. We have formulated a conservative approach to assess any effects on flood levels that the beach berm recession may have even though the berm would likely be scoured out during a flooding event. To assess the effects of an increase in beach berm height we have performed a sensitivity analysis on the effects of increasing the downstream base levels of Hewitts Creek.

It must be noted that the hydraulic models prepared for the Sandon Point Flood Study previously were not required to extend the entire way to the ocean. Our March 2008 report identifies the boundary conditions and invert levels of the furthestmost downstream cross-section used in the HECRAS hydraulic model. The invert levels for the furthestmost downstream cross-sections for Hewitts, Woodlands and Tramway Creeks respectively are RL +4.7 m AHD, +4.6 m AHD and +2.2 m AHD.

As part of work undertaken in response to Agency queries of flood levels affecting on the downstream properties of Hewitts Creek, we extended our Hewitts Creek hydraulic model in October 2008 downstream to approximately 160 m inland of McCauley's beach. The most downstream invert level in this model was RL +1.6 m AHD located some 150 m upstream of the existing beach berms.

Conservatively adding the suggested 0.9 m to sediment levels and matching the bed slope profile to extend to the raised (or filled in areas) in the model cross sections results in a very minor effect on upstream flood levels. This is illustrated in **Figure 6** below which shows the 100 year and PMF flood levels for upper bound climate change scenario with a high range sea level rise.

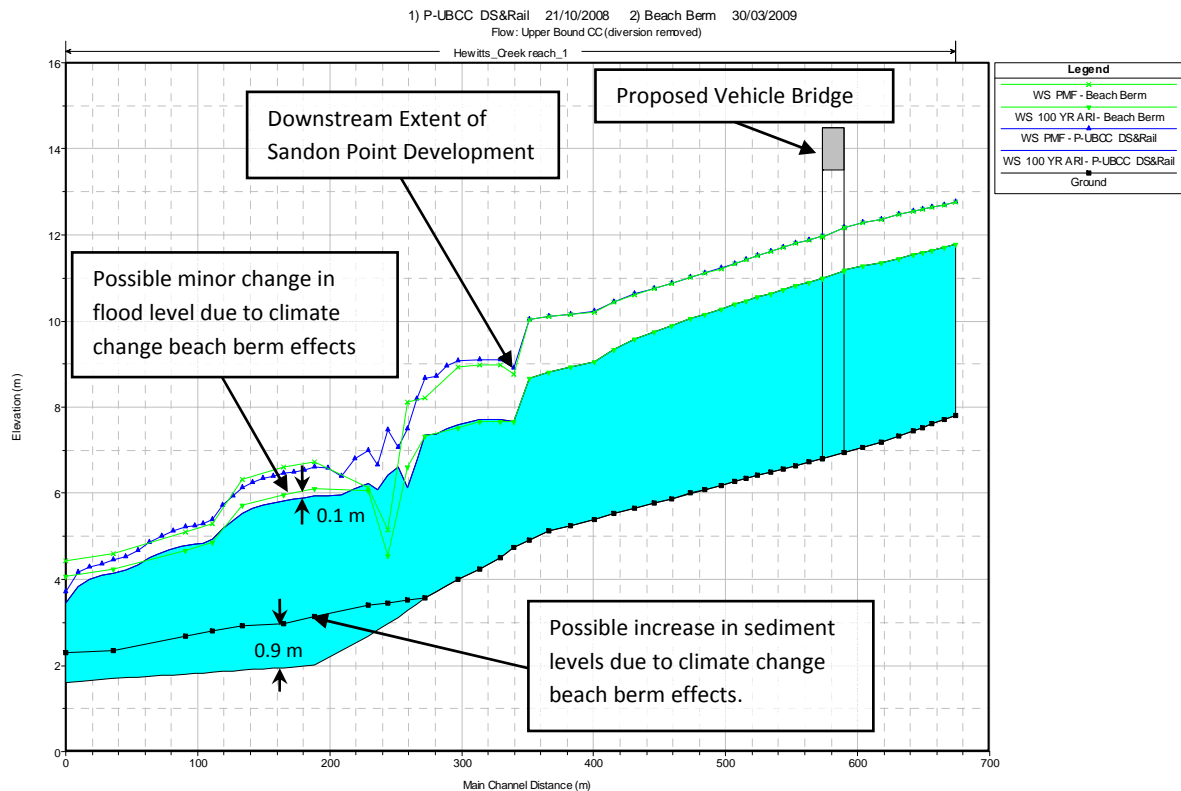


Figure 6 Conservative Climate Change Beach Berm Effects

The upper and the lower green lines denote the water surface levels at the peak of the PMF and 100 year ARI respectively for the possible upper bound climate change scenario with a raised beach berm. The upper and lower blue lines denote the water surface levels at the peak of the PMF and 100 year ARI respectively for the upper bound climate change scenario presented the March 2008 Flood Study .

Based on this conservative approach, there would be no impact on the Sandon Point development due to beach berm recession along Hewitts Creek.

Hewitts, Woodlands and Tramway Creeks have very similar morphology downstream of the railway line. Where Hewitts and Tramway Creeks discharge into the ocean across McCauley's beach, both creeks have similar existing berm profile and lagoon profiles (i.e. boundary conditions for flood modelling). It is also noted that during flooding events the two outlets discharge at analogous flow rates and offer a like cross sectional area. Further, in large flood events, any berm that did exist at either of the three creek outlets eroded well before the peak of the flood.

Therefore, we contend that any impact observed (or not) in Hewitts Creek would likely be observed (or not) in Woodlands and Tramway Creeks. As no impact from beach berm migration was observed in the modelling for Hewitts Creek, it is not likely that Woodlands and Tramway Creeks would be affected.

The Sandon point development has all floor levels for buildings located above RL +8.0 m AHD, and is well clear of any impacts associated with beach berm migration.

4 Conclusions

We conclude that:

- SKM issued their preliminary draft report on 9 December 2008, containing a suite of recommendations to the Department of Planning outlining where SKM believed further work was required. The issues related to stream stability, flooding and climate change.
- A meeting was held on 27th February 2009 at the Department of Planning, attended by representatives from the Department of Planning, Stockland, Don Fox Planning, Cardno Forbes Rigby and SKM. The purpose of this meeting was to discuss in more detail the issues SKM required addressing prior to the development approval being granted, and to attempt to settle any resolvable issues during the meeting.
- CFR tabled two different plans (see **Appendix C** of this report) showing historic geomorphic data through the site, which were at odds with SKM's position that channel failures were imminent.
- SKM issued their final Peer Review Report on 6th March which included specific 'recommended actions' to be undertaken. SKM further issued a letter dated 12 March 2009 outlining their further requirements and modified 'list of issues' after having the benefit of the site inspection.
- A joint site inspection was undertaken on 9 March 2009 attended by Anthony Barthelmess (CFR), Lih Chong (SKM) and Peter Sandercock (SKM). The historical geomorphic data extracted from the previous Hewitts Creek studies was discussed with SKM showing how the site, and the catchment, had responded geomorphically to various historic flood events.
- All 'recommended actions' arising from SKM's Peer Review report dated 6 March 2009 have been addressed by this addendum;
- All 'other issues' arising from SKM's letter dated 12 March 2009 have been addressed by this addendum;
- All matters relating to climate change have been addressed the CFR Climate Change Assessment report (March 2008) and this Addendum.
- All matters relating to flooding have been addressed the CFR Climate Change Assessment report (March 2008) and this Addendum.
- All matters relating to stream stability have been addressed the CFR Climate Change Assessment report (March 2008) and this Addendum.
- The use of alternative bridge modelling techniques does not adversely affect flood levels. The minor increase in flood levels during the 100 year ARI is a maximum of 0.11 m and is within the 0.5 m of freeboard incorporated into the development (above the 100 year ARI flood level) to cater for modelling uncertainties.
- Floor levels for all proposed dwellings should therefore be based on flood levels presented in the March 2008 Sandon Point Flood Study.
- The Sandon point development has all floor levels for buildings located above RL +8.0 m AHD, and is well clear of any impacts associated with beach berm migration.

References

USACE, US Army Corps of Engineers (2004), HEC-RAS River Analysis System: Hydraulic Reference Manual, Version 4.0, March 2008, Hydraulic Engineering Center, CPD-69

Annex A

A. Hydraulic Model Results

Summary Output Tables for Alternate Bridge Modelling Approaches

Hewitts Creek

| Reach | River Sta | Profile | Plan | Q Total (m ³ /s) | Min Ch El (m) | W.S. Elev (m) | Crit W.S. (m) | E.G. Elev (m) | E.G. Slope (m/m) | Vel Chnl (m/s) | Flow Area (m ²) | Top Width (m) | Froude # Chl |
|------------------|-----------|------------|----------------|--------------------------------|------------------|------------------|------------------|------------------|---------------------|-------------------|--------------------------------|------------------|-----------------|
| Railway to Hanna | 416.951 | 100 YR ARI | Energy | 150.68 | 7.80 | 12.59 | 10.91 | 12.78 | 0.008302 | 2.04 | 85.31 | 35.05 | 0.35 |
| Railway to Hanna | 416.951 | 100 YR ARI | Momentum LF | 150.68 | 7.80 | 12.64 | 10.91 | 12.83 | 0.007838 | 2.00 | 87.24 | 35.45 | 0.34 |
| Railway to Hanna | 416.951 | 100 YR ARI | Weir & Pres HF | 150.68 | 7.80 | 12.59 | 10.91 | 12.78 | 0.008302 | 2.04 | 85.31 | 35.05 | 0.35 |
| Railway to Hanna | 416.951 | PMF | Energy | 305.80 | 7.80 | 14.18 | 12.03 | 14.48 | 0.008207 | 2.60 | 150.40 | 46.74 | 0.37 |
| Railway to Hanna | 416.951 | PMF | Momentum LF | 305.80 | 7.80 | 14.18 | 12.03 | 14.48 | 0.008207 | 2.60 | 150.40 | 46.74 | 0.37 |
| Railway to Hanna | 416.951 | PMF | Weir & Pres HF | 305.80 | 7.80 | 14.23 | 12.03 | 14.52 | 0.007880 | 2.57 | 152.90 | 47.13 | 0.36 |
| Railway to Hanna | 408.012 | 100 YR ARI | Energy | 150.68 | 7.71 | 12.52 | | 12.71 | 0.007696 | 1.97 | 88.21 | 36.13 | 0.34 |
| Railway to Hanna | 408.012 | 100 YR ARI | Momentum LF | 150.68 | 7.71 | 12.58 | | 12.76 | 0.007237 | 1.93 | 90.35 | 36.58 | 0.33 |
| Railway to Hanna | 408.012 | 100 YR ARI | Weir & Pres HF | 150.68 | 7.71 | 12.52 | | 12.71 | 0.007696 | 1.97 | 88.21 | 36.13 | 0.34 |
| Railway to Hanna | 408.012 | PMF | Energy | 305.80 | 7.71 | 14.12 | | 14.40 | 0.007604 | 2.51 | 155.52 | 48.10 | 0.35 |
| Railway to Hanna | 408.012 | PMF | Momentum LF | 305.80 | 7.71 | 14.12 | | 14.40 | 0.007604 | 2.51 | 155.52 | 48.10 | 0.35 |
| Railway to Hanna | 408.012 | PMF | Weir & Pres HF | 305.80 | 7.71 | 14.18 | | 14.45 | 0.007286 | 2.48 | 158.22 | 48.52 | 0.35 |
| Railway to Hanna | 399.203 | 100 YR ARI | Energy | 150.68 | 7.61 | 12.48 | | 12.64 | 0.006616 | 1.85 | 94.23 | 37.86 | 0.31 |
| Railway to Hanna | 399.203 | 100 YR ARI | Momentum LF | 150.68 | 7.61 | 12.54 | | 12.69 | 0.006207 | 1.82 | 96.60 | 38.33 | 0.30 |
| Railway to Hanna | 399.203 | 100 YR ARI | Weir & Pres HF | 150.68 | 7.61 | 12.48 | | 12.64 | 0.006616 | 1.85 | 94.23 | 37.86 | 0.31 |
| Railway to Hanna | 399.203 | PMF | Energy | 305.80 | 7.61 | 14.08 | | 14.33 | 0.006636 | 2.38 | 164.97 | 49.66 | 0.33 |
| Railway to Hanna | 399.203 | PMF | Momentum LF | 305.80 | 7.61 | 14.08 | | 14.33 | 0.006636 | 2.38 | 164.97 | 49.66 | 0.33 |
| Railway to Hanna | 399.203 | PMF | Weir & Pres HF | 305.80 | 7.61 | 14.14 | | 14.38 | 0.006349 | 2.34 | 167.87 | 49.99 | 0.33 |
| Railway to Hanna | 391.774 | 100 YR ARI | Energy | 150.68 | 7.53 | 12.43 | | 12.59 | 0.006431 | 1.82 | 97.12 | 41.41 | 0.31 |
| Railway to Hanna | 391.774 | 100 YR ARI | Momentum LF | 150.68 | 7.53 | 12.50 | | 12.65 | 0.005996 | 1.78 | 99.86 | 41.79 | 0.30 |
| Railway to Hanna | 391.774 | 100 YR ARI | Weir & Pres HF | 150.68 | 7.53 | 12.43 | | 12.59 | 0.006431 | 1.82 | 97.12 | 41.41 | 0.31 |
| Railway to Hanna | 391.774 | PMF | Energy | 305.80 | 7.53 | 14.05 | | 14.28 | 0.006112 | 2.28 | 172.98 | 50.46 | 0.32 |
| Railway to Hanna | 391.774 | PMF | Momentum LF | 305.80 | 7.53 | 14.05 | | 14.28 | 0.006112 | 2.28 | 172.98 | 50.46 | 0.32 |
| Railway to Hanna | 391.774 | PMF | Weir & Pres HF | 305.80 | 7.53 | 14.11 | | 14.33 | 0.005837 | 2.24 | 176.01 | 50.61 | 0.31 |
| Railway to Hanna | 384.639 | 100 YR ARI | Energy | 150.68 | 7.45 | 12.39 | | 12.54 | 0.006114 | 1.77 | 101.20 | 44.66 | 0.30 |
| Railway to Hanna | 384.639 | 100 YR ARI | Momentum LF | 150.68 | 7.45 | 12.46 | | 12.60 | 0.005671 | 1.73 | 104.29 | 44.94 | 0.29 |
| Railway to Hanna | 384.639 | 100 YR ARI | Weir & Pres HF | 150.68 | 7.45 | 12.39 | | 12.54 | 0.006114 | 1.77 | 101.20 | 44.66 | 0.30 |
| Railway to Hanna | 384.639 | PMF | Energy | 305.80 | 7.45 | 14.02 | | 14.23 | 0.005717 | 2.20 | 179.48 | 51.69 | 0.31 |
| Railway to Hanna | 384.639 | PMF | Momentum LF | 305.80 | 7.45 | 14.02 | | 14.23 | 0.005717 | 2.20 | 179.48 | 51.69 | 0.31 |
| Railway to Hanna | 384.639 | PMF | Weir & Pres HF | 305.80 | 7.45 | 14.08 | | 14.28 | 0.005454 | 2.17 | 182.67 | 51.89 | 0.30 |
| Railway to Hanna | 373.531 | 100 YR ARI | Energy | 150.68 | 7.33 | 12.33 | | 12.47 | 0.005626 | 1.71 | 104.27 | 45.28 | 0.29 |
| Railway to Hanna | 373.531 | 100 YR ARI | Momentum LF | 150.68 | 7.33 | 12.41 | | 12.54 | 0.005202 | 1.67 | 107.62 | 45.78 | 0.28 |
| Railway to Hanna | 373.531 | 100 YR ARI | Weir & Pres HF | 150.68 | 7.33 | 12.33 | | 12.47 | 0.005626 | 1.71 | 104.27 | 45.28 | 0.29 |
| Railway to Hanna | 373.531 | PMF | Energy | 305.80 | 7.33 | 13.97 | | 14.16 | 0.005295 | 2.13 | 186.75 | 54.75 | 0.30 |
| Railway to Hanna | 373.531 | PMF | Momentum LF | 305.80 | 7.33 | 13.97 | | 14.16 | 0.005295 | 2.13 | 186.75 | 54.75 | 0.30 |
| Railway to Hanna | 373.531 | PMF | Weir & Pres HF | 305.80 | 7.33 | 14.03 | | 14.22 | 0.005040 | 2.10 | 190.29 | 54.94 | 0.29 |
| Railway to Hanna | 360.818 | 100 YR ARI | Energy | 150.68 | 7.19 | 12.25 | | 12.40 | 0.006101 | 1.76 | 97.34 | 39.68 | 0.30 |
| Railway to Hanna | 360.818 | 100 YR ARI | Momentum LF | 150.68 | 7.19 | 12.33 | | 12.47 | 0.005621 | 1.72 | 100.55 | 40.58 | 0.29 |

| Reach | River Sta | Profile | Plan | Q Total | Min Ch El | W.S. Elev | Crit W.S. | E.G. Elev | E.G. Slope | Vel Chnl | Flow Area | Top Width | Froude # Chl |
|------------------|-----------|------------|----------------|---------|-----------|-----------|-----------|-----------|------------|----------|-----------|-----------|--------------|
| Railway to Hanna | 360.818 | 100 YR ARI | Weir & Pres HF | 150.68 | 7.19 | 12.25 | | 12.40 | 0.006101 | 1.76 | 97.34 | 39.68 | 0.30 |
| Railway to Hanna | 360.818 | PMF | Energy | 305.80 | 7.19 | 13.86 | | 14.09 | 0.005999 | 2.25 | 172.08 | 50.90 | 0.32 |
| Railway to Hanna | 360.818 | PMF | Momentum LF | 305.80 | 7.19 | 13.86 | | 14.09 | 0.005999 | 2.25 | 172.08 | 50.90 | 0.32 |
| Railway to Hanna | 360.818 | PMF | Weir & Pres HF | 305.80 | 7.19 | 13.93 | | 14.15 | 0.005685 | 2.21 | 175.65 | 51.01 | 0.31 |
| Railway to Hanna | 346.505 | 100 YR ARI | Energy | 150.68 | 7.06 | 12.18 | | 12.31 | 0.005022 | 1.68 | 105.40 | 40.65 | 0.28 |
| Railway to Hanna | 346.505 | 100 YR ARI | Momentum LF | 150.68 | 7.06 | 12.27 | | 12.39 | 0.004623 | 1.64 | 108.92 | 41.55 | 0.27 |
| Railway to Hanna | 346.505 | 100 YR ARI | Weir & Pres HF | 150.68 | 7.06 | 12.18 | | 12.31 | 0.005022 | 1.68 | 105.40 | 40.65 | 0.28 |
| Railway to Hanna | 346.505 | PMF | Energy | 305.80 | 7.06 | 13.80 | | 14.00 | 0.005303 | 2.19 | 180.26 | 49.86 | 0.30 |
| Railway to Hanna | 346.505 | PMF | Momentum LF | 305.80 | 7.06 | 13.80 | | 14.00 | 0.005303 | 2.19 | 180.26 | 49.86 | 0.30 |
| Railway to Hanna | 346.505 | PMF | Weir & Pres HF | 305.80 | 7.06 | 13.87 | | 14.07 | 0.005022 | 2.15 | 183.93 | 49.86 | 0.29 |
| Railway to Hanna | 332.230 | 100 YR ARI | Energy | 150.68 | 8.69 | 12.01 | 10.63 | 12.21 | 0.009533 | 2.07 | 86.38 | 38.66 | 0.37 |
| Railway to Hanna | 332.230 | 100 YR ARI | Momentum LF | 150.68 | 8.69 | 12.12 | 10.63 | 12.30 | 0.008446 | 1.99 | 90.45 | 39.45 | 0.35 |
| Railway to Hanna | 332.230 | 100 YR ARI | Weir & Pres HF | 150.68 | 8.69 | 12.01 | 10.63 | 12.21 | 0.009533 | 2.07 | 86.38 | 38.66 | 0.37 |
| Railway to Hanna | 332.230 | PMF | Energy | 305.80 | 8.69 | 13.65 | 11.64 | 13.91 | 0.007804 | 2.47 | 161.39 | 49.52 | 0.36 |
| Railway to Hanna | 332.230 | PMF | Momentum LF | 305.80 | 8.69 | 13.65 | 11.64 | 13.91 | 0.007804 | 2.47 | 161.39 | 49.52 | 0.36 |
| Railway to Hanna | 332.230 | PMF | Weir & Pres HF | 305.80 | 8.69 | 13.73 | 11.64 | 13.98 | 0.007273 | 2.42 | 165.58 | 49.52 | 0.35 |
| Railway to Hanna | 324 | | Bridge | | | | | | | | | | |
| Railway to Hanna | 315.928 | 100 YR ARI | Energy | 150.68 | 8.62 | 11.70 | | 11.93 | 0.012163 | 2.19 | 80.16 | 40.36 | 0.41 |
| Railway to Hanna | 315.928 | 100 YR ARI | Momentum LF | 150.68 | 8.62 | 11.70 | | 11.93 | 0.012163 | 2.19 | 80.16 | 40.36 | 0.41 |
| Railway to Hanna | 315.928 | 100 YR ARI | Weir & Pres HF | 150.68 | 8.62 | 11.70 | | 11.93 | 0.012163 | 2.19 | 80.16 | 40.36 | 0.41 |
| Railway to Hanna | 315.928 | PMF | Energy | 305.80 | 8.62 | 13.25 | | 13.54 | 0.009459 | 2.58 | 150.93 | 49.27 | 0.39 |
| Railway to Hanna | 315.928 | PMF | Momentum LF | 305.80 | 8.62 | 13.25 | | 13.54 | 0.009459 | 2.58 | 150.93 | 49.27 | 0.39 |
| Railway to Hanna | 315.928 | PMF | Weir & Pres HF | 305.80 | 8.62 | 13.25 | | 13.54 | 0.009459 | 2.58 | 150.93 | 49.27 | 0.39 |
| Railway to Hanna | 305.563 | 100 YR ARI | Energy | 150.68 | 6.72 | 11.65 | | 11.81 | 0.006970 | 1.86 | 93.58 | 40.91 | 0.32 |
| Railway to Hanna | 305.563 | 100 YR ARI | Momentum LF | 150.68 | 6.72 | 11.65 | | 11.81 | 0.006970 | 1.86 | 93.58 | 40.91 | 0.32 |
| Railway to Hanna | 305.563 | 100 YR ARI | Weir & Pres HF | 150.68 | 6.72 | 11.65 | | 11.81 | 0.006970 | 1.86 | 93.58 | 40.91 | 0.32 |
| Railway to Hanna | 305.563 | PMF | Energy | 305.80 | 6.72 | 13.20 | | 13.45 | 0.006879 | 2.37 | 164.20 | 48.99 | 0.34 |
| Railway to Hanna | 305.563 | PMF | Momentum LF | 305.80 | 6.72 | 13.20 | | 13.45 | 0.006879 | 2.37 | 164.20 | 48.99 | 0.34 |
| Railway to Hanna | 305.563 | PMF | Weir & Pres HF | 305.80 | 6.72 | 13.20 | | 13.45 | 0.006879 | 2.37 | 164.20 | 48.99 | 0.34 |
| Railway to Hanna | 295.821 | 100 YR ARI | Energy | 150.68 | 6.64 | 11.58 | | 11.75 | 0.007105 | 1.86 | 92.18 | 40.55 | 0.32 |
| Railway to Hanna | 295.821 | 100 YR ARI | Momentum LF | 150.68 | 6.64 | 11.58 | | 11.75 | 0.007105 | 1.86 | 92.18 | 40.55 | 0.32 |
| Railway to Hanna | 295.821 | 100 YR ARI | Weir & Pres HF | 150.68 | 6.64 | 11.58 | | 11.75 | 0.007105 | 1.86 | 92.18 | 40.55 | 0.32 |
| Railway to Hanna | 295.821 | PMF | Energy | 305.80 | 6.64 | 13.13 | | 13.38 | 0.006965 | 2.36 | 162.09 | 48.45 | 0.34 |
| Railway to Hanna | 295.821 | PMF | Momentum LF | 305.80 | 6.64 | 13.13 | | 13.38 | 0.006965 | 2.36 | 162.09 | 48.45 | 0.34 |
| Railway to Hanna | 295.821 | PMF | Weir & Pres HF | 305.80 | 6.64 | 13.13 | | 13.38 | 0.006965 | 2.36 | 162.09 | 48.45 | 0.34 |
| Railway to Hanna | 286.355 | 100 YR ARI | Energy | 150.68 | 6.57 | 11.49 | | 11.67 | 0.007971 | 1.93 | 87.85 | 39.92 | 0.34 |
| Railway to Hanna | 286.355 | 100 YR ARI | Momentum LF | 150.68 | 6.57 | 11.49 | | 11.67 | 0.007971 | 1.93 | 87.85 | 39.92 | 0.34 |
| Railway to Hanna | 286.355 | 100 YR ARI | Weir & Pres HF | 150.68 | 6.57 | 11.49 | | 11.67 | 0.007971 | 1.93 | 87.85 | 39.92 | 0.34 |
| Railway to Hanna | 286.355 | PMF | Energy | 305.80 | 6.57 | 13.05 | | 13.31 | 0.007579 | 2.42 | 156.89 | 48.29 | 0.35 |
| Railway to Hanna | 286.355 | PMF | Momentum LF | 305.80 | 6.57 | 13.05 | | 13.31 | 0.007579 | 2.42 | 156.89 | 48.29 | 0.35 |
| Railway to Hanna | 286.355 | PMF | Weir & Pres HF | 305.80 | 6.57 | 13.05 | | 13.31 | 0.007579 | 2.42 | 156.89 | 48.29 | 0.35 |
| Railway to Hanna | 276.823 | 100 YR ARI | Energy | 150.68 | 6.49 | 11.40 | | 11.59 | 0.008679 | 2.00 | 84.81 | 40.25 | 0.35 |
| Railway to Hanna | 276.823 | 100 YR ARI | Momentum LF | 150.68 | 6.49 | 11.40 | | 11.59 | 0.008679 | 2.00 | 84.81 | 40.25 | 0.35 |

| Reach | River Sta | Profile | Plan | Q Total | Min Ch El | W.S. Elev | Crit W.S. | E.G. Elev | E.G. Slope | Vel Chnl | Flow Area | Top Width | Froude # Chl |
|------------------|-----------|------------|----------------|---------|-----------|-----------|-----------|-----------|------------|----------|-----------|-----------|--------------|
| Railway to Hanna | 276.823 | 100 YR ARI | Weir & Pres HF | 150.68 | 6.49 | 11.40 | | 11.59 | 0.008679 | 2.00 | 84.81 | 40.25 | 0.35 |
| Railway to Hanna | 276.823 | PMF | Energy | 305.80 | 6.49 | 12.96 | | 13.24 | 0.007984 | 2.48 | 155.02 | 48.69 | 0.36 |
| Railway to Hanna | 276.823 | PMF | Momentum LF | 305.80 | 6.49 | 12.96 | | 13.24 | 0.007984 | 2.48 | 155.02 | 48.69 | 0.36 |
| Railway to Hanna | 276.823 | PMF | Weir & Pres HF | 305.80 | 6.49 | 12.96 | | 13.24 | 0.007984 | 2.48 | 155.02 | 48.69 | 0.36 |
| Railway to Hanna | 266.862 | 100 YR ARI | Energy | 150.68 | 6.41 | 11.32 | | 11.51 | 0.007796 | 1.95 | 88.04 | 41.25 | 0.34 |
| Railway to Hanna | 266.862 | 100 YR ARI | Momentum LF | 150.68 | 6.41 | 11.32 | | 11.51 | 0.007796 | 1.95 | 88.04 | 41.25 | 0.34 |
| Railway to Hanna | 266.862 | 100 YR ARI | Weir & Pres HF | 150.68 | 6.41 | 11.32 | | 11.51 | 0.007796 | 1.95 | 88.04 | 41.25 | 0.34 |
| Railway to Hanna | 266.862 | PMF | Energy | 305.80 | 6.41 | 12.89 | | 13.16 | 0.007383 | 2.44 | 159.95 | 49.82 | 0.35 |
| Railway to Hanna | 266.862 | PMF | Momentum LF | 305.80 | 6.41 | 12.89 | | 13.16 | 0.007383 | 2.44 | 159.95 | 49.82 | 0.35 |
| Railway to Hanna | 266.862 | PMF | Weir & Pres HF | 305.80 | 6.41 | 12.89 | | 13.16 | 0.007383 | 2.44 | 159.95 | 49.82 | 0.35 |
| Railway to Hanna | 258.198 | 100 YR ARI | Energy | 150.68 | 6.34 | 11.24 | | 11.44 | 0.008162 | 1.99 | 85.41 | 39.80 | 0.34 |
| Railway to Hanna | 258.198 | 100 YR ARI | Momentum LF | 150.68 | 6.34 | 11.24 | | 11.44 | 0.008162 | 1.99 | 85.41 | 39.80 | 0.34 |
| Railway to Hanna | 258.198 | 100 YR ARI | Weir & Pres HF | 150.68 | 6.34 | 11.24 | | 11.44 | 0.008162 | 1.99 | 85.41 | 39.80 | 0.34 |
| Railway to Hanna | 258.198 | PMF | Energy | 305.80 | 6.34 | 12.81 | | 13.09 | 0.007783 | 2.50 | 156.46 | 50.04 | 0.36 |
| Railway to Hanna | 258.198 | PMF | Momentum LF | 305.80 | 6.34 | 12.81 | | 13.09 | 0.007783 | 2.50 | 156.46 | 50.04 | 0.36 |
| Railway to Hanna | 258.198 | PMF | Weir & Pres HF | 305.80 | 6.34 | 12.81 | | 13.09 | 0.007783 | 2.50 | 156.46 | 50.04 | 0.36 |
| Railway to Hanna | 249.723 | 100 YR ARI | Energy | 150.68 | 6.27 | 11.16 | | 11.37 | 0.008661 | 2.02 | 82.04 | 37.17 | 0.35 |
| Railway to Hanna | 249.723 | 100 YR ARI | Momentum LF | 150.68 | 6.27 | 11.16 | | 11.37 | 0.008661 | 2.02 | 82.04 | 37.17 | 0.35 |
| Railway to Hanna | 249.723 | 100 YR ARI | Weir & Pres HF | 150.68 | 6.27 | 11.16 | | 11.37 | 0.008661 | 2.02 | 82.04 | 37.17 | 0.35 |
| Railway to Hanna | 249.723 | PMF | Energy | 305.80 | 6.27 | 12.71 | | 13.02 | 0.008448 | 2.57 | 148.40 | 48.50 | 0.37 |
| Railway to Hanna | 249.723 | PMF | Momentum LF | 305.80 | 6.27 | 12.71 | | 13.02 | 0.008448 | 2.57 | 148.40 | 48.50 | 0.37 |
| Railway to Hanna | 249.723 | PMF | Weir & Pres HF | 305.80 | 6.27 | 12.71 | | 13.02 | 0.008448 | 2.57 | 148.40 | 48.50 | 0.37 |
| Railway to Hanna | 239.532 | 100 YR ARI | Energy | 150.68 | 6.19 | 11.07 | | 11.27 | 0.009291 | 1.99 | 79.25 | 32.16 | 0.36 |
| Railway to Hanna | 239.532 | 100 YR ARI | Momentum LF | 150.68 | 6.19 | 11.07 | | 11.27 | 0.009291 | 1.99 | 79.25 | 32.16 | 0.36 |
| Railway to Hanna | 239.532 | 100 YR ARI | Weir & Pres HF | 150.68 | 6.19 | 11.07 | | 11.27 | 0.009291 | 1.99 | 79.25 | 32.16 | 0.36 |
| Railway to Hanna | 239.532 | PMF | Energy | 305.80 | 6.19 | 12.63 | | 12.93 | 0.008699 | 2.52 | 144.52 | 48.03 | 0.37 |
| Railway to Hanna | 239.532 | PMF | Momentum LF | 305.80 | 6.19 | 12.63 | | 12.93 | 0.008699 | 2.52 | 144.52 | 48.03 | 0.37 |
| Railway to Hanna | 239.532 | PMF | Weir & Pres HF | 305.80 | 6.19 | 12.63 | | 12.93 | 0.008699 | 2.52 | 144.52 | 48.03 | 0.37 |
| Railway to Hanna | 226.906 | 100 YR ARI | Energy | 150.68 | 6.08 | 10.99 | | 11.16 | 0.007550 | 1.83 | 88.41 | 38.48 | 0.33 |
| Railway to Hanna | 226.906 | 100 YR ARI | Momentum LF | 150.68 | 6.08 | 10.99 | | 11.16 | 0.007550 | 1.83 | 88.41 | 38.48 | 0.33 |
| Railway to Hanna | 226.906 | 100 YR ARI | Weir & Pres HF | 150.68 | 6.08 | 10.99 | | 11.16 | 0.007550 | 1.83 | 88.41 | 38.48 | 0.33 |
| Railway to Hanna | 226.906 | PMF | Energy | 305.80 | 6.08 | 12.56 | | 12.81 | 0.007106 | 2.32 | 157.28 | 48.73 | 0.34 |
| Railway to Hanna | 226.906 | PMF | Momentum LF | 305.80 | 6.08 | 12.56 | | 12.81 | 0.007106 | 2.32 | 157.28 | 48.73 | 0.34 |
| Railway to Hanna | 226.906 | PMF | Weir & Pres HF | 305.80 | 6.08 | 12.56 | | 12.81 | 0.007106 | 2.32 | 157.28 | 48.73 | 0.34 |
| Railway to Hanna | 215.941 | 100 YR ARI | Energy | 150.68 | 6.00 | 10.91 | | 11.07 | 0.007446 | 1.81 | 89.47 | 38.88 | 0.32 |
| Railway to Hanna | 215.941 | 100 YR ARI | Momentum LF | 150.68 | 6.00 | 10.91 | | 11.07 | 0.007446 | 1.81 | 89.47 | 38.88 | 0.32 |
| Railway to Hanna | 215.941 | 100 YR ARI | Weir & Pres HF | 150.68 | 6.00 | 10.91 | | 11.07 | 0.007446 | 1.81 | 89.47 | 38.88 | 0.32 |
| Railway to Hanna | 215.941 | PMF | Energy | 305.80 | 6.00 | 12.49 | | 12.73 | 0.006885 | 2.27 | 159.97 | 50.03 | 0.33 |
| Railway to Hanna | 215.941 | PMF | Momentum LF | 305.80 | 6.00 | 12.49 | | 12.73 | 0.006885 | 2.27 | 159.97 | 50.03 | 0.33 |
| Railway to Hanna | 215.941 | PMF | Weir & Pres HF | 305.80 | 6.00 | 12.49 | | 12.73 | 0.006885 | 2.27 | 159.97 | 50.03 | 0.33 |
| Railway to Hanna | 201.805 | 100 YR ARI | Energy | 150.68 | 5.88 | 10.80 | | 10.97 | 0.007936 | 1.81 | 87.59 | 38.15 | 0.33 |
| Railway to Hanna | 201.805 | 100 YR ARI | Momentum LF | 150.68 | 5.88 | 10.80 | | 10.97 | 0.007936 | 1.81 | 87.59 | 38.15 | 0.33 |
| Railway to Hanna | 201.805 | 100 YR ARI | Weir & Pres HF | 150.68 | 5.88 | 10.80 | | 10.97 | 0.007936 | 1.81 | 87.59 | 38.15 | 0.33 |
| Railway to | 201.805 | PMF | Energy | 305.80 | 5.88 | 12.39 | | 12.64 | 0.007079 | 2.27 | 158.03 | 50.35 | 0.34 |

| Reach | River Sta | Profile | Plan | Q Total | Min Ch El | W.S. Elev | Crit W.S. | E.G. Elev | E.G. Slope | Vel Chnl | Flow Area | Top Width | Froude # Chl |
|------------------|-----------|------------|----------------|---------|-----------|-----------|-----------|-----------|------------|----------|-----------|-----------|--------------|
| Hanna | | | | | | | | | | | | | |
| Railway to Hanna | 201.805 | PMF | Momentum LF | 305.80 | 5.88 | 12.39 | | 12.64 | 0.007079 | 2.27 | 158.03 | 50.35 | 0.34 |
| Railway to Hanna | 201.805 | PMF | Weir & Pres HF | 305.80 | 5.88 | 12.39 | | 12.64 | 0.007079 | 2.27 | 158.03 | 50.35 | 0.34 |
| Railway to Hanna | 188.580 | 100 YR ARI | Energy | 150.68 | 5.77 | 10.71 | | 10.86 | 0.007221 | 1.76 | 90.73 | 39.28 | 0.32 |
| Railway to Hanna | 188.580 | 100 YR ARI | Momentum LF | 150.68 | 5.77 | 10.71 | | 10.86 | 0.007221 | 1.76 | 90.73 | 39.28 | 0.32 |
| Railway to Hanna | 188.580 | 100 YR ARI | Weir & Pres HF | 150.68 | 5.77 | 10.71 | | 10.86 | 0.007221 | 1.76 | 90.73 | 39.28 | 0.32 |
| Railway to Hanna | 188.580 | PMF | Energy | 305.80 | 5.77 | 12.31 | | 12.54 | 0.006529 | 2.20 | 163.24 | 51.33 | 0.32 |
| Railway to Hanna | 188.580 | PMF | Momentum LF | 305.80 | 5.77 | 12.31 | | 12.54 | 0.006529 | 2.20 | 163.24 | 51.33 | 0.32 |
| Railway to Hanna | 188.580 | PMF | Weir & Pres HF | 305.80 | 5.77 | 12.31 | | 12.54 | 0.006529 | 2.20 | 163.24 | 51.33 | 0.32 |
| Railway to Hanna | 173.814 | 100 YR ARI | Energy | 150.68 | 5.65 | 10.61 | | 10.76 | 0.006629 | 1.69 | 94.17 | 40.37 | 0.31 |
| Railway to Hanna | 173.814 | 100 YR ARI | Momentum LF | 150.68 | 5.65 | 10.61 | | 10.76 | 0.006629 | 1.69 | 94.17 | 40.37 | 0.31 |
| Railway to Hanna | 173.814 | 100 YR ARI | Weir & Pres HF | 150.68 | 5.65 | 10.61 | | 10.76 | 0.006629 | 1.69 | 94.17 | 40.37 | 0.31 |
| Railway to Hanna | 173.814 | PMF | Energy | 305.80 | 5.65 | 12.23 | | 12.45 | 0.005987 | 2.12 | 167.77 | 50.46 | 0.31 |
| Railway to Hanna | 173.814 | PMF | Momentum LF | 305.80 | 5.65 | 12.23 | | 12.45 | 0.005987 | 2.12 | 167.77 | 50.46 | 0.31 |
| Railway to Hanna | 173.814 | PMF | Weir & Pres HF | 305.80 | 5.65 | 12.23 | | 12.45 | 0.005987 | 2.12 | 167.77 | 50.46 | 0.31 |
| Railway to Hanna | 158.201 | 100 YR ARI | Energy | 150.68 | 5.53 | 10.49 | | 10.65 | 0.006983 | 1.77 | 90.77 | 37.71 | 0.31 |
| Railway to Hanna | 158.201 | 100 YR ARI | Momentum LF | 150.68 | 5.53 | 10.49 | | 10.65 | 0.006983 | 1.77 | 90.77 | 37.71 | 0.31 |
| Railway to Hanna | 158.201 | 100 YR ARI | Weir & Pres HF | 150.68 | 5.53 | 10.49 | | 10.65 | 0.006983 | 1.77 | 90.77 | 37.71 | 0.31 |
| Railway to Hanna | 158.201 | PMF | Energy | 305.80 | 5.53 | 12.11 | | 12.35 | 0.006492 | 2.24 | 161.57 | 49.68 | 0.33 |
| Railway to Hanna | 158.201 | PMF | Momentum LF | 305.80 | 5.53 | 12.11 | | 12.35 | 0.006492 | 2.24 | 161.57 | 49.68 | 0.33 |
| Railway to Hanna | 158.201 | PMF | Weir & Pres HF | 305.80 | 5.53 | 12.11 | | 12.35 | 0.006492 | 2.24 | 161.57 | 49.68 | 0.33 |
| Railway to Hanna | 142.886 | 100 YR ARI | Energy | 151.23 | 5.40 | 10.38 | | 10.54 | 0.007290 | 1.81 | 89.48 | 38.54 | 0.32 |
| Railway to Hanna | 142.886 | 100 YR ARI | Momentum LF | 151.23 | 5.40 | 10.38 | | 10.54 | 0.007290 | 1.81 | 89.48 | 38.54 | 0.32 |
| Railway to Hanna | 142.886 | 100 YR ARI | Weir & Pres HF | 151.23 | 5.40 | 10.38 | | 10.54 | 0.007290 | 1.81 | 89.48 | 38.54 | 0.32 |
| Railway to Hanna | 142.886 | PMF | Energy | 314.31 | 5.40 | 11.98 | | 12.24 | 0.007094 | 2.34 | 160.24 | 49.65 | 0.34 |
| Railway to Hanna | 142.886 | PMF | Momentum LF | 314.31 | 5.40 | 11.98 | | 12.24 | 0.007094 | 2.34 | 160.24 | 49.65 | 0.34 |
| Railway to Hanna | 142.886 | PMF | Weir & Pres HF | 314.31 | 5.40 | 11.98 | | 12.24 | 0.007094 | 2.34 | 160.24 | 49.65 | 0.34 |
| Railway to Hanna | 124.955 | 100 YR ARI | Energy | 151.23 | 5.25 | 10.27 | | 10.41 | 0.006405 | 1.71 | 95.03 | 40.94 | 0.30 |
| Railway to Hanna | 124.955 | 100 YR ARI | Momentum LF | 151.23 | 5.25 | 10.27 | | 10.41 | 0.006405 | 1.71 | 95.03 | 40.94 | 0.30 |
| Railway to Hanna | 124.955 | 100 YR ARI | Weir & Pres HF | 151.23 | 5.25 | 10.27 | | 10.41 | 0.006405 | 1.71 | 95.03 | 40.94 | 0.30 |
| Railway to Hanna | 124.955 | PMF | Energy | 314.31 | 5.25 | 11.89 | | 12.11 | 0.006176 | 2.19 | 169.97 | 50.39 | 0.32 |
| Railway to Hanna | 124.955 | PMF | Momentum LF | 314.31 | 5.25 | 11.89 | | 12.11 | 0.006176 | 2.19 | 169.97 | 50.39 | 0.32 |
| Railway to Hanna | 124.955 | PMF | Weir & Pres HF | 314.31 | 5.25 | 11.89 | | 12.11 | 0.006176 | 2.19 | 169.97 | 50.39 | 0.32 |
| Railway to Hanna | 108.623 | 100 YR ARI | Energy | 151.23 | 5.12 | 10.17 | | 10.31 | 0.006248 | 1.65 | 95.50 | 38.41 | 0.30 |
| Railway to Hanna | 108.623 | 100 YR ARI | Momentum LF | 151.23 | 5.12 | 10.17 | | 10.31 | 0.006248 | 1.65 | 95.50 | 38.41 | 0.30 |
| Railway to Hanna | 108.623 | 100 YR ARI | Weir & Pres HF | 151.23 | 5.12 | 10.17 | | 10.31 | 0.006248 | 1.65 | 95.50 | 38.41 | 0.30 |
| Railway to Hanna | 108.623 | PMF | Energy | 314.31 | 5.12 | 11.80 | | 12.01 | 0.005771 | 2.10 | 179.22 | 56.58 | 0.31 |
| Railway to Hanna | 108.623 | PMF | Momentum LF | 314.31 | 5.12 | 11.80 | | 12.01 | 0.005771 | 2.10 | 179.22 | 56.58 | 0.31 |
| Railway to Hanna | 108.623 | PMF | Weir & Pres HF | 314.31 | 5.12 | 11.80 | | 12.01 | 0.005771 | 2.10 | 179.22 | 56.58 | 0.31 |
| Railway to Hanna | 93.831 | 100 YR ARI | Energy | 151.23 | 5.00 | 10.08 | | 10.21 | 0.006215 | 1.61 | 97.16 | 37.76 | 0.29 |
| Railway to Hanna | 93.831 | 100 YR ARI | Momentum LF | 151.23 | 5.00 | 10.08 | | 10.21 | 0.006215 | 1.61 | 97.16 | 37.76 | 0.29 |
| Railway to Hanna | 93.831 | 100 YR ARI | Weir & Pres HF | 151.23 | 5.00 | 10.08 | | 10.21 | 0.006215 | 1.61 | 97.16 | 37.76 | 0.29 |
| Railway to Hanna | 93.831 | PMF | Energy | 314.31 | 5.00 | 11.72 | | 11.92 | 0.005779 | 2.07 | 173.32 | 51.20 | 0.31 |
| Railway to Hanna | 93.831 | PMF | Momentum LF | 314.31 | 5.00 | 11.72 | | 11.92 | 0.005779 | 2.07 | 173.32 | 51.20 | 0.31 |

| Reach | River Sta | Profile | Plan | Q Total | Min Ch El | W.S. Elev | Crit W.S. | E.G. Elev | E.G. Slope | Vel Chnl | Flow Area | Top Width | Froude # Chl |
|------------------|-----------|------------|----------------|---------|-----------|-----------|-----------|-----------|------------|----------|-----------|-----------|--------------|
| Railway to Hanna | 93.831 | PMF | Weir & Pres HF | 314.31 | 5.00 | 11.72 | | 11.92 | 0.005779 | 2.07 | 173.32 | 51.20 | 0.31 |
| Railway to Hanna | 82.077 | 100 YR ARI | Energy | 151.23 | 4.91 | 10.02 | | 10.14 | 0.005481 | 1.52 | 103.29 | 39.50 | 0.28 |
| Railway to Hanna | 82.077 | 100 YR ARI | Momentum LF | 151.23 | 4.91 | 10.02 | | 10.14 | 0.005481 | 1.52 | 103.29 | 39.50 | 0.28 |
| Railway to Hanna | 82.077 | 100 YR ARI | Weir & Pres HF | 151.23 | 4.91 | 10.02 | | 10.14 | 0.005481 | 1.52 | 103.29 | 39.50 | 0.28 |
| Railway to Hanna | 82.077 | PMF | Energy | 314.31 | 4.91 | 11.67 | | 11.85 | 0.005130 | 1.96 | 183.34 | 54.10 | 0.29 |
| Railway to Hanna | 82.077 | PMF | Momentum LF | 314.31 | 4.91 | 11.67 | | 11.85 | 0.005130 | 1.96 | 183.34 | 54.10 | 0.29 |
| Railway to Hanna | 82.077 | PMF | Weir & Pres HF | 314.31 | 4.91 | 11.67 | | 11.85 | 0.005130 | 1.96 | 183.34 | 54.10 | 0.29 |
| Railway to Hanna | 71.666 | 100 YR ARI | Energy | 151.23 | 4.82 | 9.95 | | 10.08 | 0.006278 | 1.58 | 99.45 | 37.30 | 0.29 |
| Railway to Hanna | 71.666 | 100 YR ARI | Momentum LF | 151.23 | 4.82 | 9.95 | | 10.08 | 0.006278 | 1.58 | 99.45 | 37.30 | 0.29 |
| Railway to Hanna | 71.666 | 100 YR ARI | Weir & Pres HF | 151.23 | 4.82 | 9.95 | | 10.08 | 0.006278 | 1.58 | 99.45 | 37.30 | 0.29 |
| Railway to Hanna | 71.666 | PMF | Energy | 314.31 | 4.82 | 11.60 | | 11.79 | 0.005711 | 2.03 | 174.88 | 50.88 | 0.30 |
| Railway to Hanna | 71.666 | PMF | Momentum LF | 314.31 | 4.82 | 11.60 | | 11.79 | 0.005711 | 2.03 | 174.88 | 50.88 | 0.30 |
| Railway to Hanna | 71.666 | PMF | Weir & Pres HF | 314.31 | 4.82 | 11.60 | | 11.79 | 0.005711 | 2.03 | 174.88 | 50.88 | 0.30 |
| Railway to Hanna | 55.953 | 100 YR ARI | Energy | 151.23 | 4.69 | 9.88 | | 9.98 | 0.005031 | 1.47 | 111.37 | 41.67 | 0.27 |
| Railway to Hanna | 55.953 | 100 YR ARI | Momentum LF | 151.23 | 4.69 | 9.88 | | 9.98 | 0.005031 | 1.47 | 111.37 | 41.67 | 0.27 |
| Railway to Hanna | 55.953 | 100 YR ARI | Weir & Pres HF | 151.23 | 4.69 | 9.88 | | 9.98 | 0.005031 | 1.47 | 111.37 | 41.67 | 0.27 |
| Railway to Hanna | 55.953 | PMF | Energy | 314.31 | 4.69 | 11.53 | | 11.71 | 0.004889 | 1.93 | 186.46 | 49.29 | 0.28 |
| Railway to Hanna | 55.953 | PMF | Momentum LF | 314.31 | 4.69 | 11.53 | | 11.71 | 0.004889 | 1.93 | 186.46 | 49.29 | 0.28 |
| Railway to Hanna | 55.953 | PMF | Weir & Pres HF | 314.31 | 4.69 | 11.53 | | 11.71 | 0.004889 | 1.93 | 186.46 | 49.29 | 0.28 |
| Railway to Hanna | 39.873 | 100 YR ARI | Energy | 151.23 | 4.56 | 9.80 | 7.69 | 9.90 | 0.005001 | 1.46 | 110.77 | 38.97 | 0.27 |
| Railway to Hanna | 39.873 | 100 YR ARI | Momentum LF | 151.23 | 4.56 | 9.80 | 7.69 | 9.90 | 0.005001 | 1.46 | 110.77 | 38.97 | 0.27 |
| Railway to Hanna | 39.873 | 100 YR ARI | Weir & Pres HF | 151.23 | 4.56 | 9.80 | 7.69 | 9.90 | 0.005001 | 1.46 | 110.77 | 38.97 | 0.27 |
| Railway to Hanna | 39.873 | PMF | Energy | 314.31 | 4.56 | 11.44 | 8.73 | 11.62 | 0.005002 | 1.95 | 180.94 | 46.34 | 0.29 |
| Railway to Hanna | 39.873 | PMF | Momentum LF | 314.31 | 4.56 | 11.44 | 8.73 | 11.62 | 0.005002 | 1.95 | 180.94 | 46.34 | 0.29 |
| Railway to Hanna | 39.873 | PMF | Weir & Pres HF | 314.31 | 4.56 | 11.44 | 8.73 | 11.62 | 0.005002 | 1.95 | 180.94 | 46.34 | 0.29 |

Woodlands Creek

| | River Sta | Profile | Plan | Q Total (m3/s) | Min Ch El (m) | W.S. Elev (m) | Crit W.S. (m) | E.G. Elev (m) | E.G. Slope (m/m) | Vel Chnl (m/s) | Flow Area (m2) | Top Width (m) | Froude # Chl |
|------------------|-----------|------------|--------------|-------------------|------------------|------------------|------------------|------------------|---------------------|-------------------|-------------------|------------------|--------------|
| Railway to Hanna | 561.631 | 100 YR ARI | Energy | 67.30 | 10.96 | 14.13 | 13.15 | 14.25 | 0.010389 | 2.03 | 58.46 | 38.41 | 0.38 |
| Railway to Hanna | 561.631 | 100 YR ARI | Momentum LF | 67.30 | 10.96 | 14.13 | 13.15 | 14.25 | 0.010389 | 2.03 | 58.46 | 38.41 | 0.38 |
| Railway to Hanna | 561.631 | 100 YR ARI | Weir Pres HF | 67.30 | 10.96 | 14.13 | 13.15 | 14.25 | 0.010389 | 2.03 | 58.46 | 38.41 | 0.38 |
| Railway to Hanna | 561.631 | PMF | Energy | 140.30 | 10.96 | 15.27 | 13.91 | 15.42 | 0.009061 | 2.36 | 109.08 | 48.94 | 0.37 |
| Railway to Hanna | 561.631 | PMF | Momentum LF | 140.30 | 10.96 | 15.22 | 13.91 | 15.37 | 0.009659 | 2.41 | 106.46 | 48.48 | 0.38 |
| Railway to Hanna | 561.631 | PMF | Weir Pres HF | 140.30 | 10.96 | 15.25 | 13.91 | 15.40 | 0.009276 | 2.38 | 108.11 | 48.77 | 0.37 |
| Railway to Hanna | 543.366 | 100 YR ARI | Energy | 67.30 | 10.80 | 13.96 | | 14.07 | 0.009314 | 1.91 | 61.02 | 38.72 | 0.36 |
| Railway to Hanna | 543.366 | 100 YR ARI | Momentum LF | 67.30 | 10.80 | 13.96 | | 14.07 | 0.009313 | 1.91 | 61.03 | 38.72 | 0.36 |
| Railway to Hanna | 543.366 | 100 YR ARI | Weir Pres HF | 67.30 | 10.80 | 13.96 | | 14.07 | 0.009314 | 1.91 | 61.02 | 38.72 | 0.36 |
| Railway to Hanna | 543.366 | PMF | Energy | 140.30 | 10.80 | 15.13 | | 15.25 | 0.008201 | 2.24 | 114.68 | 51.60 | 0.35 |
| Railway to Hanna | 543.366 | PMF | Momentum LF | 140.30 | 10.80 | 15.06 | | 15.20 | 0.008886 | 2.30 | 111.26 | 51.06 | 0.37 |
| Railway to Hanna | 543.366 | PMF | Weir Pres HF | 140.30 | 10.80 | 15.10 | | 15.23 | 0.008444 | 2.26 | 113.42 | 51.40 | 0.36 |
| Railway to Hanna | 524.548 | 100 YR ARI | Energy | 67.30 | 10.64 | 13.82 | | 13.90 | 0.007167 | 1.68 | 68.10 | 38.81 | 0.31 |
| Railway to Hanna | 524.548 | 100 YR ARI | Momentum LF | 67.30 | 10.64 | 13.82 | | 13.90 | 0.007166 | 1.68 | 68.10 | 38.81 | 0.31 |
| Railway to Hanna | 524.548 | 100 YR ARI | Weir Pres HF | 67.30 | 10.64 | 13.82 | | 13.90 | 0.007167 | 1.68 | 68.10 | 38.81 | 0.31 |
| Railway to Hanna | 524.548 | PMF | Energy | 140.30 | 10.64 | 15.00 | | 15.11 | 0.007101 | 2.09 | 122.67 | 56.37 | 0.33 |
| Railway to Hanna | 524.548 | PMF | Momentum LF | 140.30 | 10.64 | 14.92 | | 15.03 | 0.007852 | 2.17 | 118.24 | 53.61 | 0.34 |
| Railway to Hanna | 524.548 | PMF | Weir Pres HF | 140.30 | 10.64 | 14.97 | | 15.08 | 0.007364 | 2.12 | 121.03 | 55.59 | 0.33 |
| Railway to Hanna | 500.802 | 100 YR ARI | Energy | 67.30 | 10.43 | 13.68 | | 13.75 | 0.005968 | 1.57 | 71.76 | 40.61 | 0.29 |
| Railway to Hanna | 500.802 | 100 YR ARI | Momentum LF | 67.30 | 10.43 | 13.68 | | 13.75 | 0.005967 | 1.57 | 71.76 | 40.61 | 0.29 |
| Railway to Hanna | 500.802 | 100 YR ARI | Weir Pres HF | 67.30 | 10.43 | 13.68 | | 13.75 | 0.005968 | 1.57 | 71.76 | 40.61 | 0.29 |
| Railway to Hanna | 500.802 | PMF | Energy | 140.30 | 10.43 | 14.85 | | 14.95 | 0.006060 | 1.96 | 124.21 | 47.90 | 0.31 |
| Railway to Hanna | 500.802 | PMF | Momentum LF | 140.30 | 10.43 | 14.75 | | 14.86 | 0.006760 | 2.04 | 119.58 | 47.65 | 0.32 |
| Railway to Hanna | 500.802 | PMF | Weir Pres HF | 140.30 | 10.43 | 14.82 | | 14.92 | 0.006302 | 1.99 | 122.54 | 47.81 | 0.31 |
| Railway to Hanna | 478.813 | 100 YR ARI | Energy | 67.30 | 10.23 | 13.50 | | 13.60 | 0.008211 | 1.83 | 62.38 | 37.59 | 0.34 |
| Railway to Hanna | 478.813 | 100 YR ARI | Momentum LF | 67.30 | 10.23 | 13.50 | | 13.60 | 0.008210 | 1.83 | 62.38 | 37.59 | 0.34 |
| Railway to Hanna | 478.813 | 100 YR ARI | Weir Pres HF | 67.30 | 10.23 | 13.50 | | 13.60 | 0.008211 | 1.83 | 62.38 | 37.59 | 0.34 |
| Railway to Hanna | 478.813 | PMF | Energy | 140.30 | 10.23 | 14.68 | | 14.80 | 0.007588 | 2.19 | 111.73 | 43.79 | 0.34 |
| Railway to Hanna | 478.813 | PMF | Momentum LF | 140.30 | 10.23 | 14.55 | | 14.69 | 0.008746 | 2.30 | 106.35 | 43.56 | 0.36 |
| Railway to Hanna | 478.813 | PMF | Weir Pres HF | 140.30 | 10.23 | 14.63 | | 14.76 | 0.007976 | 2.23 | 109.82 | 43.71 | 0.35 |
| Railway to Hanna | 460.169 | 100 YR ARI | Energy | 67.30 | 10.07 | 13.35 | | 13.45 | 0.007772 | 1.79 | 62.34 | 36.33 | 0.33 |
| Railway to Hanna | 460.169 | 100 YR ARI | Momentum LF | 67.30 | 10.07 | 13.35 | | 13.45 | 0.007771 | 1.79 | 62.35 | 36.33 | 0.33 |
| Railway to Hanna | 460.169 | 100 YR ARI | Weir Pres HF | 67.30 | 10.07 | 13.35 | | 13.45 | 0.007772 | 1.79 | 62.34 | 36.33 | 0.33 |
| Railway to Hanna | 460.169 | PMF | Energy | 140.30 | 10.07 | 14.53 | | 14.66 | 0.007675 | 2.22 | 111.86 | 45.87 | 0.34 |
| Railway to Hanna | 460.169 | PMF | Momentum LF | 140.30 | 10.07 | 14.37 | | 14.53 | 0.009249 | 2.37 | 104.75 | 45.58 | 0.37 |
| Railway to Hanna | 460.169 | PMF | Weir Pres HF | 140.30 | 10.07 | 14.47 | | 14.61 | 0.008182 | 2.27 | 109.37 | 45.77 | 0.35 |
| Railway to Hanna | 442.699 | 100 YR ARI | Energy | 67.30 | 9.92 | 13.23 | | 13.32 | 0.007336 | 1.75 | 64.01 | 35.10 | 0.32 |
| Railway to Hanna | 442.699 | 100 YR ARI | Momentum LF | 67.30 | 9.92 | 13.23 | | 13.32 | 0.007335 | 1.75 | 64.01 | 35.10 | 0.32 |
| Railway to Hanna | 442.699 | 100 YR ARI | Weir Pres HF | 67.30 | 9.92 | 13.23 | | 13.32 | 0.007336 | 1.75 | 64.01 | 35.10 | 0.32 |
| Railway to Hanna | 442.699 | PMF | Energy | 140.30 | 9.92 | 14.40 | | 14.53 | 0.007615 | 2.21 | 113.25 | 46.76 | 0.34 |
| Railway to Hanna | 442.699 | PMF | Momentum LF | 140.30 | 9.92 | 14.21 | | 14.37 | 0.009603 | 2.41 | 104.36 | 46.40 | 0.38 |
| Railway to | 442.699 | PMF | Weir Pres | 140.30 | 9.92 | 14.34 | | 14.47 | 0.008238 | 2.28 | 110.21 | 46.75 | 0.35 |

| | River Sta | Profile | Plan | Q Total | Min Ch El | W.S. Elev | Crit W.S. | E.G. Elev | E.G. Slope | Vel Chnl | Flow Area | Top Width | Froude # Chl |
|------------------|-----------|------------|--------------|---------|-----------|-----------|-----------|-----------|------------|----------|-----------|-----------|--------------|
| Hanna | | | HF | | | | | | | | | | |
| Railway to Hanna | 426.223 | 100 YR ARI | Energy | 67.30 | 10.85 | 13.04 | 12.07 | 13.15 | 0.014043 | 2.00 | 53.95 | 33.84 | 0.43 |
| Railway to Hanna | 426.223 | 100 YR ARI | Momentum LF | 67.30 | 10.85 | 13.04 | 12.07 | 13.15 | 0.014039 | 2.00 | 53.96 | 33.84 | 0.43 |
| Railway to Hanna | 426.223 | 100 YR ARI | Weir Pres HF | 67.30 | 10.85 | 13.04 | 12.07 | 13.15 | 0.014043 | 2.00 | 53.95 | 33.84 | 0.43 |
| Railway to Hanna | 426.223 | PMF | Energy | 140.30 | 10.85 | 14.23 | 12.74 | 14.37 | 0.011395 | 2.40 | 102.09 | 46.01 | 0.42 |
| Railway to Hanna | 426.223 | PMF | Momentum LF | 140.30 | 10.85 | 13.97 | 12.74 | 14.16 | 0.015940 | 2.70 | 90.46 | 44.50 | 0.49 |
| Railway to Hanna | 426.223 | PMF | Weir Pres HF | 140.30 | 10.85 | 14.14 | 12.74 | 14.30 | 0.012827 | 2.51 | 98.14 | 45.95 | 0.44 |
| Railway to Hanna | 418 | | Bridge | | | | | | | | | | |
| Railway to Hanna | 411.793 | 100 YR ARI | Energy | 67.30 | 10.85 | 12.53 | | 12.75 | 0.036626 | 2.71 | 37.49 | 28.35 | 0.67 |
| Railway to Hanna | 411.793 | 100 YR ARI | Momentum LF | 67.30 | 10.85 | 12.53 | | 12.75 | 0.036585 | 2.71 | 37.50 | 28.35 | 0.67 |
| Railway to Hanna | 411.793 | 100 YR ARI | Weir Pres HF | 67.30 | 10.85 | 12.53 | | 12.75 | 0.036626 | 2.71 | 37.49 | 28.35 | 0.67 |
| Railway to Hanna | 411.793 | PMF | Energy | 140.30 | 10.85 | 13.44 | | 13.76 | 0.031686 | 3.36 | 66.15 | 36.78 | 0.67 |
| Railway to Hanna | 411.793 | PMF | Momentum LF | 140.30 | 10.85 | 13.44 | | 13.76 | 0.031598 | 3.36 | 66.22 | 36.81 | 0.67 |
| Railway to Hanna | 411.793 | PMF | Weir Pres HF | 140.30 | 10.85 | 13.44 | | 13.76 | 0.031686 | 3.36 | 66.15 | 36.78 | 0.67 |
| Railway to Hanna | 392.751 | 100 YR ARI | Energy | 67.30 | 9.48 | 12.20 | | 12.34 | 0.013680 | 2.09 | 51.47 | 32.30 | 0.42 |
| Railway to Hanna | 392.751 | 100 YR ARI | Momentum LF | 67.30 | 9.48 | 12.20 | | 12.34 | 0.013652 | 2.08 | 51.51 | 32.30 | 0.42 |
| Railway to Hanna | 392.751 | 100 YR ARI | Weir Pres HF | 67.30 | 9.48 | 12.20 | | 12.34 | 0.013680 | 2.09 | 51.47 | 32.30 | 0.42 |
| Railway to Hanna | 392.751 | PMF | Energy | 140.30 | 9.48 | 13.11 | | 13.32 | 0.016062 | 2.77 | 83.11 | 37.87 | 0.48 |
| Railway to Hanna | 392.751 | PMF | Momentum LF | 140.30 | 9.48 | 13.11 | | 13.33 | 0.015995 | 2.77 | 83.24 | 37.89 | 0.48 |
| Railway to Hanna | 392.751 | PMF | Weir Pres HF | 140.30 | 9.48 | 13.11 | | 13.32 | 0.016062 | 2.77 | 83.11 | 37.87 | 0.48 |
| Railway to Hanna | 374.319 | 100 YR ARI | Energy | 67.30 | 9.32 | 11.97 | | 12.09 | 0.013520 | 2.02 | 55.43 | 37.46 | 0.41 |
| Railway to Hanna | 374.319 | 100 YR ARI | Momentum LF | 67.30 | 9.32 | 11.97 | | 12.09 | 0.013471 | 2.02 | 55.50 | 37.48 | 0.41 |
| Railway to Hanna | 374.319 | 100 YR ARI | Weir Pres HF | 67.30 | 9.32 | 11.97 | | 12.09 | 0.013520 | 2.02 | 55.43 | 37.46 | 0.41 |
| Railway to Hanna | 374.319 | PMF | Energy | 140.30 | 9.32 | 12.86 | | 13.03 | 0.014777 | 2.60 | 92.12 | 44.94 | 0.46 |
| Railway to Hanna | 374.319 | PMF | Momentum LF | 140.30 | 9.32 | 12.86 | | 13.04 | 0.014677 | 2.59 | 92.35 | 45.06 | 0.45 |
| Railway to Hanna | 374.319 | PMF | Weir Pres HF | 140.30 | 9.32 | 12.86 | | 13.03 | 0.014777 | 2.60 | 92.12 | 44.94 | 0.46 |
| Railway to Hanna | 354.291 | 100 YR ARI | Energy | 67.30 | 9.14 | 11.75 | | 11.84 | 0.011453 | 1.84 | 62.88 | 44.59 | 0.38 |
| Railway to Hanna | 354.291 | 100 YR ARI | Momentum LF | 67.30 | 9.14 | 11.75 | | 11.84 | 0.011383 | 1.84 | 63.02 | 44.63 | 0.38 |
| Railway to Hanna | 354.291 | 100 YR ARI | Weir Pres HF | 67.30 | 9.14 | 11.75 | | 11.84 | 0.011453 | 1.84 | 62.88 | 44.59 | 0.38 |
| Railway to Hanna | 354.291 | PMF | Energy | 140.30 | 9.14 | 12.63 | | 12.76 | 0.012037 | 2.33 | 107.65 | 60.18 | 0.41 |
| Railway to Hanna | 354.291 | PMF | Momentum LF | 140.30 | 9.14 | 12.64 | | 12.77 | 0.011915 | 2.32 | 108.09 | 60.34 | 0.41 |
| Railway to Hanna | 354.291 | PMF | Weir Pres HF | 140.30 | 9.14 | 12.63 | | 12.76 | 0.012037 | 2.33 | 107.65 | 60.18 | 0.41 |
| Railway to Hanna | 332.479 | 100 YR ARI | Energy | 68.60 | 8.95 | 11.53 | | 11.60 | 0.009442 | 1.67 | 70.18 | 49.02 | 0.35 |
| Railway to Hanna | 332.479 | 100 YR ARI | Momentum LF | 68.60 | 8.95 | 11.54 | | 11.61 | 0.009349 | 1.67 | 70.44 | 49.08 | 0.35 |
| Railway to Hanna | 332.479 | 100 YR ARI | Weir Pres HF | 68.60 | 8.95 | 11.53 | | 11.60 | 0.009442 | 1.67 | 70.18 | 49.02 | 0.35 |
| Railway to Hanna | 332.479 | PMF | Energy | 145.90 | 8.95 | 12.39 | | 12.51 | 0.011060 | 2.22 | 117.67 | 62.05 | 0.40 |
| Railway to Hanna | 332.479 | PMF | Momentum LF | 145.90 | 8.95 | 12.40 | | 12.52 | 0.010898 | 2.21 | 118.34 | 62.21 | 0.39 |
| Railway to Hanna | 332.479 | PMF | Weir Pres HF | 145.90 | 8.95 | 12.39 | | 12.51 | 0.011060 | 2.22 | 117.67 | 62.05 | 0.40 |
| Railway to Hanna | 305.960 | 100 YR ARI | Energy | 68.60 | 8.72 | 11.25 | | 11.35 | 0.013023 | 1.93 | 64.61 | 52.54 | 0.40 |
| Railway to Hanna | 305.960 | 100 YR ARI | Momentum LF | 68.60 | 8.72 | 11.26 | | 11.36 | 0.012746 | 1.91 | 65.15 | 52.74 | 0.40 |
| Railway to Hanna | 305.960 | 100 YR ARI | Weir Pres HF | 68.60 | 8.72 | 11.25 | | 11.35 | 0.013023 | 1.93 | 64.61 | 52.54 | 0.40 |
| Railway to Hanna | 305.960 | PMF | Energy | 145.90 | 8.72 | 12.10 | | 12.23 | 0.013019 | 2.38 | 116.38 | 68.93 | 0.43 |
| Railway to Hanna | 305.960 | PMF | Momentum LF | 145.90 | 8.72 | 12.12 | | 12.25 | 0.012668 | 2.35 | 117.63 | 69.29 | 0.42 |
| Railway to Hanna | 305.960 | PMF | Weir Pres | 145.90 | 8.72 | 12.10 | | 12.23 | 0.013019 | 2.38 | 116.38 | 68.93 | 0.43 |

| | River Sta | Profile | Plan | Q Total | Min Ch El | W.S. Elev | Crit W.S. | E.G. Elev | E.G. Slope | Vel Chnl | Flow Area | Top Width | Froude # Chl |
|------------------|-----------|------------|--------------|---------|-----------|-----------|-----------|-----------|------------|----------|-----------|-----------|--------------|
| Hanna | | | HF | | | | | | | | | | |
| Railway to Hanna | 278.429 | 100 YR ARI | Energy | 68.60 | 8.48 | 11.01 | | 11.08 | 0.008013 | 1.53 | 77.60 | 59.44 | 0.32 |
| Railway to Hanna | 278.429 | 100 YR ARI | Momentum LF | 68.60 | 8.48 | 11.03 | | 11.09 | 0.007732 | 1.52 | 78.68 | 59.79 | 0.32 |
| Railway to Hanna | 278.429 | 100 YR ARI | Weir Pres HF | 68.60 | 8.48 | 11.01 | | 11.08 | 0.008013 | 1.53 | 77.60 | 59.44 | 0.32 |
| Railway to Hanna | 278.429 | PMF | Energy | 145.90 | 8.48 | 11.85 | | 11.95 | 0.008666 | 1.96 | 134.77 | 75.79 | 0.35 |
| Railway to Hanna | 278.429 | PMF | Momentum LF | 145.90 | 8.48 | 11.88 | | 11.97 | 0.008325 | 1.94 | 136.86 | 76.31 | 0.35 |
| Railway to Hanna | 278.429 | PMF | Weir Pres HF | 145.90 | 8.48 | 11.85 | | 11.95 | 0.008666 | 1.96 | 134.77 | 75.79 | 0.35 |
| Railway to Hanna | 247.890 | 100 YR ARI | Energy | 68.60 | 8.21 | 10.72 | | 10.81 | 0.012432 | 1.87 | 67.43 | 55.21 | 0.40 |
| Railway to Hanna | 247.890 | 100 YR ARI | Momentum LF | 68.60 | 8.21 | 10.76 | | 10.84 | 0.011509 | 1.82 | 69.45 | 55.88 | 0.38 |
| Railway to Hanna | 247.890 | 100 YR ARI | Weir Pres HF | 68.60 | 8.21 | 10.72 | | 10.81 | 0.012432 | 1.87 | 67.43 | 55.21 | 0.40 |
| Railway to Hanna | 247.890 | PMF | Energy | 145.90 | 8.21 | 11.56 | | 11.68 | 0.012376 | 2.30 | 120.54 | 74.95 | 0.42 |
| Railway to Hanna | 247.890 | PMF | Momentum LF | 145.90 | 8.21 | 11.61 | | 11.72 | 0.011545 | 2.25 | 123.96 | 76.14 | 0.40 |
| Railway to Hanna | 247.890 | PMF | Weir Pres HF | 145.90 | 8.21 | 11.56 | | 11.68 | 0.012376 | 2.30 | 120.54 | 74.95 | 0.42 |
| Railway to Hanna | 219.249 | 100 YR ARI | Energy | 68.60 | 7.96 | 10.57 | | 10.61 | 0.004239 | 1.16 | 93.76 | 58.77 | 0.24 |
| Railway to Hanna | 219.249 | 100 YR ARI | Momentum LF | 68.60 | 7.96 | 10.62 | | 10.66 | 0.003895 | 1.12 | 96.64 | 59.28 | 0.23 |
| Railway to Hanna | 219.249 | 100 YR ARI | Weir Pres HF | 68.60 | 7.96 | 10.57 | | 10.61 | 0.004239 | 1.16 | 93.76 | 58.77 | 0.24 |
| Railway to Hanna | 219.249 | PMF | Energy | 145.90 | 7.96 | 11.37 | | 11.45 | 0.005860 | 1.65 | 144.04 | 67.83 | 0.29 |
| Railway to Hanna | 219.249 | PMF | Momentum LF | 145.90 | 7.96 | 11.43 | | 11.50 | 0.005440 | 1.60 | 148.07 | 68.60 | 0.28 |
| Railway to Hanna | 219.249 | PMF | Weir Pres HF | 145.90 | 7.96 | 11.37 | | 11.45 | 0.005860 | 1.65 | 144.04 | 67.83 | 0.29 |
| Railway to Hanna | 180.729 | 100 YR ARI | Energy | 68.60 | 7.62 | 10.42 | | 10.47 | 0.005477 | 1.32 | 93.32 | 68.07 | 0.27 |
| Railway to Hanna | 180.729 | 100 YR ARI | Momentum LF | 68.60 | 7.62 | 10.49 | | 10.53 | 0.004837 | 1.27 | 97.83 | 69.35 | 0.25 |
| Railway to Hanna | 180.729 | 100 YR ARI | Weir Pres HF | 68.60 | 7.62 | 10.42 | | 10.47 | 0.005477 | 1.32 | 93.32 | 68.07 | 0.27 |
| Railway to Hanna | 180.729 | PMF | Energy | 145.90 | 7.62 | 11.18 | | 11.26 | 0.007039 | 1.80 | 151.28 | 83.89 | 0.32 |
| Railway to Hanna | 180.729 | PMF | Momentum LF | 145.90 | 7.62 | 11.26 | | 11.33 | 0.006231 | 1.72 | 157.95 | 84.76 | 0.30 |
| Railway to Hanna | 180.729 | PMF | Weir Pres HF | 145.90 | 7.62 | 11.18 | | 11.26 | 0.007039 | 1.80 | 151.28 | 83.89 | 0.32 |
| Railway to Hanna | 163.215 | 100 YR ARI | Energy | 68.60 | 8.41 | 10.20 | 9.50 | 10.29 | 0.017700 | 1.96 | 63.22 | 58.55 | 0.47 |
| Railway to Hanna | 163.215 | 100 YR ARI | Momentum LF | 68.60 | 8.41 | 10.30 | 9.50 | 10.38 | 0.013910 | 1.80 | 69.53 | 61.72 | 0.42 |
| Railway to Hanna | 163.215 | 100 YR ARI | Weir Pres HF | 68.60 | 8.41 | 10.20 | 9.50 | 10.29 | 0.017700 | 1.96 | 63.22 | 58.55 | 0.47 |
| Railway to Hanna | 163.215 | PMF | Energy | 145.90 | 8.41 | 10.92 | 10.04 | 11.05 | 0.017775 | 2.46 | 113.20 | 80.75 | 0.50 |
| Railway to Hanna | 163.215 | PMF | Momentum LF | 145.90 | 8.41 | 11.03 | 10.04 | 11.15 | 0.014815 | 2.32 | 122.96 | 83.84 | 0.46 |
| Railway to Hanna | 163.215 | PMF | Weir Pres HF | 145.90 | 8.41 | 10.92 | 10.04 | 11.05 | 0.017775 | 2.46 | 113.20 | 80.75 | 0.50 |
| Railway to Hanna | 158 | | | Bridge | | | | | | | | | |
| Railway to Hanna | 150.650 | 100 YR ARI | Energy | 68.60 | 8.40 | 9.88 | | 9.99 | 0.026176 | 2.10 | 56.05 | 55.73 | 0.55 |
| Railway to Hanna | 150.650 | 100 YR ARI | Momentum LF | 68.60 | 8.40 | 9.88 | | 9.99 | 0.026176 | 2.10 | 56.05 | 55.73 | 0.55 |
| Railway to Hanna | 150.650 | 100 YR ARI | Weir Pres HF | 68.60 | 8.40 | 9.88 | | 9.99 | 0.026176 | 2.10 | 56.05 | 55.73 | 0.55 |
| Railway to Hanna | 150.650 | PMF | Energy | 145.90 | 8.40 | 10.58 | | 10.73 | 0.024727 | 2.64 | 101.19 | 75.35 | 0.57 |
| Railway to Hanna | 150.650 | PMF | Momentum LF | 145.90 | 8.40 | 10.58 | | 10.73 | 0.024727 | 2.64 | 101.19 | 75.35 | 0.57 |
| Railway to Hanna | 150.650 | PMF | Weir Pres HF | 145.90 | 8.40 | 10.58 | | 10.73 | 0.024727 | 2.64 | 101.19 | 75.35 | 0.57 |
| Railway to Hanna | 138.605 | 100 YR ARI | Energy | 68.60 | 7.25 | 9.63 | | 9.72 | 0.013809 | 1.89 | 67.71 | 58.49 | 0.41 |
| Railway to Hanna | 138.605 | 100 YR ARI | Momentum LF | 68.60 | 7.25 | 9.63 | | 9.72 | 0.013809 | 1.89 | 67.71 | 58.49 | 0.41 |
| Railway to Hanna | 138.605 | 100 YR ARI | Weir Pres HF | 68.60 | 7.25 | 9.63 | | 9.72 | 0.013809 | 1.89 | 67.71 | 58.49 | 0.41 |
| Railway to Hanna | 138.605 | PMF | Energy | 145.90 | 7.25 | 10.30 | | 10.43 | 0.016779 | 2.49 | 110.41 | 70.38 | 0.47 |
| Railway to Hanna | 138.605 | PMF | Momentum LF | 145.90 | 7.25 | 10.30 | | 10.43 | 0.016779 | 2.49 | 110.41 | 70.38 | 0.47 |
| Railway to | 138.605 | PMF | Weir Pres | 145.90 | 7.25 | 10.30 | | 10.43 | 0.016779 | 2.49 | 110.41 | 70.38 | 0.47 |

| | River Sta | Profile | Plan | Q Total | Min Ch El | W.S. Elev | Crit W.S. | E.G. Elev | E.G. Slope | Vel Chnl | Flow Area | Top Width | Froude # Chl |
|------------------|-----------|------------|--------------|---------|-----------|-----------|-----------|-----------|------------|----------|-----------|-----------|--------------|
| Hanna | | | HF | | | | | | | | | | |
| Railway to Hanna | 118.255 | 100 YR ARI | Energy | 68.60 | 7.07 | 8.66 | 8.66 | 8.98 | 0.083003 | 3.43 | 35.86 | 49.13 | 0.94 |
| Railway to Hanna | 118.255 | 100 YR ARI | Momentum LF | 68.60 | 7.07 | 8.66 | 8.66 | 8.98 | 0.083003 | 3.43 | 35.86 | 49.13 | 0.94 |
| Railway to Hanna | 118.255 | 100 YR ARI | Weir Pres HF | 68.60 | 7.07 | 8.66 | 8.66 | 8.98 | 0.083003 | 3.43 | 35.86 | 49.13 | 0.94 |
| Railway to Hanna | 118.255 | PMF | Energy | 145.90 | 7.07 | 9.18 | 9.08 | 9.59 | 0.075635 | 4.07 | 63.85 | 57.17 | 0.94 |
| Railway to Hanna | 118.255 | PMF | Momentum LF | 145.90 | 7.07 | 9.18 | 9.08 | 9.59 | 0.075635 | 4.07 | 63.85 | 57.17 | 0.94 |
| Railway to Hanna | 118.255 | PMF | Weir Pres HF | 145.90 | 7.07 | 9.18 | 9.08 | 9.59 | 0.075635 | 4.07 | 63.85 | 57.17 | 0.94 |
| Railway to Hanna | 91.931 | 100 YR ARI | Energy | 68.60 | 6.19 | 7.92 | 7.43 | 8.03 | 0.016816 | 1.51 | 52.84 | 57.75 | 0.43 |
| Railway to Hanna | 91.931 | 100 YR ARI | Momentum LF | 68.60 | 6.19 | 7.92 | 7.43 | 8.03 | 0.016816 | 1.51 | 52.84 | 57.75 | 0.43 |
| Railway to Hanna | 91.931 | 100 YR ARI | Weir Pres HF | 68.60 | 6.19 | 7.92 | 7.43 | 8.03 | 0.016816 | 1.51 | 52.84 | 57.75 | 0.43 |
| Railway to Hanna | 91.931 | PMF | Energy | 145.90 | 6.19 | 8.51 | | 8.69 | 0.017959 | 2.02 | 88.04 | 62.24 | 0.47 |
| Railway to Hanna | 91.931 | PMF | Momentum LF | 145.90 | 6.19 | 8.51 | | 8.69 | 0.017959 | 2.02 | 88.04 | 62.24 | 0.47 |
| Railway to Hanna | 91.931 | PMF | Weir Pres HF | 145.90 | 6.19 | 8.51 | | 8.69 | 0.017959 | 2.02 | 88.04 | 62.24 | 0.47 |
| Railway to Hanna | 71.904 | 100 YR ARI | Energy | 68.60 | 6.00 | 7.81 | | 7.85 | 0.004697 | 0.84 | 86.90 | 71.05 | 0.23 |
| Railway to Hanna | 71.904 | 100 YR ARI | Momentum LF | 68.60 | 6.00 | 7.81 | | 7.85 | 0.004697 | 0.84 | 86.90 | 71.05 | 0.23 |
| Railway to Hanna | 71.904 | 100 YR ARI | Weir Pres HF | 68.60 | 6.00 | 7.81 | | 7.85 | 0.004697 | 0.84 | 86.90 | 71.05 | 0.23 |
| Railway to Hanna | 71.904 | PMF | Energy | 145.90 | 6.00 | 8.38 | | 8.46 | 0.006496 | 1.22 | 128.52 | 74.94 | 0.28 |
| Railway to Hanna | 71.904 | PMF | Momentum LF | 145.90 | 6.00 | 8.38 | | 8.46 | 0.006496 | 1.22 | 128.52 | 74.94 | 0.28 |
| Railway to Hanna | 71.904 | PMF | Weir Pres HF | 145.90 | 6.00 | 8.38 | | 8.46 | 0.006496 | 1.22 | 128.52 | 74.94 | 0.28 |
| Railway to Hanna | 43.756 | 100 YR ARI | Energy | 68.60 | 6.00 | 7.55 | | 7.62 | 0.016125 | 1.19 | 58.69 | 78.74 | 0.40 |
| Railway to Hanna | 43.756 | 100 YR ARI | Momentum LF | 68.60 | 6.00 | 7.55 | | 7.62 | 0.016125 | 1.19 | 58.69 | 78.74 | 0.40 |
| Railway to Hanna | 43.756 | 100 YR ARI | Weir Pres HF | 68.60 | 6.00 | 7.55 | | 7.62 | 0.016125 | 1.19 | 58.69 | 78.74 | 0.40 |
| Railway to Hanna | 43.756 | PMF | Energy | 145.90 | 6.00 | 8.09 | | 8.19 | 0.014292 | 1.47 | 109.48 | 99.36 | 0.40 |
| Railway to Hanna | 43.756 | PMF | Momentum LF | 145.90 | 6.00 | 8.09 | | 8.19 | 0.014292 | 1.47 | 109.48 | 99.36 | 0.40 |
| Railway to Hanna | 43.756 | PMF | Weir Pres HF | 145.90 | 6.00 | 8.09 | | 8.19 | 0.014292 | 1.47 | 109.48 | 99.36 | 0.40 |
| Railway to Hanna | 14.314 | 100 YR ARI | Energy | 68.60 | 6.00 | 7.35 | 6.56 | 7.36 | 0.005008 | 0.65 | 119.05 | 121.09 | 0.22 |
| Railway to Hanna | 14.314 | 100 YR ARI | Momentum LF | 68.60 | 6.00 | 7.35 | 6.56 | 7.36 | 0.005008 | 0.65 | 119.05 | 121.09 | 0.22 |
| Railway to Hanna | 14.314 | 100 YR ARI | Weir Pres HF | 68.60 | 6.00 | 7.35 | 6.56 | 7.36 | 0.005008 | 0.65 | 119.05 | 121.09 | 0.22 |
| Railway to Hanna | 14.314 | PMF | Energy | 145.90 | 6.00 | 7.91 | 6.87 | 7.94 | 0.005003 | 0.89 | 187.49 | 123.39 | 0.24 |
| Railway to Hanna | 14.314 | PMF | Momentum LF | 145.90 | 6.00 | 7.91 | 6.87 | 7.94 | 0.005003 | 0.89 | 187.49 | 123.39 | 0.24 |
| Railway to Hanna | 14.314 | PMF | Weir Pres HF | 145.90 | 6.00 | 7.91 | 6.87 | 7.94 | 0.005003 | 0.89 | 187.49 | 123.39 | 0.24 |

Summary Output Table for Beach Berm Modelling

| Reach | River Sta | Profile | Plan | Q Total (m3/s) | Min Ch El (m) | W.S. Elev (m) | Crit W.S. (m) | E.G. Elev (m) | E.G. Slope (m/m) | Vel Chnl (m/s) | Flow Area (m2) | Top Width (m) | Froude # Chl |
|---------|-----------|------------|----------------|-------------------|------------------|------------------|------------------|------------------|---------------------|-------------------|-------------------|------------------|-----------------|
| reach_1 | 416.951 | 100 YR ARI | P-UBCC DS&Rail | 100.50 | 7.80 | 11.78 | | 11.95 | 0.009562 | 1.83 | 59.42 | 29.17 | 0.36 |
| reach_1 | 416.951 | 100 YR ARI | Beach Berm | 100.50 | 7.80 | 11.78 | | 11.95 | 0.009562 | 1.83 | 59.42 | 29.17 | 0.36 |
| reach_1 | 416.951 | PMF | P-UBCC DS&Rail | 177.90 | 7.80 | 12.78 | | 13.02 | 0.009509 | 2.26 | 92.10 | 36.43 | 0.38 |
| reach_1 | 416.951 | PMF | Beach Berm | 177.90 | 7.80 | 12.78 | | 13.02 | 0.009513 | 2.26 | 92.09 | 36.43 | 0.38 |
| reach_1 | 408.012 | 100 YR ARI | P-UBCC DS&Rail | 100.50 | 7.71 | 11.70 | | 11.86 | 0.008999 | 1.78 | 61.09 | 29.99 | 0.35 |
| reach_1 | 408.012 | 100 YR ARI | Beach Berm | 100.50 | 7.71 | 11.70 | | 11.86 | 0.008999 | 1.78 | 61.09 | 29.99 | 0.35 |
| reach_1 | 408.012 | PMF | P-UBCC DS&Rail | 177.90 | 7.71 | 12.70 | | 12.93 | 0.008909 | 2.19 | 94.84 | 37.48 | 0.36 |
| reach_1 | 408.012 | PMF | Beach Berm | 177.90 | 7.71 | 12.70 | | 12.93 | 0.008913 | 2.19 | 94.82 | 37.48 | 0.36 |
| reach_1 | 399.203 | 100 YR ARI | P-UBCC DS&Rail | 100.50 | 7.61 | 11.64 | | 11.78 | 0.007703 | 1.68 | 65.31 | 31.56 | 0.32 |
| reach_1 | 399.203 | 100 YR ARI | Beach Berm | 100.50 | 7.61 | 11.64 | | 11.78 | 0.007703 | 1.68 | 65.31 | 31.56 | 0.32 |
| reach_1 | 399.203 | PMF | P-UBCC DS&Rail | 177.90 | 7.61 | 12.65 | | 12.85 | 0.007747 | 2.07 | 100.85 | 39.16 | 0.34 |
| reach_1 | 399.203 | PMF | Beach Berm | 177.90 | 7.61 | 12.65 | | 12.85 | 0.007751 | 2.07 | 100.83 | 39.15 | 0.34 |
| reach_1 | 391.774 | 100 YR ARI | P-UBCC DS&Rail | 100.50 | 7.53 | 11.59 | | 11.72 | 0.007672 | 1.66 | 66.14 | 33.03 | 0.32 |
| reach_1 | 391.774 | 100 YR ARI | Beach Berm | 100.50 | 7.53 | 11.59 | | 11.72 | 0.007672 | 1.66 | 66.14 | 33.03 | 0.32 |
| reach_1 | 391.774 | PMF | P-UBCC DS&Rail | 177.90 | 7.53 | 12.60 | | 12.79 | 0.007537 | 2.03 | 104.04 | 42.42 | 0.34 |
| reach_1 | 391.774 | PMF | Beach Berm | 177.90 | 7.53 | 12.60 | | 12.79 | 0.007541 | 2.03 | 104.02 | 42.41 | 0.34 |
| reach_1 | 384.639 | 100 YR ARI | P-UBCC DS&Rail | 100.50 | 7.45 | 11.53 | | 11.67 | 0.007654 | 1.65 | 65.64 | 35.51 | 0.32 |
| reach_1 | 384.639 | 100 YR ARI | Beach Berm | 100.50 | 7.45 | 11.53 | | 11.67 | 0.007654 | 1.65 | 65.64 | 35.51 | 0.32 |
| reach_1 | 384.639 | PMF | P-UBCC DS&Rail | 177.90 | 7.45 | 12.55 | | 12.74 | 0.007180 | 1.98 | 108.36 | 45.32 | 0.33 |
| reach_1 | 384.639 | PMF | Beach Berm | 177.90 | 7.45 | 12.55 | | 12.73 | 0.007184 | 1.98 | 108.34 | 45.32 | 0.33 |
| reach_1 | 373.531 | 100 YR ARI | P-UBCC DS&Rail | 100.50 | 7.33 | 11.46 | | 11.58 | 0.007030 | 1.58 | 68.79 | 33.29 | 0.31 |
| reach_1 | 373.531 | 100 YR ARI | Beach Berm | 100.50 | 7.33 | 11.46 | | 11.58 | 0.007030 | 1.58 | 68.79 | 33.29 | 0.31 |
| reach_1 | 373.531 | PMF | P-UBCC DS&Rail | 177.90 | 7.33 | 12.48 | | 12.65 | 0.006716 | 1.92 | 111.00 | 46.27 | 0.32 |
| reach_1 | 373.531 | PMF | Beach Berm | 177.90 | 7.33 | 12.48 | | 12.65 | 0.006720 | 1.92 | 110.97 | 46.26 | 0.32 |
| reach_1 | 360.818 | 100 YR ARI | P-UBCC DS&Rail | 100.50 | 7.19 | 11.36 | | 11.49 | 0.007657 | 1.63 | 66.24 | 31.38 | 0.32 |
| reach_1 | 360.818 | 100 YR ARI | Beach Berm | 100.50 | 7.19 | 11.36 | | 11.49 | 0.007657 | 1.63 | 66.24 | 31.38 | 0.32 |
| reach_1 | 360.818 | PMF | P-UBCC DS&Rail | 177.90 | 7.19 | 12.37 | | 12.56 | 0.007522 | 2.00 | 102.28 | 40.99 | 0.33 |
| reach_1 | 360.818 | PMF | Beach Berm | 177.90 | 7.19 | 12.37 | | 12.56 | 0.007527 | 2.00 | 102.25 | 40.98 | 0.33 |
| reach_1 | 346.505 | 100 YR ARI | P-UBCC DS&Rail | 100.50 | 7.06 | 11.27 | | 11.39 | 0.006016 | 1.54 | 72.50 | 32.91 | 0.29 |
| reach_1 | 346.505 | 100 YR ARI | Beach Berm | 100.50 | 7.06 | 11.27 | | 11.39 | 0.006016 | 1.54 | 72.50 | 32.91 | 0.29 |
| reach_1 | 346.505 | PMF | P-UBCC DS&Rail | 177.90 | 7.06 | 12.29 | | 12.46 | 0.006329 | 1.92 | 109.72 | 41.75 | 0.31 |
| reach_1 | 346.505 | PMF | Beach Berm | 177.90 | 7.06 | 12.29 | | 12.46 | 0.006333 | 1.92 | 109.69 | 41.74 | 0.31 |
| reach_1 | 332.230 | 100 YR ARI | P-UBCC DS&Rail | 100.50 | 6.94 | 11.18 | 9.55 | 11.30 | 0.006437 | 1.58 | 69.53 | 32.25 | 0.30 |
| reach_1 | 332.230 | 100 YR ARI | Beach Berm | 100.50 | 6.94 | 11.18 | 9.55 | 11.30 | 0.006437 | 1.58 | 69.53 | 32.25 | 0.30 |
| reach_1 | 332.230 | PMF | P-UBCC DS&Rail | 177.90 | 6.94 | 12.18 | 10.22 | 12.36 | 0.006813 | 1.99 | 105.73 | 39.93 | 0.32 |
| reach_1 | 332.230 | PMF | Beach Berm | 177.90 | 6.94 | 12.18 | 10.22 | 12.36 | 0.006818 | 1.99 | 105.70 | 39.92 | 0.32 |
| reach_1 | 324 | | Bridge | | | | | | | | | | |
| reach_1 | 315.928 | 100 YR ARI | P-UBCC DS&Rail | 100.50 | 6.81 | 10.99 | | 11.12 | 0.007049 | 1.59 | 68.00 | 32.85 | 0.31 |
| reach_1 | 315.928 | 100 YR ARI | Beach Berm | 100.50 | 6.81 | 10.99 | | 11.12 | 0.007049 | 1.59 | 68.00 | 32.85 | 0.31 |
| reach_1 | 315.928 | PMF | P-UBCC DS&Rail | 177.90 | 6.81 | 11.97 | | 12.16 | 0.007251 | 1.98 | 104.96 | 42.30 | 0.33 |
| reach_1 | 315.928 | PMF | Beach Berm | 177.90 | 6.81 | 11.97 | | 12.16 | 0.007258 | 1.98 | 104.92 | 42.29 | 0.33 |
| reach_1 | 305.563 | 100 YR | P-UBCC | 100.50 | 6.72 | 10.91 | | 11.04 | 0.007428 | 1.64 | 65.48 | 33.23 | 0.32 |

| | | | | | | | | | | | | |
|---------|---------|------------|----------------|--------|------|-------|-------|----------|------|--------|-------|------|
| reach_1 | 305.563 | ARI | DS&Rail | 100.50 | 6.72 | 10.91 | 11.04 | 0.007428 | 1.64 | 65.48 | 33.23 | 0.32 |
| reach_1 | 305.563 | 100 YR ARI | Beach Berm | 100.50 | 6.72 | 10.91 | 11.04 | 0.007428 | 1.64 | 65.48 | 33.23 | 0.32 |
| reach_1 | 305.563 | PMF | P-UBCC DS&Rail | 177.90 | 6.72 | 11.89 | 12.08 | 0.007537 | 2.03 | 103.60 | 42.38 | 0.33 |
| reach_1 | 305.563 | PMF | Beach Berm | 177.90 | 6.72 | 11.89 | 12.08 | 0.007545 | 2.03 | 103.55 | 42.38 | 0.33 |
| reach_1 | 295.821 | 100 YR ARI | P-UBCC DS&Rail | 100.50 | 6.64 | 10.83 | 10.97 | 0.007592 | 1.64 | 64.73 | 30.92 | 0.32 |
| reach_1 | 295.821 | 100 YR ARI | Beach Berm | 100.50 | 6.64 | 10.83 | 10.97 | 0.007592 | 1.64 | 64.73 | 30.92 | 0.32 |
| reach_1 | 295.821 | PMF | P-UBCC DS&Rail | 177.90 | 6.64 | 11.81 | 12.01 | 0.007731 | 2.03 | 101.80 | 41.93 | 0.34 |
| reach_1 | 295.821 | PMF | Beach Berm | 177.90 | 6.64 | 11.81 | 12.01 | 0.007740 | 2.03 | 101.75 | 41.92 | 0.34 |
| reach_1 | 286.355 | 100 YR ARI | P-UBCC DS&Rail | 100.50 | 6.57 | 10.74 | 10.89 | 0.008756 | 1.71 | 60.94 | 28.03 | 0.34 |
| reach_1 | 286.355 | 100 YR ARI | Beach Berm | 100.50 | 6.57 | 10.74 | 10.89 | 0.008756 | 1.71 | 60.94 | 28.03 | 0.34 |
| reach_1 | 286.355 | PMF | P-UBCC DS&Rail | 177.90 | 6.57 | 11.71 | 11.93 | 0.008716 | 2.11 | 96.89 | 41.22 | 0.36 |
| reach_1 | 286.355 | PMF | Beach Berm | 177.90 | 6.57 | 11.71 | 11.93 | 0.008728 | 2.11 | 96.84 | 41.21 | 0.36 |
| reach_1 | 276.823 | 100 YR ARI | P-UBCC DS&Rail | 100.50 | 6.49 | 10.64 | 10.80 | 0.009716 | 1.79 | 58.04 | 26.97 | 0.36 |
| reach_1 | 276.823 | 100 YR ARI | Beach Berm | 100.50 | 6.49 | 10.64 | 10.80 | 0.009716 | 1.79 | 58.04 | 26.97 | 0.36 |
| reach_1 | 276.823 | PMF | P-UBCC DS&Rail | 177.90 | 6.49 | 11.61 | 11.84 | 0.009577 | 2.19 | 93.44 | 41.54 | 0.37 |
| reach_1 | 276.823 | PMF | Beach Berm | 177.90 | 6.49 | 11.61 | 11.84 | 0.009593 | 2.19 | 93.37 | 41.54 | 0.37 |
| reach_1 | 266.862 | 100 YR ARI | P-UBCC DS&Rail | 100.50 | 6.41 | 10.56 | 10.71 | 0.008531 | 1.73 | 60.91 | 28.05 | 0.34 |
| reach_1 | 266.862 | 100 YR ARI | Beach Berm | 100.50 | 6.41 | 10.56 | 10.71 | 0.008531 | 1.73 | 60.91 | 28.05 | 0.34 |
| reach_1 | 266.862 | PMF | P-UBCC DS&Rail | 177.90 | 6.41 | 11.52 | 11.75 | 0.008741 | 2.15 | 96.48 | 42.44 | 0.36 |
| reach_1 | 266.862 | PMF | Beach Berm | 177.90 | 6.41 | 11.52 | 11.74 | 0.008757 | 2.15 | 96.41 | 42.43 | 0.36 |
| reach_1 | 258.198 | 100 YR ARI | P-UBCC DS&Rail | 100.50 | 6.34 | 10.47 | 10.63 | 0.008956 | 1.76 | 59.76 | 27.67 | 0.34 |
| reach_1 | 258.198 | 100 YR ARI | Beach Berm | 100.50 | 6.34 | 10.47 | 10.63 | 0.008956 | 1.76 | 59.76 | 27.67 | 0.34 |
| reach_1 | 258.198 | PMF | P-UBCC DS&Rail | 177.90 | 6.34 | 11.43 | 11.67 | 0.009396 | 2.21 | 92.87 | 41.16 | 0.37 |
| reach_1 | 258.198 | PMF | Beach Berm | 177.90 | 6.34 | 11.43 | 11.66 | 0.009415 | 2.21 | 92.79 | 41.15 | 0.37 |
| reach_1 | 249.723 | 100 YR ARI | P-UBCC DS&Rail | 100.50 | 6.27 | 10.39 | 10.55 | 0.009646 | 1.79 | 57.98 | 26.70 | 0.35 |
| reach_1 | 249.723 | 100 YR ARI | Beach Berm | 100.50 | 6.27 | 10.39 | 10.55 | 0.009646 | 1.79 | 57.98 | 26.70 | 0.35 |
| reach_1 | 249.723 | PMF | P-UBCC DS&Rail | 177.90 | 6.27 | 11.33 | 11.58 | 0.010185 | 2.26 | 88.35 | 38.86 | 0.38 |
| reach_1 | 249.723 | PMF | Beach Berm | 177.90 | 6.27 | 11.33 | 11.58 | 0.010208 | 2.26 | 88.26 | 38.85 | 0.38 |
| reach_1 | 239.532 | 100 YR ARI | P-UBCC DS&Rail | 100.50 | 6.19 | 10.28 | 10.44 | 0.011263 | 1.80 | 56.20 | 26.29 | 0.38 |
| reach_1 | 239.532 | 100 YR ARI | Beach Berm | 100.50 | 6.19 | 10.28 | 10.44 | 0.011263 | 1.80 | 56.20 | 26.29 | 0.38 |
| reach_1 | 239.532 | PMF | P-UBCC DS&Rail | 177.90 | 6.19 | 11.22 | 11.47 | 0.011027 | 2.23 | 84.20 | 35.45 | 0.39 |
| reach_1 | 239.532 | PMF | Beach Berm | 177.90 | 6.19 | 11.22 | 11.47 | 0.011056 | 2.24 | 84.12 | 35.41 | 0.39 |
| reach_1 | 226.906 | 100 YR ARI | P-UBCC DS&Rail | 100.50 | 6.08 | 10.16 | 10.31 | 0.009392 | 1.68 | 60.90 | 28.84 | 0.35 |
| reach_1 | 226.906 | 100 YR ARI | Beach Berm | 100.50 | 6.08 | 10.16 | 10.31 | 0.009392 | 1.68 | 60.90 | 28.84 | 0.35 |
| reach_1 | 226.906 | PMF | P-UBCC DS&Rail | 177.90 | 6.08 | 11.12 | 11.33 | 0.009106 | 2.07 | 93.52 | 39.34 | 0.36 |
| reach_1 | 226.906 | PMF | Beach Berm | 177.90 | 6.08 | 11.12 | 11.33 | 0.009134 | 2.07 | 93.41 | 39.32 | 0.36 |
| reach_1 | 215.941 | 100 YR ARI | P-UBCC DS&Rail | 100.50 | 6.00 | 10.06 | 10.20 | 0.009786 | 1.68 | 60.57 | 28.82 | 0.35 |
| reach_1 | 215.941 | 100 YR ARI | Beach Berm | 100.50 | 6.00 | 10.06 | 10.20 | 0.009786 | 1.68 | 60.57 | 28.82 | 0.35 |
| reach_1 | 215.941 | PMF | P-UBCC DS&Rail | 177.90 | 6.00 | 11.02 | 11.23 | 0.009159 | 2.05 | 93.87 | 39.69 | 0.36 |
| reach_1 | 215.941 | PMF | Beach Berm | 177.90 | 6.00 | 11.02 | 11.23 | 0.009191 | 2.05 | 93.75 | 39.66 | 0.36 |
| reach_1 | 201.805 | 100 YR ARI | P-UBCC DS&Rail | 100.50 | 5.88 | 9.90 | 10.05 | 0.011415 | 1.74 | 57.99 | 27.89 | 0.38 |
| reach_1 | 201.805 | 100 YR ARI | Beach Berm | 100.50 | 5.88 | 9.90 | 10.05 | 0.011415 | 1.74 | 57.99 | 27.89 | 0.38 |
| reach_1 | 201.805 | PMF | P-UBCC DS&Rail | 177.90 | 5.88 | 10.88 | 11.10 | 0.010136 | 2.08 | 90.58 | 38.78 | 0.38 |
| reach_1 | 201.805 | PMF | Beach Berm | 177.90 | 5.88 | 10.88 | 11.09 | 0.010180 | 2.08 | 90.43 | 38.75 | 0.38 |
| reach_1 | 188.580 | 100 YR ARI | P-UBCC DS&Rail | 100.50 | 5.77 | 9.75 | 9.90 | 0.011381 | 1.72 | 58.63 | 28.70 | 0.38 |

| | | | | | | | | | | | | | |
|---------|---------|------------|----------------|--------|------|-------|------|-------|----------|------|--------|-------|------|
| reach_1 | 188.580 | 100 YR ARI | Beach Berm | 100.50 | 5.77 | 9.75 | | 9.90 | 0.011381 | 1.72 | 58.63 | 28.70 | 0.38 |
| reach_1 | 188.580 | PMF | P-UBCC DS&Rail | 177.90 | 5.77 | 10.76 | | 10.96 | 0.009543 | 2.04 | 92.60 | 39.76 | 0.37 |
| reach_1 | 188.580 | PMF | Beach Berm | 177.90 | 5.77 | 10.75 | | 10.96 | 0.009592 | 2.04 | 92.42 | 39.71 | 0.37 |
| reach_1 | 173.814 | 100 YR ARI | P-UBCC DS&Rail | 100.50 | 5.65 | 9.58 | | 9.73 | 0.011667 | 1.71 | 58.78 | 29.26 | 0.38 |
| reach_1 | 173.814 | 100 YR ARI | Beach Berm | 100.50 | 5.65 | 9.58 | | 9.73 | 0.011667 | 1.71 | 58.78 | 29.26 | 0.38 |
| reach_1 | 173.814 | PMF | P-UBCC DS&Rail | 177.90 | 5.65 | 10.62 | | 10.82 | 0.009131 | 1.99 | 94.60 | 40.48 | 0.36 |
| reach_1 | 173.814 | PMF | Beach Berm | 177.90 | 5.65 | 10.62 | | 10.82 | 0.009187 | 1.99 | 94.38 | 40.42 | 0.36 |
| reach_1 | 158.201 | 100 YR ARI | P-UBCC DS&Rail | 100.50 | 5.53 | 9.35 | | 9.53 | 0.013899 | 1.87 | 54.03 | 27.46 | 0.41 |
| reach_1 | 158.201 | 100 YR ARI | Beach Berm | 100.50 | 5.53 | 9.35 | | 9.53 | 0.013899 | 1.87 | 54.03 | 27.46 | 0.41 |
| reach_1 | 158.201 | PMF | P-UBCC DS&Rail | 177.90 | 5.53 | 10.44 | | 10.67 | 0.010300 | 2.13 | 88.86 | 37.32 | 0.38 |
| reach_1 | 158.201 | PMF | Beach Berm | 177.90 | 5.53 | 10.44 | | 10.66 | 0.010378 | 2.13 | 88.61 | 37.27 | 0.38 |
| reach_1 | 142.886 | 100 YR ARI | P-UBCC DS&Rail | 100.90 | 5.40 | 9.05 | | 9.27 | 0.019360 | 2.09 | 48.36 | 25.41 | 0.48 |
| reach_1 | 142.886 | 100 YR ARI | Beach Berm | 100.90 | 5.40 | 9.05 | | 9.27 | 0.019360 | 2.09 | 48.36 | 25.41 | 0.48 |
| reach_1 | 142.886 | PMF | P-UBCC DS&Rail | 182.50 | 5.40 | 10.22 | | 10.49 | 0.012629 | 2.31 | 83.64 | 37.50 | 0.42 |
| reach_1 | 142.886 | PMF | Beach Berm | 182.50 | 5.40 | 10.21 | | 10.48 | 0.012763 | 2.32 | 83.30 | 37.44 | 0.42 |
| reach_1 | 124.955 | 100 YR ARI | P-UBCC DS&Rail | 100.90 | 5.25 | 8.93 | | 9.13 | 0.004296 | 1.98 | 50.98 | 27.09 | 0.45 |
| reach_1 | 124.955 | 100 YR ARI | Beach Berm | 100.90 | 5.25 | 8.93 | | 9.13 | 0.004296 | 1.98 | 50.98 | 27.09 | 0.45 |
| reach_1 | 124.955 | PMF | P-UBCC DS&Rail | 182.50 | 5.25 | 10.16 | | 10.39 | 0.002617 | 2.15 | 90.69 | 40.20 | 0.39 |
| reach_1 | 124.955 | PMF | Beach Berm | 182.50 | 5.25 | 10.15 | | 10.38 | 0.002646 | 2.16 | 90.29 | 40.13 | 0.39 |
| reach_1 | 108.623 | 100 YR ARI | P-UBCC DS&Rail | 100.90 | 5.12 | 8.81 | | 9.00 | 0.016672 | 1.95 | 51.71 | 27.15 | 0.45 |
| reach_1 | 108.623 | 100 YR ARI | Beach Berm | 100.90 | 5.12 | 8.81 | | 9.00 | 0.016672 | 1.95 | 51.71 | 27.15 | 0.45 |
| reach_1 | 108.623 | PMF | P-UBCC DS&Rail | 182.50 | 5.12 | 10.11 | | 10.31 | 0.009374 | 2.00 | 93.19 | 37.45 | 0.36 |
| reach_1 | 108.623 | PMF | Beach Berm | 182.50 | 5.12 | 10.10 | | 10.30 | 0.009493 | 2.01 | 92.79 | 37.28 | 0.37 |
| reach_1 | 93.831 | 100 YR ARI | P-UBCC DS&Rail | 100.90 | 4.91 | 8.67 | | 8.84 | 0.006905 | 1.83 | 55.09 | 27.54 | 0.41 |
| reach_1 | 93.831 | 100 YR ARI | Beach Berm | 100.90 | 4.91 | 8.67 | | 8.84 | 0.006905 | 1.83 | 55.09 | 27.54 | 0.41 |
| reach_1 | 93.831 | PMF | P-UBCC DS&Rail | 182.50 | 4.91 | 10.04 | | 10.21 | 0.004504 | 1.82 | 101.34 | 41.91 | 0.35 |
| reach_1 | 93.831 | PMF | Beach Berm | 182.50 | 4.91 | 10.03 | | 10.20 | 0.004565 | 1.83 | 100.83 | 41.68 | 0.35 |
| reach_1 | 82.077 | 100 YR ARI | P-UBCC DS&Rail | 100.90 | 4.74 | 7.66 | 7.66 | 8.67 | 0.008048 | 4.72 | 32.56 | 21.13 | 0.92 |
| reach_1 | 82.077 | 100 YR ARI | Beach Berm | 100.90 | 4.74 | 7.66 | 7.66 | 8.67 | 0.008048 | 4.72 | 32.56 | 21.13 | 0.92 |
| reach_1 | 82.077 | PMF | P-UBCC DS&Rail | 182.50 | 4.74 | 8.92 | | 10.05 | 0.005892 | 5.23 | 65.61 | 32.71 | 0.84 |
| reach_1 | 82.077 | PMF | Beach Berm | 182.50 | 4.74 | 8.76 | | 10.02 | 0.006879 | 5.50 | 60.61 | 30.29 | 0.91 |
| reach_1 | 71.666 | 100 YR ARI | P-UBCC DS&Rail | 100.90 | 4.50 | 7.71 | 7.27 | 8.42 | 0.005472 | 3.87 | 36.07 | 20.66 | 0.72 |
| reach_1 | 71.666 | 100 YR ARI | Beach Berm | 100.90 | 4.50 | 7.66 | 7.27 | 8.40 | 0.005817 | 3.95 | 35.07 | 20.32 | 0.74 |
| reach_1 | 71.666 | PMF | P-UBCC DS&Rail | 182.50 | 4.50 | 9.11 | | 9.90 | 0.003972 | 4.27 | 72.40 | 30.39 | 0.65 |
| reach_1 | 71.666 | PMF | Beach Berm | 182.50 | 4.50 | 8.99 | | 9.84 | 0.004473 | 4.44 | 68.60 | 29.68 | 0.69 |
| reach_1 | 55.953 | 100 YR ARI | P-UBCC DS&Rail | 100.90 | 4.25 | 7.72 | | 8.31 | 0.004137 | 3.53 | 40.97 | 22.16 | 0.62 |
| reach_1 | 55.953 | 100 YR ARI | Beach Berm | 100.90 | 4.25 | 7.67 | | 8.28 | 0.004375 | 3.59 | 39.92 | 21.84 | 0.64 |
| reach_1 | 55.953 | PMF | P-UBCC DS&Rail | 182.50 | 4.25 | 9.11 | | 9.81 | 0.003389 | 4.05 | 78.19 | 31.40 | 0.60 |
| reach_1 | 55.953 | PMF | Beach Berm | 182.50 | 4.25 | 8.99 | | 9.75 | 0.003774 | 4.20 | 74.38 | 30.58 | 0.63 |
| reach_1 | 39.873 | 100 YR ARI | P-UBCC DS&Rail | 100.90 | 4.00 | 7.58 | | 8.23 | 0.004759 | 3.68 | 38.81 | 21.59 | 0.64 |
| reach_1 | 39.873 | 100 YR ARI | Beach Berm | 100.90 | 4.00 | 7.52 | | 8.20 | 0.005119 | 3.77 | 37.45 | 21.01 | 0.66 |
| reach_1 | 39.873 | PMF | P-UBCC DS&Rail | 182.50 | 4.00 | 9.07 | | 9.75 | 0.003516 | 4.04 | 80.84 | 35.03 | 0.59 |
| reach_1 | 39.873 | PMF | Beach Berm | 182.50 | 4.00 | 8.93 | | 9.69 | 0.003994 | 4.22 | 76.00 | 33.78 | 0.62 |
| reach_1 | 36.582* | 100 YR ARI | P-UBCC DS&Rail | 100.90 | 3.85 | 7.49 | | 8.18 | 0.005241 | 3.76 | 34.11 | 18.77 | 0.67 |
| reach_1 | 36.582* | PMF | P-UBCC | 182.50 | 3.85 | 8.95 | | 9.72 | 0.003958 | 4.19 | 72.13 | 33.68 | 0.62 |

| DS&Rail | | | | | | | | | | | | | |
|---------|----------|------------|----------------|--------|------|------|------|------|----------|------|--------|-------|------|
| reach_1 | 33.291* | 100 YR ARI | P-UBCC DS&Rail | 100.90 | 3.71 | 7.38 | | 8.13 | 0.006313 | 3.88 | 30.11 | 16.76 | 0.69 |
| reach_1 | 33.291* | PMF | P-UBCC DS&Rail | 182.50 | 3.71 | 8.72 | | 9.66 | 0.005419 | 4.53 | 60.56 | 30.16 | 0.67 |
| reach_1 | 30 | 100 YR ARI | P-UBCC DS&Rail | 100.90 | 3.56 | 7.36 | | 8.07 | 0.006310 | 3.75 | 28.78 | 14.50 | 0.65 |
| reach_1 | 30 | 100 YR ARI | Beach Berm | 100.90 | 3.56 | 7.33 | | 8.05 | 0.006491 | 3.78 | 28.39 | 14.26 | 0.66 |
| reach_1 | 30 | PMF | P-UBCC DS&Rail | 182.50 | 3.56 | 8.68 | | 9.61 | 0.005810 | 4.47 | 55.83 | 26.41 | 0.66 |
| reach_1 | 30 | PMF | Beach Berm | 182.50 | 3.56 | 8.22 | 8.03 | 9.50 | 0.008760 | 5.14 | 44.76 | 22.31 | 0.79 |
| reach_1 | 27.5* | 100 YR ARI | P-UBCC DS&Rail | 100.90 | 3.42 | 6.76 | 6.76 | 7.96 | 0.012999 | 4.97 | 21.87 | 10.38 | 1.00 |
| reach_1 | 27.5* | PMF | P-UBCC DS&Rail | 182.50 | 3.42 | 8.18 | 8.18 | 9.53 | 0.008412 | 5.40 | 47.70 | 26.82 | 0.87 |
| reach_1 | 25 | 100 YR ARI | P-UBCC DS&Rail | 100.90 | 3.28 | 6.12 | 6.47 | 7.80 | 0.022685 | 5.74 | 17.58 | 7.54 | 1.19 |
| reach_1 | 25 | 100 YR ARI | Beach Berm | 100.90 | 3.52 | 6.60 | 6.60 | 7.88 | 0.014082 | 5.01 | 21.25 | 11.21 | 0.98 |
| reach_1 | 25 | PMF | P-UBCC DS&Rail | 182.50 | 3.28 | 7.50 | 7.95 | 9.40 | 0.014560 | 6.25 | 39.65 | 26.18 | 1.03 |
| reach_1 | 25 | PMF | Beach Berm | 182.50 | 3.52 | 8.11 | 8.11 | 9.38 | 0.008536 | 5.25 | 56.31 | 32.92 | 0.82 |
| reach_1 | 22.5* | 100 YR ARI | P-UBCC DS&Rail | 100.90 | 3.12 | 6.61 | 6.61 | 7.60 | 0.014212 | 4.93 | 24.81 | 11.68 | 0.94 |
| reach_1 | 22.5* | PMF | P-UBCC DS&Rail | 182.50 | 3.12 | 7.05 | 7.69 | 9.22 | 0.026283 | 7.37 | 30.94 | 15.55 | 1.30 |
| reach_1 | 20 | 100 YR ARI | P-UBCC DS&Rail | 100.90 | 2.96 | 6.43 | 4.86 | 6.70 | 0.002179 | 2.30 | 43.90 | 13.68 | 0.41 |
| reach_1 | 20 | 100 YR ARI | Beach Berm | 100.90 | 3.44 | 4.55 | 5.34 | 7.32 | 0.071973 | 7.37 | 13.69 | 12.61 | 2.26 |
| reach_1 | 20 | PMF | P-UBCC DS&Rail | 182.50 | 2.96 | 7.47 | 5.78 | 7.96 | 0.002932 | 3.10 | 60.25 | 20.40 | 0.49 |
| reach_1 | 20 | PMF | Beach Berm | 182.50 | 3.44 | 5.16 | 6.26 | 8.86 | 0.059221 | 8.53 | 21.40 | 12.78 | 2.10 |
| reach_1 | 17.5* | 100 YR ARI | P-UBCC DS&Rail | 100.90 | 2.82 | 6.09 | | 6.65 | 0.004283 | 3.40 | 34.31 | 16.50 | 0.65 |
| reach_1 | 17.5* | PMF | P-UBCC DS&Rail | 182.50 | 2.82 | 6.65 | 6.40 | 7.86 | 0.007404 | 5.05 | 44.21 | 19.40 | 0.88 |
| reach_1 | 15 | 100 YR ARI | P-UBCC DS&Rail | 100.90 | 2.68 | 6.23 | | 6.55 | 0.002467 | 2.53 | 40.67 | 16.78 | 0.46 |
| reach_1 | 15 | 100 YR ARI | Beach Berm | 100.90 | 3.39 | 6.06 | 5.49 | 6.61 | 0.005514 | 3.30 | 30.83 | 14.88 | 0.68 |
| reach_1 | 15 | PMF | P-UBCC DS&Rail | 182.50 | 2.68 | 6.99 | | 7.65 | 0.003774 | 3.62 | 56.11 | 23.50 | 0.59 |
| reach_1 | 15 | PMF | Beach Berm | 182.50 | 3.39 | 6.13 | 6.47 | 7.84 | 0.016271 | 5.78 | 31.97 | 15.78 | 1.18 |
| reach_1 | 11.7619* | 100 YR ARI | P-UBCC DS&Rail | 100.90 | 2.51 | 6.11 | | 6.51 | 0.006021 | 2.83 | 39.35 | 20.00 | 0.51 |
| reach_1 | 11.7619* | PMF | P-UBCC DS&Rail | 182.50 | 2.51 | 6.80 | | 7.58 | 0.009269 | 4.01 | 55.53 | 26.43 | 0.66 |
| reach_1 | 8.5238* | 100 YR ARI | P-UBCC DS&Rail | 100.90 | 2.34 | 5.97 | | 6.42 | 0.012036 | 3.08 | 39.30 | 21.43 | 0.56 |
| reach_1 | 8.5238* | PMF | P-UBCC DS&Rail | 182.50 | 2.34 | 6.39 | 6.32 | 7.42 | 0.023645 | 4.70 | 49.69 | 27.41 | 0.80 |
| reach_1 | 5.2857* | 100 YR ARI | P-UBCC DS&Rail | 100.90 | 2.17 | 5.93 | | 6.23 | 0.017631 | 2.46 | 47.36 | 39.38 | 0.54 |
| reach_1 | 5.2857* | PMF | P-UBCC DS&Rail | 182.50 | 2.17 | 6.58 | | 7.01 | 0.021939 | 3.06 | 76.10 | 46.58 | 0.62 |
| reach_1 | 2.0476 | 100 YR ARI | P-UBCC DS&Rail | 100.90 | 2.00 | 5.95 | | 6.04 | 0.009790 | 1.60 | 83.43 | 43.31 | 0.34 |
| reach_1 | 2.0476 | 100 YR ARI | Beach Berm | 100.90 | 3.14 | 6.10 | | 6.18 | 0.009855 | 1.53 | 85.04 | 43.86 | 0.34 |
| reach_1 | 2.0476 | PMF | P-UBCC DS&Rail | 182.50 | 2.00 | 6.60 | | 6.76 | 0.013535 | 2.05 | 112.67 | 45.94 | 0.41 |
| reach_1 | 2.0476 | PMF | Beach Berm | 182.50 | 3.14 | 6.74 | 5.47 | 6.89 | 0.013534 | 1.98 | 114.07 | 46.52 | 0.41 |
| reach_1 | 1.96827* | 100 YR ARI | P-UBCC DS&Rail | 100.90 | 1.98 | 5.90 | | 5.97 | 0.006748 | 1.37 | 100.49 | 54.34 | 0.29 |
| reach_1 | 1.96827* | PMF | P-UBCC DS&Rail | 182.50 | 1.98 | 6.55 | | 6.66 | 0.009034 | 1.76 | 136.45 | 58.54 | 0.34 |
| reach_1 | 1.88894* | 100 YR ARI | P-UBCC DS&Rail | 100.90 | 1.97 | 5.86 | | 5.92 | 0.005435 | 1.23 | 114.33 | 65.22 | 0.26 |
| reach_1 | 1.88894* | PMF | P-UBCC DS&Rail | 182.50 | 1.97 | 6.50 | | 6.59 | 0.006729 | 1.59 | 157.59 | 69.40 | 0.30 |
| reach_1 | 1.80962 | 100 YR ARI | P-UBCC DS&Rail | 100.90 | 1.95 | 5.83 | | 5.87 | 0.004784 | 1.15 | 125.19 | 78.14 | 0.24 |
| reach_1 | 1.80962 | 100 YR ARI | Beach Berm | 100.90 | 2.97 | 5.98 | | 6.02 | 0.004579 | 1.09 | 130.10 | 78.52 | 0.24 |
| reach_1 | 1.80962 | PMF | P-UBCC DS&Rail | 182.50 | 1.95 | 6.46 | | 6.54 | 0.005579 | 1.46 | 175.41 | 79.77 | 0.27 |
| reach_1 | 1.80962 | PMF | Beach Berm | 182.50 | 2.97 | 6.60 | | 6.67 | 0.005376 | 1.40 | 180.01 | 80.13 | 0.27 |


| | | | | | | | | | | | | |
|---------|----------|---------------|-------------------|--------|------|------|------|----------|------|--------|--------|------|
| reach_1 | 1.73205* | 100 YR ARI | P-UBCC DS&Rail | 100.90 | 1.93 | 5.78 | 5.83 | 0.005631 | 1.24 | 118.74 | 74.43 | 0.26 |
| reach_1 | 1.73205* | PMF | P-UBCC DS&Rail | 182.50 | 1.93 | 6.41 | 6.49 | 0.006602 | 1.58 | 166.89 | 78.15 | 0.29 |
| reach_1 | 1.65448* | 100 YR ARI | P-UBCC DS&Rail | 100.90 | 1.92 | 5.72 | 5.78 | 0.006752 | 1.37 | 111.97 | 73.46 | 0.28 |
| reach_1 | 1.65448* | PMF | P-UBCC DS&Rail | 182.50 | 1.92 | 6.34 | 6.43 | 0.007997 | 1.71 | 157.77 | 76.08 | 0.32 |
| reach_1 | 1.57691* | 100 YR ARI | P-UBCC DS&Rail | 100.90 | 1.91 | 5.65 | 5.72 | 0.008585 | 1.54 | 103.95 | 72.67 | 0.31 |
| reach_1 | 1.57691* | PMF | P-UBCC DS&Rail | 182.50 | 1.91 | 6.25 | 6.36 | 0.010036 | 1.87 | 148.14 | 73.60 | 0.34 |
| reach_1 | 1.49934 | 100 YR ARI | P-UBCC DS&Rail | 100.90 | 1.89 | 5.54 | 5.64 | 0.012110 | 1.78 | 93.67 | 72.01 | 0.35 |
| reach_1 | 1.49934 | 100 YR ARI | Beach Berm | 100.90 | 2.92 | 5.74 | 5.81 | 0.010517 | 1.58 | 102.19 | 72.15 | 0.33 |
| reach_1 | 1.49934 | PMF | P-UBCC DS&Rail | 182.50 | 1.89 | 6.14 | 6.27 | 0.013442 | 2.09 | 136.83 | 72.34 | 0.37 |
| reach_1 | 1.49934 | PMF | Beach Berm | 182.50 | 2.92 | 6.33 | 6.43 | 0.011911 | 1.89 | 144.95 | 72.52 | 0.36 |
| reach_1 | 1.42324* | 100 YR ARI | P-UBCC DS&Rail | 100.90 | 1.87 | 5.36 | 5.52 | 0.016399 | 2.06 | 78.42 | 72.15 | 0.42 |
| reach_1 | 1.42324* | PMF | P-UBCC DS&Rail | 182.50 | 1.87 | 5.95 | 6.13 | 0.017301 | 2.38 | 121.53 | 75.27 | 0.44 |
| reach_1 | 1.34714* | 100 YR ARI | P-UBCC DS&Rail | 100.90 | 1.86 | 5.18 | 5.37 | 0.019103 | 2.17 | 69.94 | 70.89 | 0.46 |
| reach_1 | 1.34714* | PMF | P-UBCC DS&Rail | 182.50 | 1.86 | 5.72 | 5.96 | 0.020791 | 2.58 | 110.51 | 77.56 | 0.50 |
| reach_1 | 1.27105 | 100 YR ARI | P-UBCC DS&Rail | 100.90 | 1.84 | 4.95 | 5.19 | 0.024466 | 2.34 | 59.22 | 69.71 | 0.53 |
| reach_1 | 1.27105 | 100 YR ARI | Beach Berm | 100.90 | 2.80 | 4.85 | 5.25 | 0.056658 | 3.03 | 45.34 | 56.72 | 0.78 |
| reach_1 | 1.27105 | PMF | P-UBCC DS&Rail | 182.50 | 1.84 | 5.40 | 5.74 | 0.030050 | 2.95 | 93.48 | 79.43 | 0.60 |
| reach_1 | 1.27105 | PMF | Beach Berm | 182.50 | 2.80 | 5.30 | 5.79 | 0.059329 | 3.59 | 77.61 | 78.59 | 0.83 |
| reach_1 | 1.20236* | 100 YR ARI | P-UBCC DS&Rail | 100.90 | 1.83 | 4.85 | 5.02 | 0.019027 | 2.11 | 73.88 | 77.98 | 0.47 |
| reach_1 | 1.20236* | PMF | P-UBCC DS&Rail | 182.50 | 1.83 | 5.29 | 5.53 | 0.022810 | 2.63 | 109.87 | 83.17 | 0.53 |
| reach_1 | 1.13367* | 100 YR ARI | P-UBCC DS&Rail | 100.90 | 1.81 | 4.80 | 4.90 | 0.011230 | 1.70 | 96.48 | 81.85 | 0.36 |
| reach_1 | 1.13367* | PMF | P-UBCC DS&Rail | 182.50 | 1.81 | 5.24 | 5.38 | 0.014235 | 2.16 | 137.51 | 104.06 | 0.42 |
| reach_1 | 1.06498 | 100 YR ARI | P-UBCC DS&Rail | 100.90 | 1.80 | 4.78 | 4.83 | 0.005893 | 1.29 | 128.76 | 106.09 | 0.27 |
| reach_1 | 1.06498 | 100 YR ARI | Beach Berm | 100.90 | 2.69 | 4.67 | 4.72 | 0.010567 | 1.45 | 109.60 | 100.82 | 0.35 |
| reach_1 | 1.06498 | PMF | P-UBCC DS&Rail | 182.50 | 1.80 | 5.22 | 5.29 | 0.007725 | 1.65 | 179.24 | 122.51 | 0.31 |
| reach_1 | 1.06498 | PMF | Beach Berm | 182.50 | 2.69 | 5.10 | 5.19 | 0.012417 | 1.82 | 158.16 | 121.81 | 0.39 |
| reach_1 | .974486* | 100 YR ARI | P-UBCC DS&Rail | 100.90 | 1.78 | 4.71 | 4.77 | 0.007427 | 1.43 | 116.89 | 110.59 | 0.30 |
| reach_1 | .974486* | PMF | P-UBCC DS&Rail | 182.50 | 1.78 | 5.12 | 5.21 | 0.008867 | 1.74 | 165.95 | 122.96 | 0.34 |
| reach_1 | .883993* | 100 YR ARI | P-UBCC DS&Rail | 100.90 | 1.77 | 4.62 | 4.69 | 0.009172 | 1.54 | 105.29 | 113.02 | 0.33 |
| reach_1 | .883993* | PMF | P-UBCC DS&Rail | 182.50 | 1.77 | 5.00 | 5.12 | 0.010368 | 1.83 | 150.96 | 123.54 | 0.36 |
| reach_1 | .793499* | 100 YR ARI | P-UBCC DS&Rail | 100.90 | 1.75 | 4.49 | 4.60 | 0.011372 | 1.64 | 91.50 | 113.83 | 0.37 |
| reach_1 | .793499* | PMF | P-UBCC DS&Rail | 182.50 | 1.75 | 4.86 | 5.01 | 0.012348 | 1.91 | 134.47 | 126.01 | 0.39 |
| reach_1 | .703006* | 100 YR ARI | P-UBCC DS&Rail | 100.90 | 1.73 | 4.34 | 4.47 | 0.013650 | 1.70 | 76.01 | 109.53 | 0.40 |
| reach_1 | .703006* | PMF | P-UBCC DS&Rail | 182.50 | 1.73 | 4.67 | 4.87 | 0.016101 | 2.06 | 115.28 | 125.57 | 0.44 |
| reach_1 | .612513* | 100 YR ARI | P-UBCC DS&Rail | 100.90 | 1.72 | 4.21 | 4.34 | 0.014085 | 1.63 | 71.45 | 103.50 | 0.40 |
| reach_1 | .612513* | PMF | P-UBCC DS&Rail | 182.50 | 1.72 | 4.52 | 4.72 | 0.014897 | 1.87 | 109.87 | 134.84 | 0.42 |
| reach_1 | 0.52202 | 100 YR ARI | P-UBCC DS&Rail | 100.90 | 1.70 | 4.15 | 4.23 | 0.006218 | 1.05 | 88.51 | 106.49 | 0.26 |
| reach_1 | 0.52202 | 100 YR ARI | Beach Berm | 100.90 | 2.35 | 4.24 | 4.31 | 0.005219 | 0.93 | 94.60 | 112.84 | 0.24 |
| reach_1 | 0.52202 | PMF | P-UBCC DS&Rail | 182.50 | 1.70 | 4.45 | 4.59 | 0.008135 | 1.34 | 123.08 | 126.00 | 0.31 |
| reach_1 | 0.52202 | PMF | Beach Berm | 182.50 | 2.35 | 4.59 | 4.71 | 0.005910 | 1.13 | 138.38 | 142.69 | 0.27 |
| reach_1 | .43129* | 100 YR ARI | P-UBCC DS&Rail | 100.90 | 1.67 | 4.08 | 4.17 | 0.007901 | 1.19 | 87.55 | 123.41 | 0.30 |
| reach_1 | .43129* | PMF | P-UBCC | 182.50 | 1.67 | 4.37 | 4.51 | 0.009470 | 1.45 | 129.18 | 157.20 | 0.34 |

| DS&Rail | | | | | | | | | | | | | |
|---------|---------|------------|----------------|--------|------|------|------|------|----------|------|--------|--------|------|
| reach_1 | .34056* | 100 YR ARI | P-UBCC DS&Rail | 100.90 | 1.65 | 3.99 | | 4.08 | 0.011153 | 1.42 | 89.37 | 150.04 | 0.36 |
| reach_1 | .34056* | PMF | P-UBCC DS&Rail | 182.50 | 1.65 | 4.28 | | 4.41 | 0.011002 | 1.58 | 134.46 | 157.94 | 0.36 |
| reach_1 | .24983* | 100 YR ARI | P-UBCC DS&Rail | 100.90 | 1.62 | 3.84 | | 3.95 | 0.016513 | 1.71 | 80.79 | 133.06 | 0.43 |
| reach_1 | .24983* | PMF | P-UBCC DS&Rail | 182.50 | 1.62 | 4.16 | | 4.29 | 0.014979 | 1.84 | 128.51 | 158.76 | 0.42 |
| reach_1 | 0.1591 | 100 YR ARI | P-UBCC DS&Rail | 100.90 | 1.60 | 3.44 | 3.44 | 3.70 | 0.048296 | 2.59 | 53.14 | 96.67 | 0.71 |
| reach_1 | 0.1591 | 100 YR ARI | Beach Berm | 100.90 | 2.30 | 4.07 | 3.48 | 4.11 | 0.005001 | 0.93 | 122.88 | 158.65 | 0.24 |
| reach_1 | 0.1591 | PMF | P-UBCC DS&Rail | 182.50 | 1.60 | 3.72 | 3.72 | 4.05 | 0.048294 | 2.94 | 82.89 | 117.00 | 0.73 |
| reach_1 | 0.1591 | PMF | Beach Berm | 182.50 | 2.30 | 4.43 | 3.76 | 4.49 | 0.005001 | 1.07 | 181.60 | 166.54 | 0.25 |

The page features a dark blue curved shape on the left side and a light blue vertical bar on the right side.

Annex B

B. Creek Design Plans

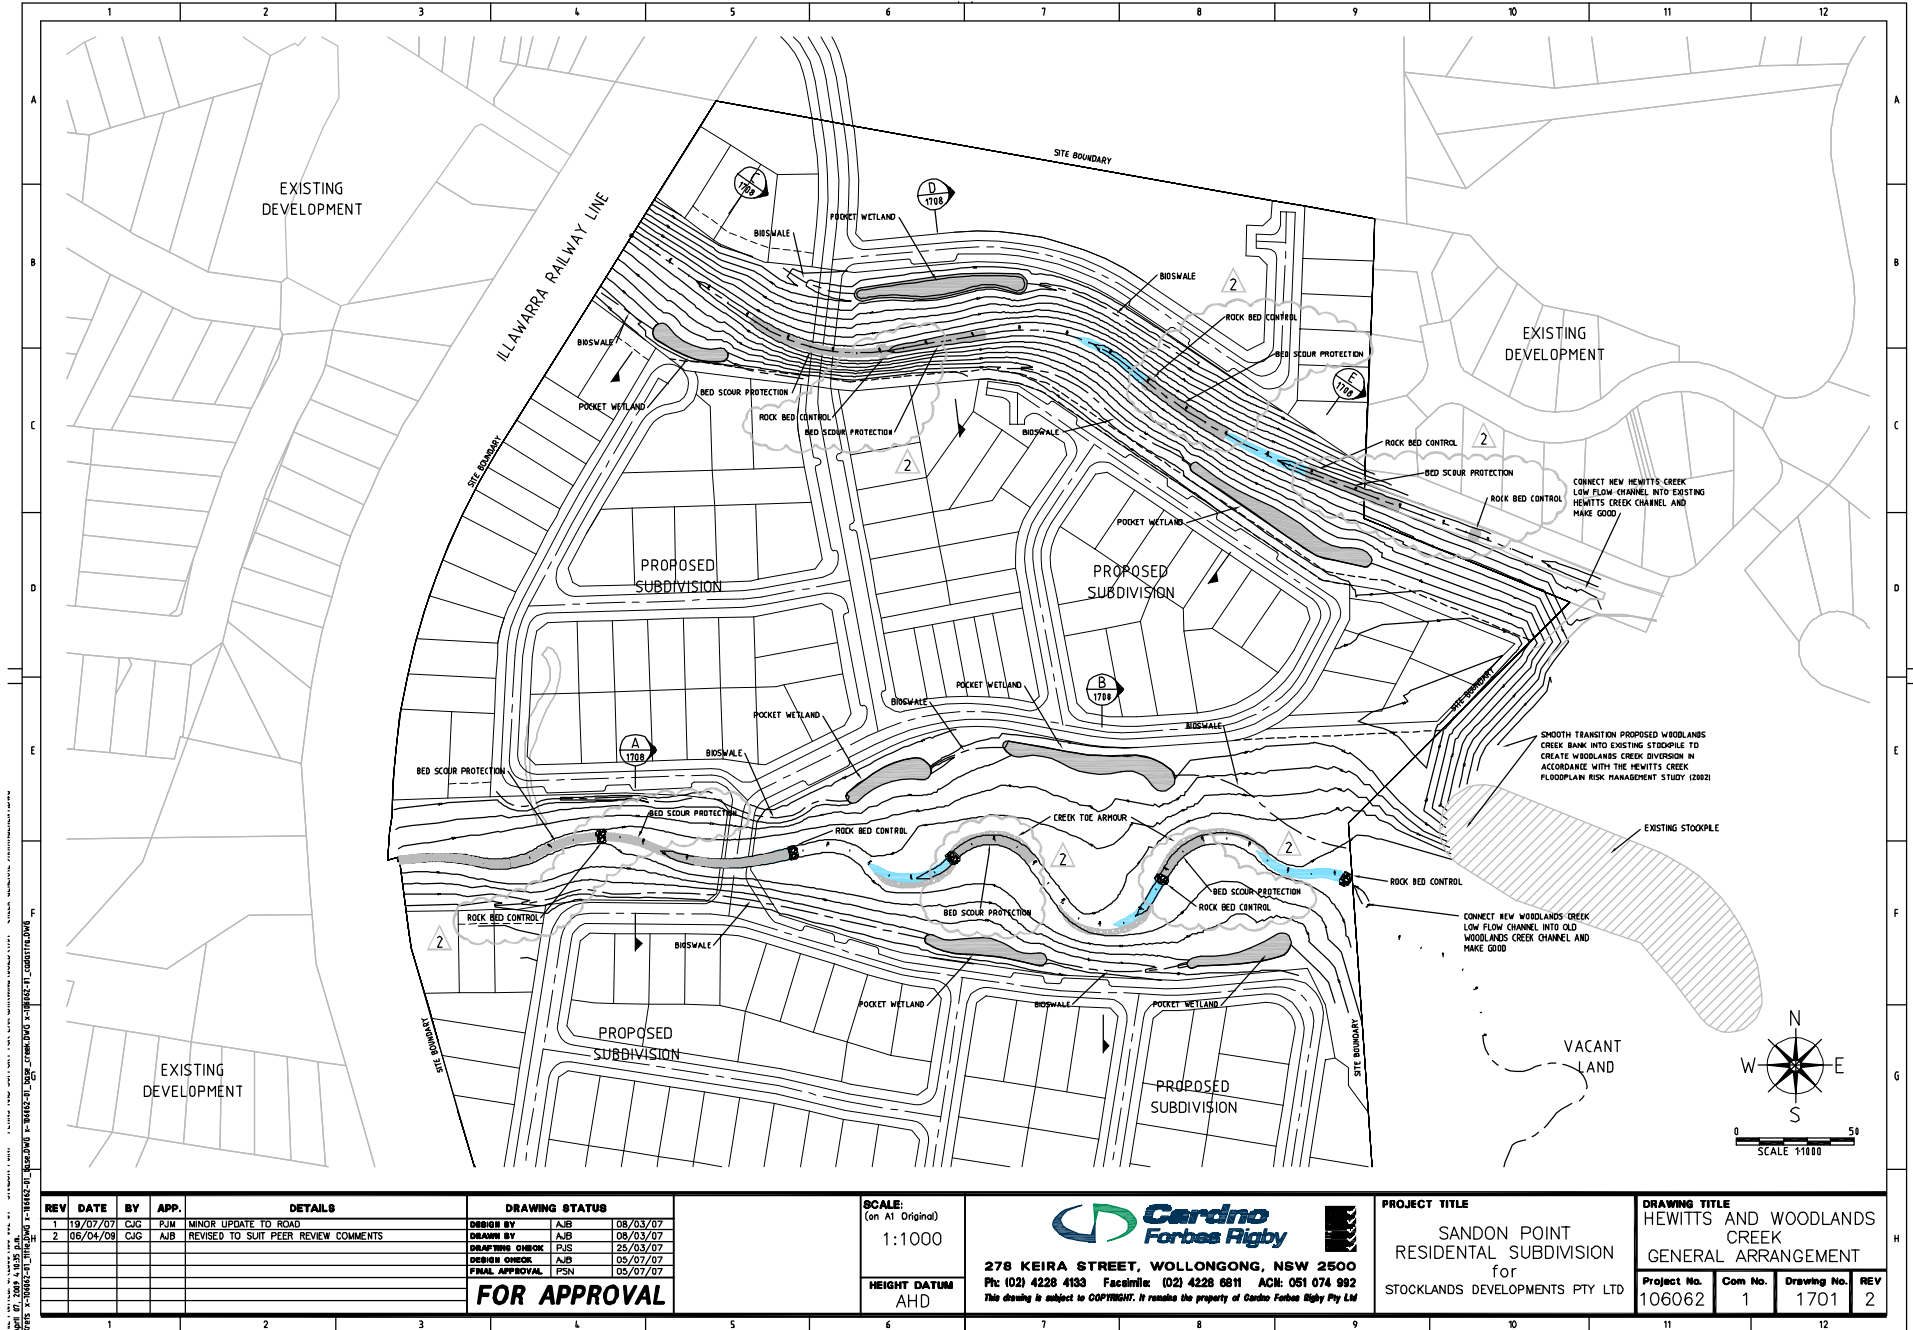

ILLAWARRA RAILWAY LINE
SITE BOUNDARY
EXISTING DEVELOPMENT
PROPOSED SUBDIVISION
POCKET WETLAND
BIO-SWALE
BED SCOUR PROTECTION
ROCK BED CONTROL
CREEK TOE ARMOUR
VACANT LAND
N
W
E
S
SCALE 1:1000

| REV | DATE | BY | APP. | DETAILS |
|-----|----------|-----|------|--------------------------------------|
| 1 | 19/07/07 | CAC | PJM | MINOR UPDATE TO ROAD |
| 2 | 06/04/09 | CAC | AJB | REVISED TO SUIT PEER REVIEW COMMENTS |
| | | | | |
| | | | | |
| | | | | |
| | | | | |
| | | | | |
| | | | | |
| | | | | |
| | | | | |


| DRAWING STATUS | | |
|---------------------|-----|----------|
| DESIGN BY | AJB | 08/03/07 |
| DRAWN BY | AJB | 08/03/07 |
| DRAWING CHECK | PJS | 25/03/07 |
| DESIGN CHECK | AJB | 05/07/07 |
| FINAL APPROVAL | PSN | 05/07/07 |
| FOR APPROVAL | | |

| | |
|---|---------------------|
| SCALE: (on A1 Original) 1:1000 | HEIGHT DATUM AHD |
|---|---------------------|

Cardno Forbes Rigby
278 KEIRA STREET, WOLLONGONG, NSW 2500
Ph: (02) 4228 4133 Facsimile: (02) 4228 6811 ACN: 051 074 992
This drawing is subject to COPYRIGHT. It remains the property of Cardno Forbes Rigby Pty Ltd


| |
|---|
| PROJECT TITLE |
| SARDON POINT RESIDENTIAL SUBDIVISION for STOCKLANDS DEVELOPMENTS PTY LTD |

| | | | |
|---|----------------|--------------------|------------|
| DRAWING TITLE | | | |
| HEWITTS AND WOODLANDS CREEK GENERAL ARRANGEMENT | | | |
| Project No. | Com No. | Drawing No. | REV |
| 106062 | 1 | 1701 | 2 |

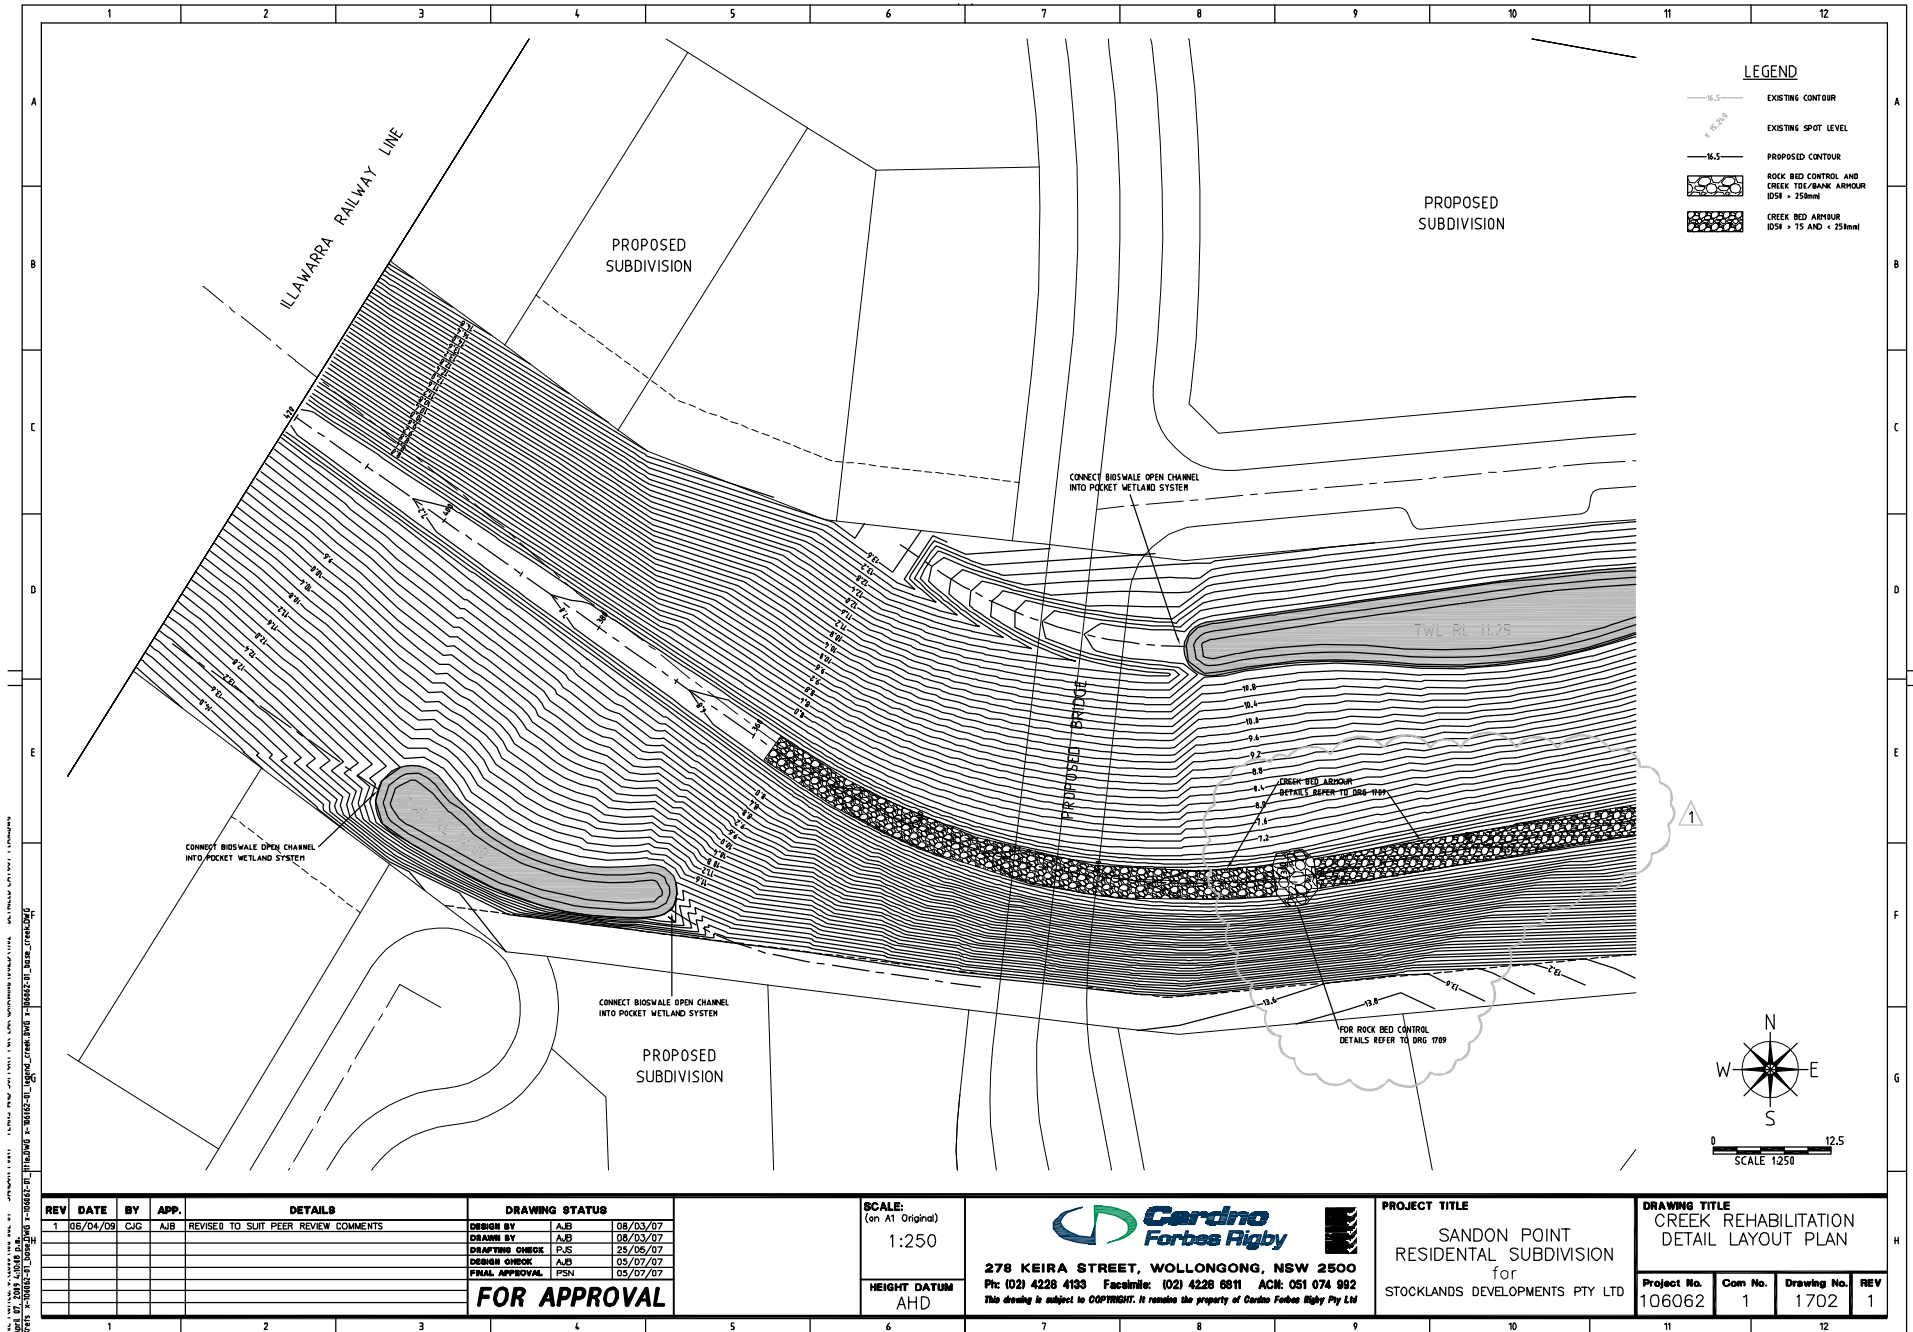

LEGEND

- EXISTING CONTOUR
- EXISTING SPOT LEVEL
- PROPOSED CONTOUR
- ROCK BED CONTROL AND CREEK TOE/BANK ARMOUR (DSH + 250mm)
- CREEK BED ARMOUR (DSH + 15 AND + 250mm)

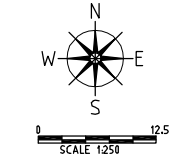

| REV | DATE | BY | APP. | DETAILS |
|-----|----------|-----|------|--------------------------------------|
| 1 | 06/04/09 | CJC | AJB | REVISED TO SLAT PEER REVIEW COMMENTS |
| | | | | |
| | | | | |
| | | | | |
| | | | | |
| | | | | |
| | | | | |
| | | | | |
| | | | | |
| | | | | |


| DRAWING STATUS | | |
|----------------|-----|----------|
| DESIGN BY | AJB | 08/03/07 |
| DRAWN BY | AJB | 08/03/07 |
| DRAFTING CHECK | PJS | 25/06/07 |
| DESIGN CHECK | AJB | 05/07/07 |
| FINAL APPROVAL | PSN | 05/07/07 |
| FOR APPROVAL | | |

SCALE:
(on A1 Original)
1:250
HEIGHT DATUM
AHD

Cardno
Forbes Rigby
278 KEIRA STREET, WOLLONGONG, NSW 2500
Ph: (02) 4228 4133 Facsimile: (02) 4228 6811 ACN: 051 074 982
This drawing is subject to COPYRIGHT. It remains the property of Cardno Forbes Rigby Pty Ltd

PROJECT TITLE
SANDON POINT
RESIDENTIAL SUBDIVISION
for
STOCKLANDS DEVELOPMENTS PTY LTD

| DRAWING TITLE | | | |
|--|---------|-------------|-----|
| CREEK REHABILITATION DETAIL LAYOUT PLAN | | | |
| Project No. | Com No. | Drawing No. | REV |
| 106062 | 1 | 1702 | 1 |

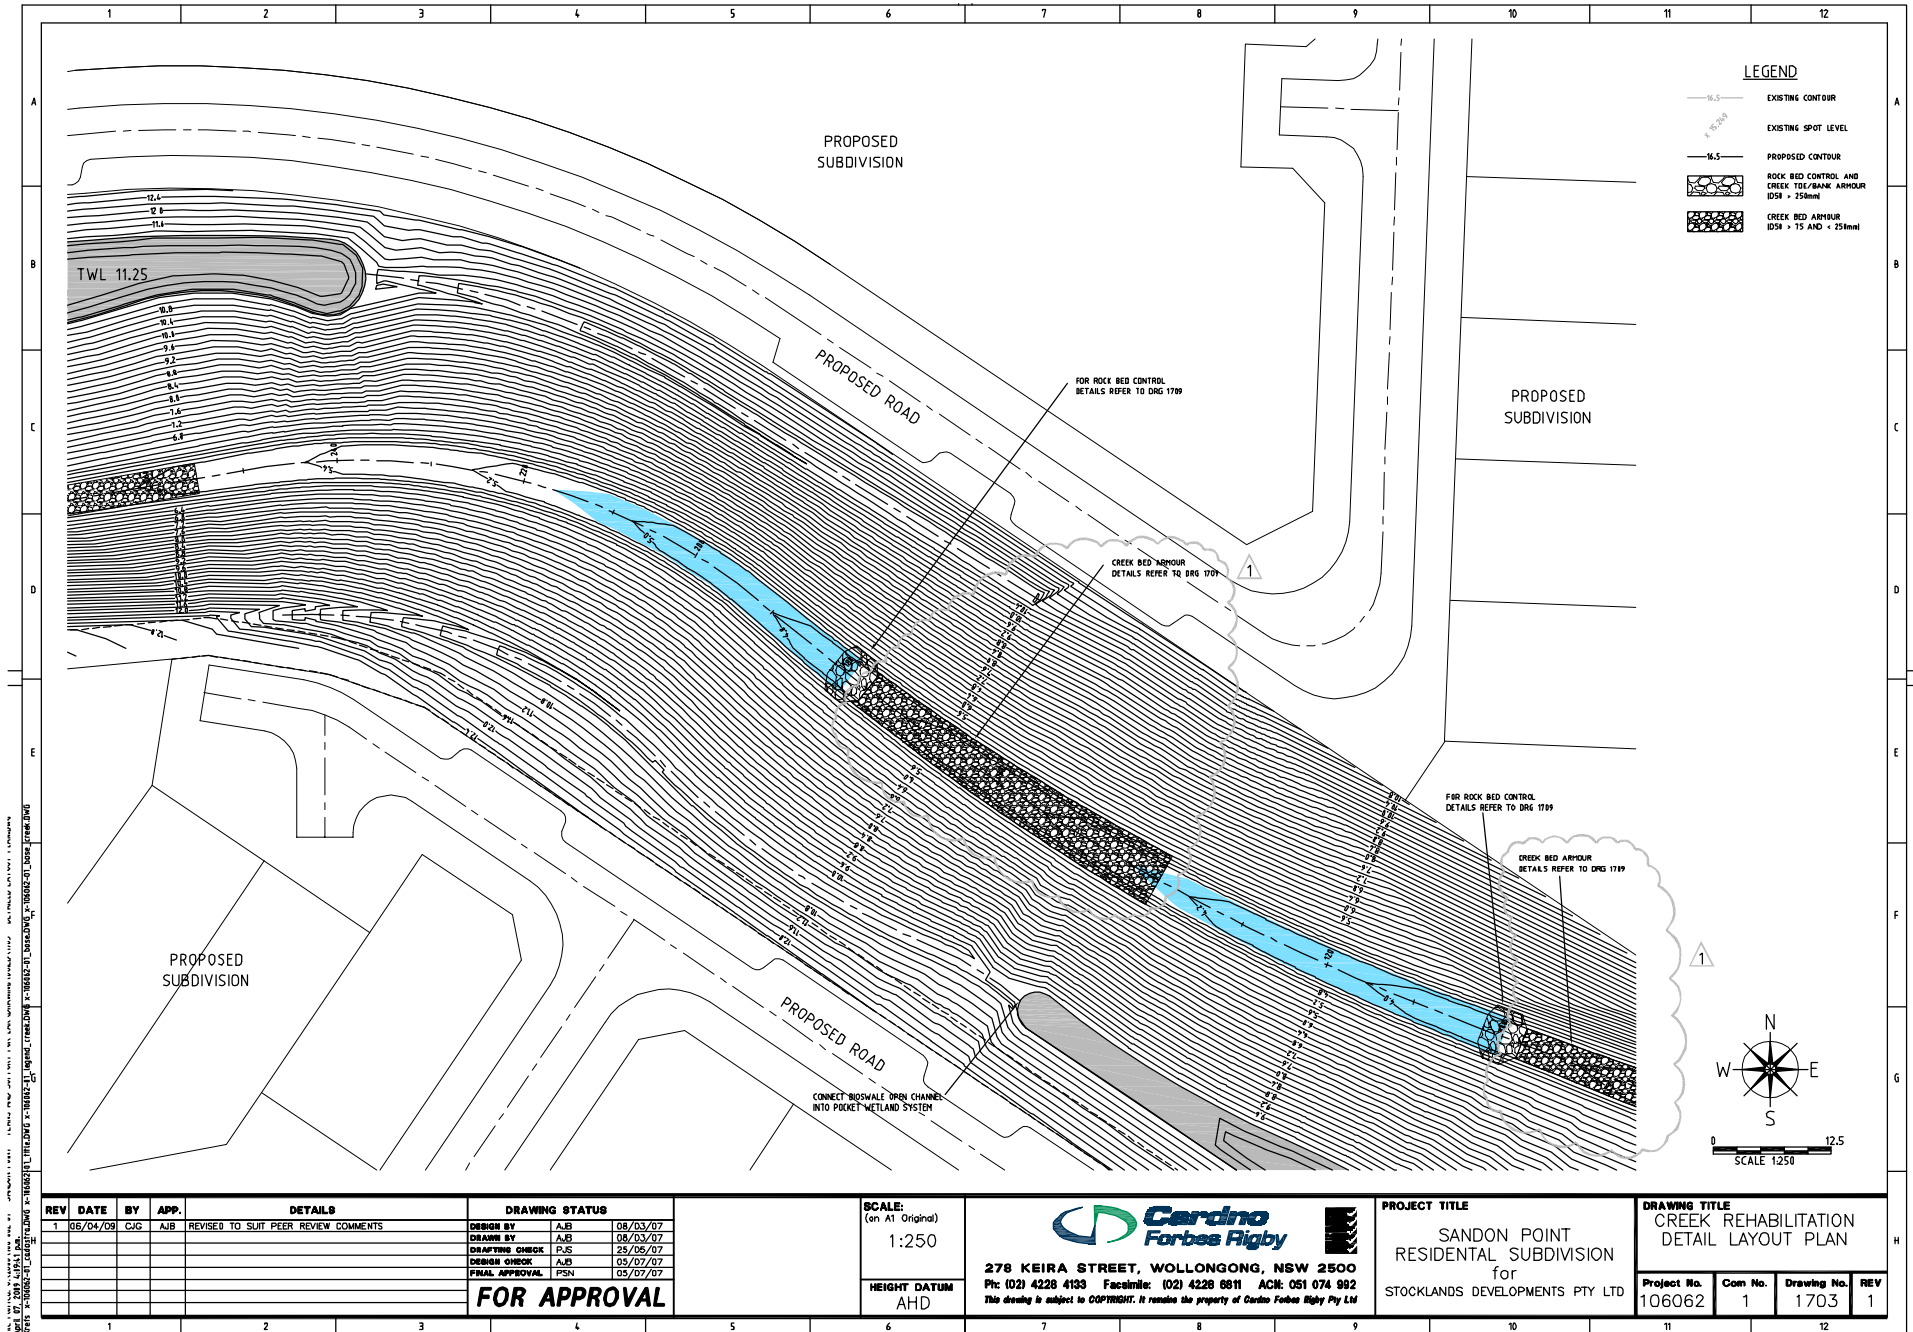

| REV | DATE | BY | APP. | DETAILS |
|-----|----------|-----|------|--------------------------------------|
| 1 | 06/04/09 | CJC | AJB | REVISED TO SLAT PEER REVIEW COMMENTS |
| | | | | |
| | | | | |
| | | | | |
| | | | | |
| | | | | |
| | | | | |
| | | | | |
| | | | | |
| | | | | |

| DRAWING STATUS | | |
|----------------|-----|----------|
| DESIGN BY | AJB | 08/03/07 |
| DRAWN BY | AJB | 08/03/07 |
| DRAFTING CHECK | PJS | 25/06/07 |
| DESIGN CHECK | AJB | 05/07/07 |
| FINAL APPROVAL | PSN | 05/07/07 |

FOR APPROVAL


SCALE:
(on A1 Original)
1:250

HEIGHT DATUM
AHD

Cardno
Forbes Rigby
278 KEIRA STREET, WOLLONGONG, NSW 2500
Ph: (02) 4228 4133 Facsimile: (02) 4228 6811 ACN: 051 074 982
This drawing is subject to COPYRIGHT. It remains the property of Cardno Forbes Rigby Pty Ltd


PROJECT TITLE
SANDON POINT
RESIDENTIAL SUBDIVISION
for
STOCKLANDS DEVELOPMENTS PTY LTD

| DRAWING TITLE | | | |
|--|---------|-------------|-----|
| CREEK REHABILITATION DETAIL LAYOUT PLAN | | | |
| Project No. | Com No. | Drawing No. | REV |
| 106062 | 1 | 1703 | 1 |

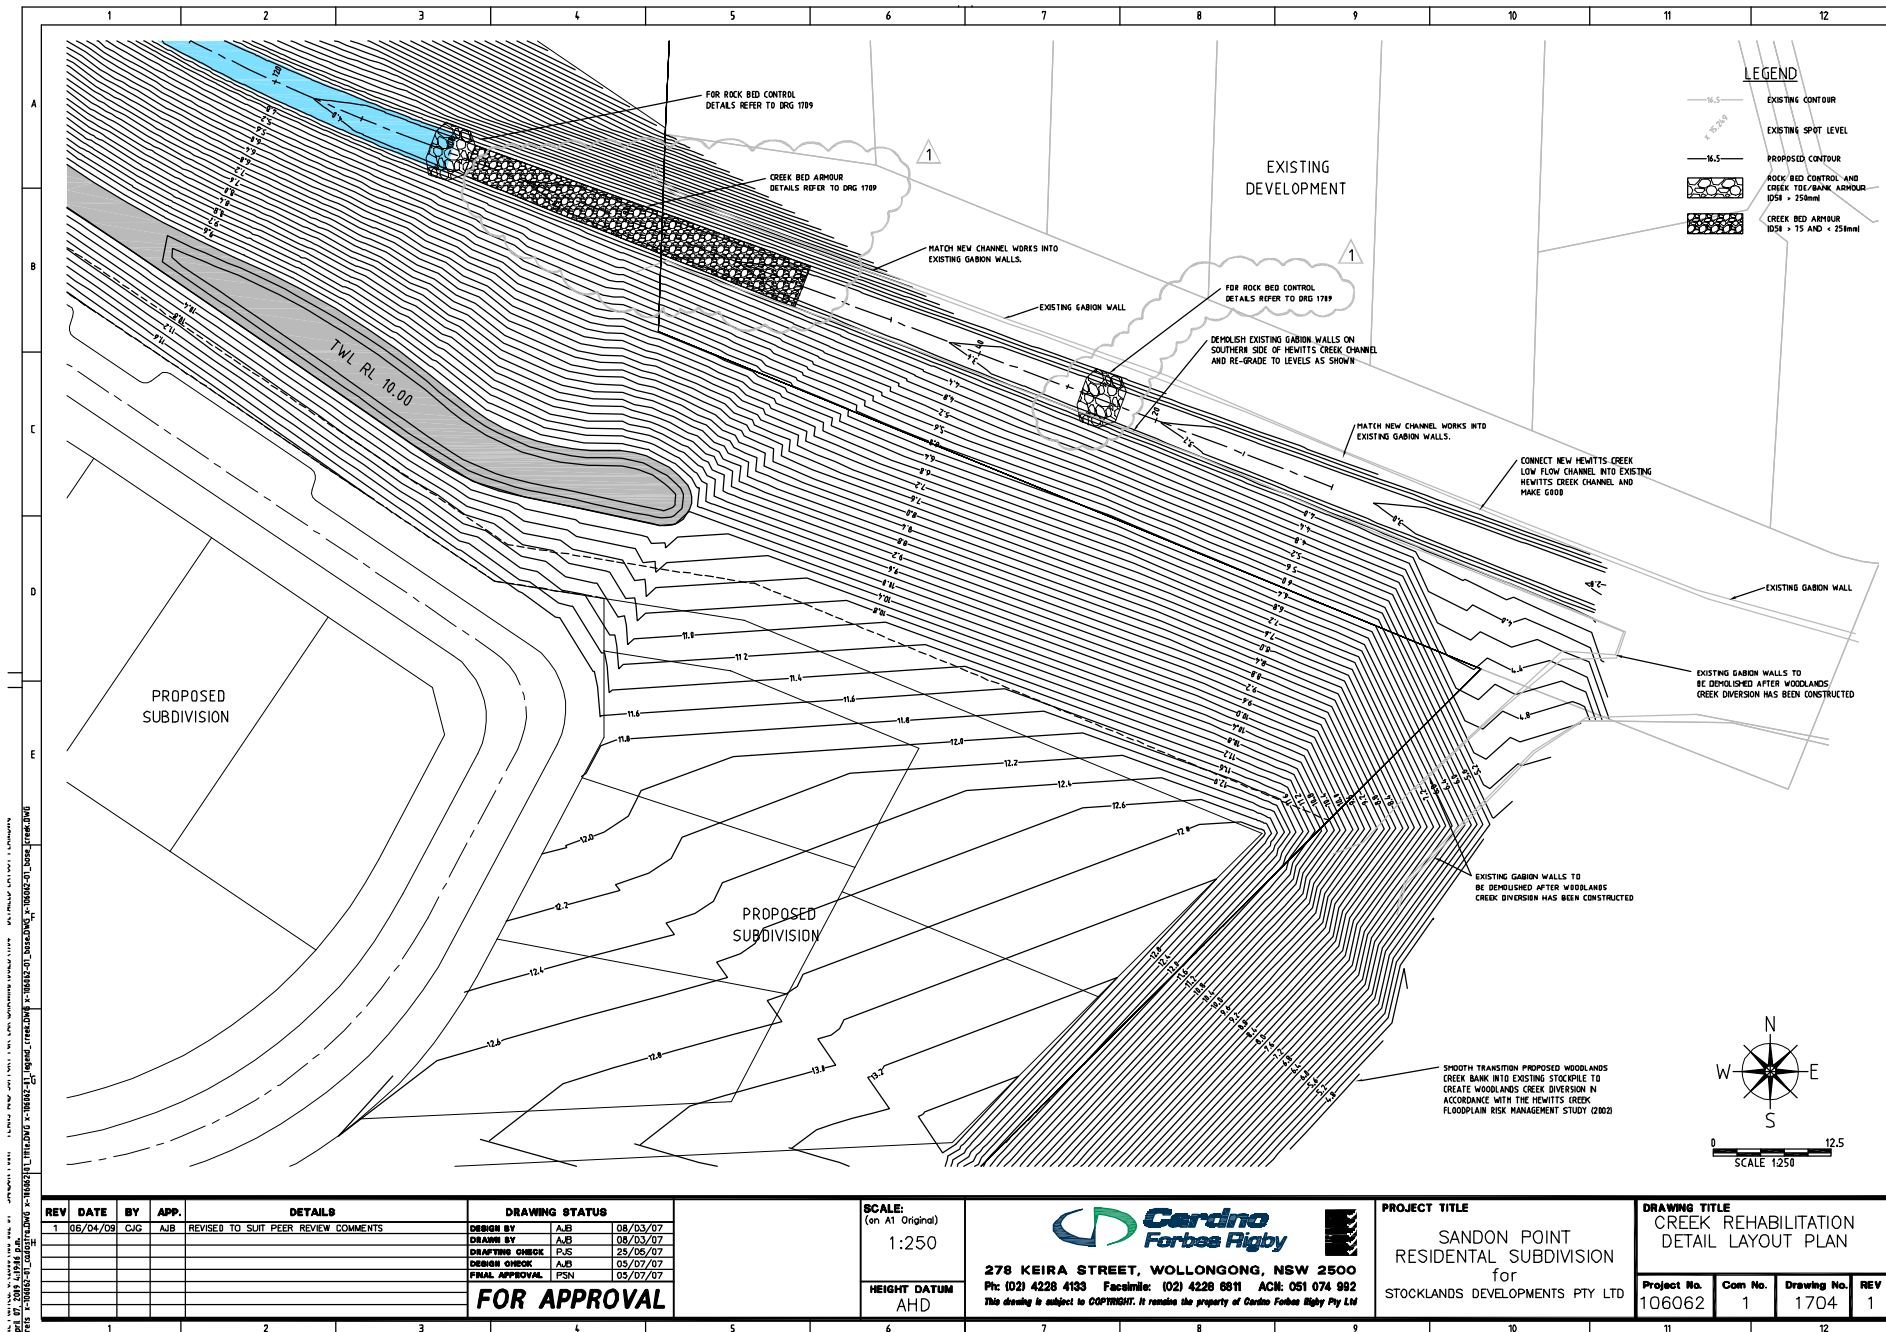


LEGEND

- EXISTING CONTOUR
- EXISTING SPOT LEVEL
- PROPOSED CONTOUR
- ROCK BED CONTROL AND CREEK TIE/BANK ARMOUR 1054 + 250mm
- CREEK BED ARMOUR 1054 + 15 AND + 250mm

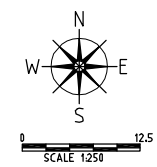

| REV | DATE | BY | APP. | DETAILS | DRAWING STATUS | SCALE: | PROJECT TITLE | DRAWING TITLE |
|--------------|----------|-------------|------|--------------------------------------|---|---------------------------|---|--|
| 1 | 06/04/09 | CJC | AJB | REVISED TO SLAT PEER REVIEW COMMENTS | DESIGN BY: AJB 08/03/07 DRAWN BY: AJB 08/03/07 DRAFTING CHECK: PJS 25/06/07 DESIGN CHECK: AJS 05/07/07 FINAL APPROVAL: PSN 05/07/07 | (on A1 Original) 1:250 | SANDON POINT RESIDENTIAL SUBDIVISION for STOCKLANDS DEVELOPMENTS PTY LTD | CREEK REHABILITATION DETAIL LAYOUT PLAN |
| FOR APPROVAL | | | | | | HEIGHT DATUM AHD | | |
| Project No. | Com No. | Drawing No. | REV | | | | | |
| 106062 | 1 | 1704 | 1 | | | | | |



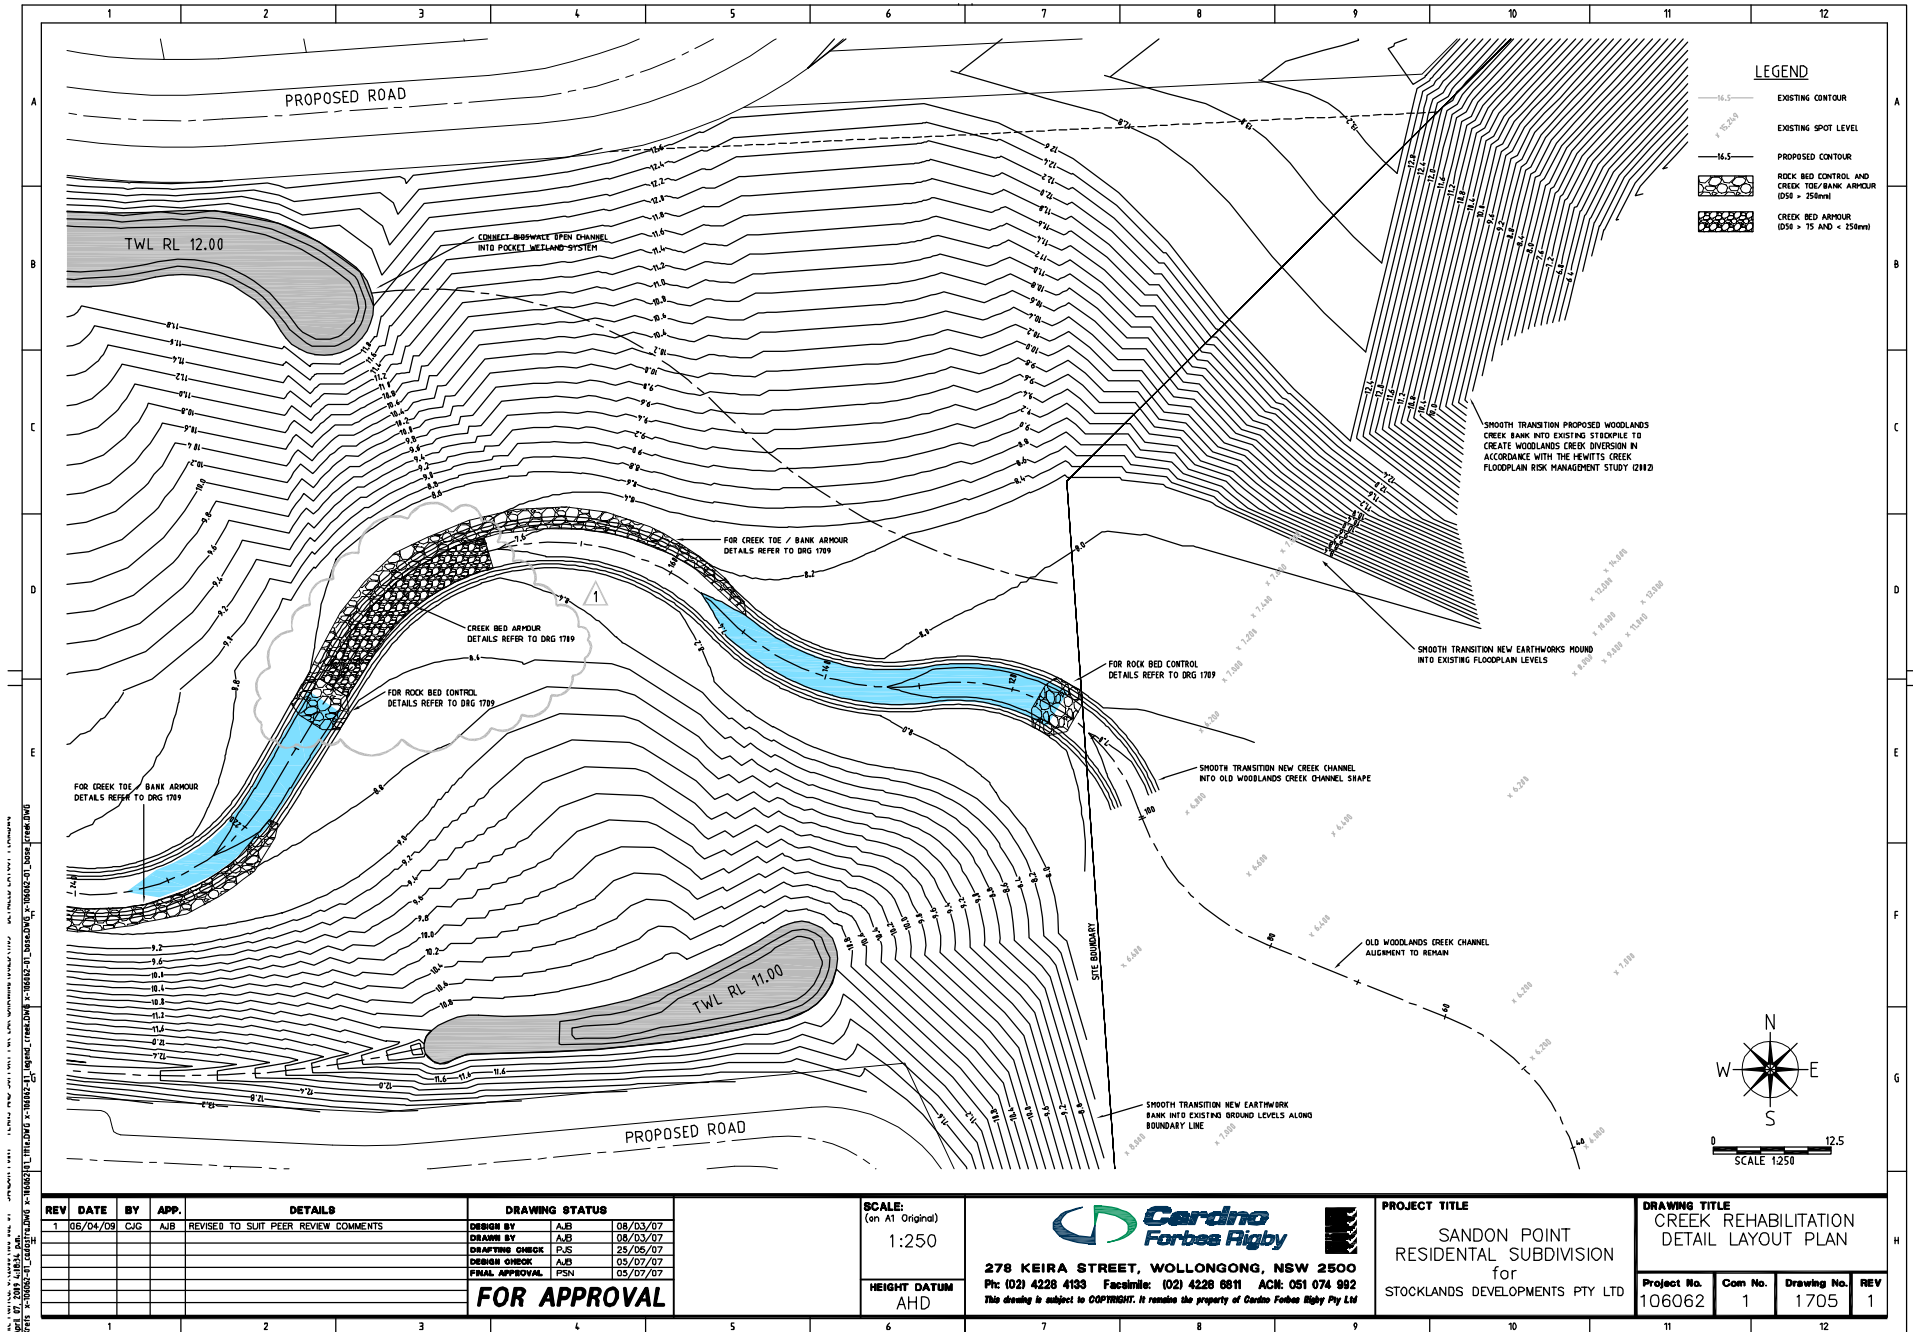

DATE: 06/04/09
DRAWN BY: CJC
CHECKED BY: AJS
DESIGNED BY: AJS
PROJECT NO: 106062
DRAWING NO: 1705
REV: 1

| REV | DATE | BY | APP. | DETAILS |
|-----|----------|-----|------|--------------------------------------|
| 1 | 06/04/09 | CJC | AJS | REVISED TO SLAT PEER REVIEW COMMENTS |
| | | | | |
| | | | | |
| | | | | |
| | | | | |
| | | | | |
| | | | | |
| | | | | |
| | | | | |
| | | | | |

| DRAWING STATUS | | |
|----------------|-----|----------|
| DESIGN BY | AJS | 06/03/07 |
| DRAWN BY | AJS | 06/03/07 |
| DRAFTING CHECK | PJS | 25/06/07 |
| DESIGN CHECK | AJS | 05/07/07 |
| FINAL APPROVAL | PSN | 05/07/07 |


FOR APPROVAL


SCALE:
(on A1 Original)
1:250
HEIGHT DATUM
AHD

Cardno
Forbes Rigby
278 KEIRA STREET, WOLLONGONG, NSW 2500
Ph: (02) 4228 4133 Facsimile: (02) 4228 6811 ACN: 051 074 982
This drawing is subject to COPYRIGHT. It remains the property of Cardno Forbes Rigby Pty Ltd


PROJECT TITLE
SARDON POINT
RESIDENTIAL SUBDIVISION
for
STOCKLANDS DEVELOPMENTS PTY LTD

| DRAWING TITLE CREEK REHABILITATION DETAIL LAYOUT PLAN | | | |
|---|---------|-------------|-----|
| Project No. | Com No. | Drawing No. | REV |
| 106062 | 1 | 1705 | 1 |

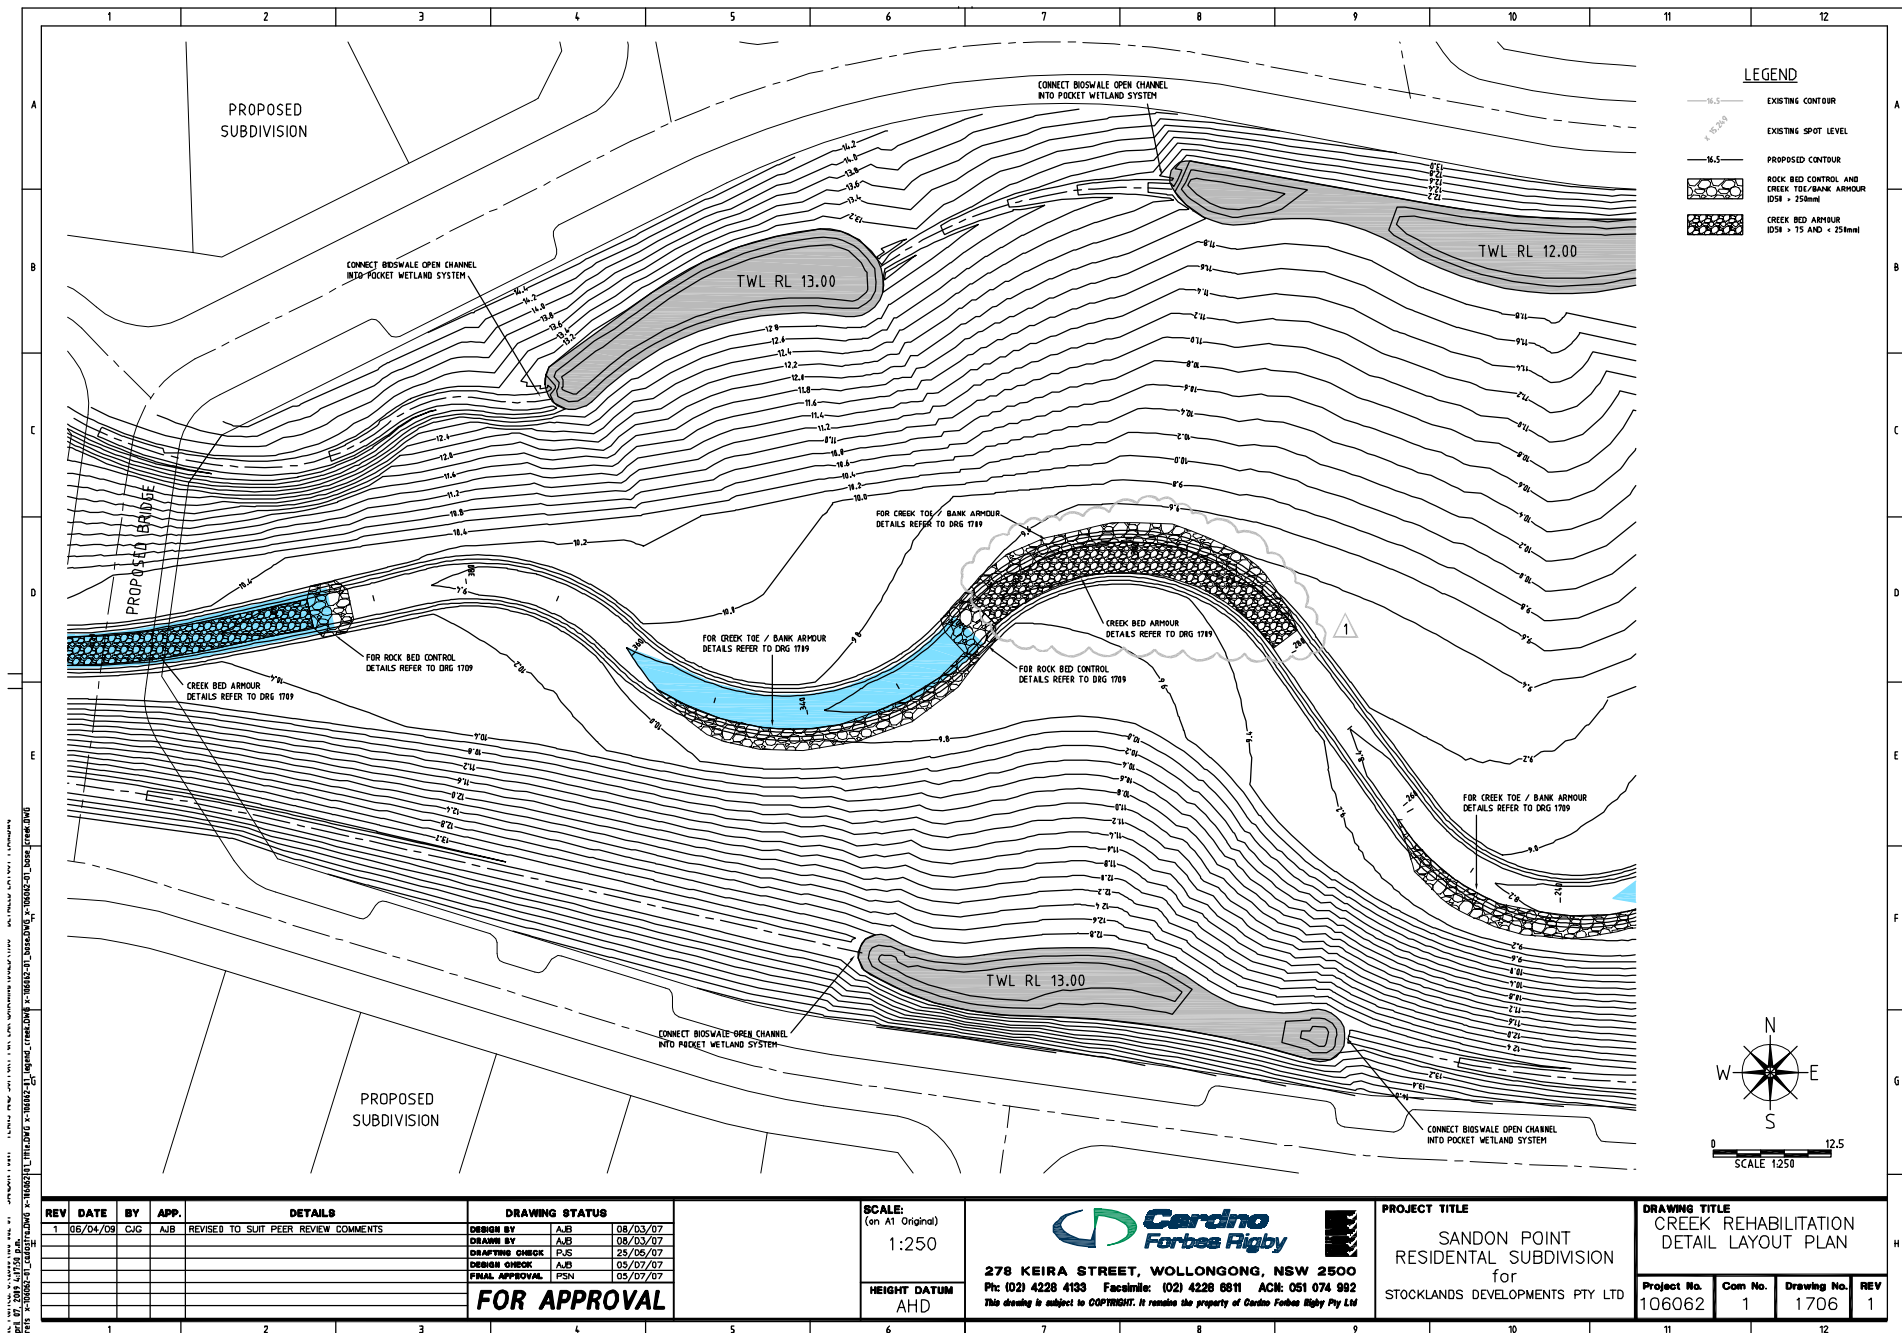


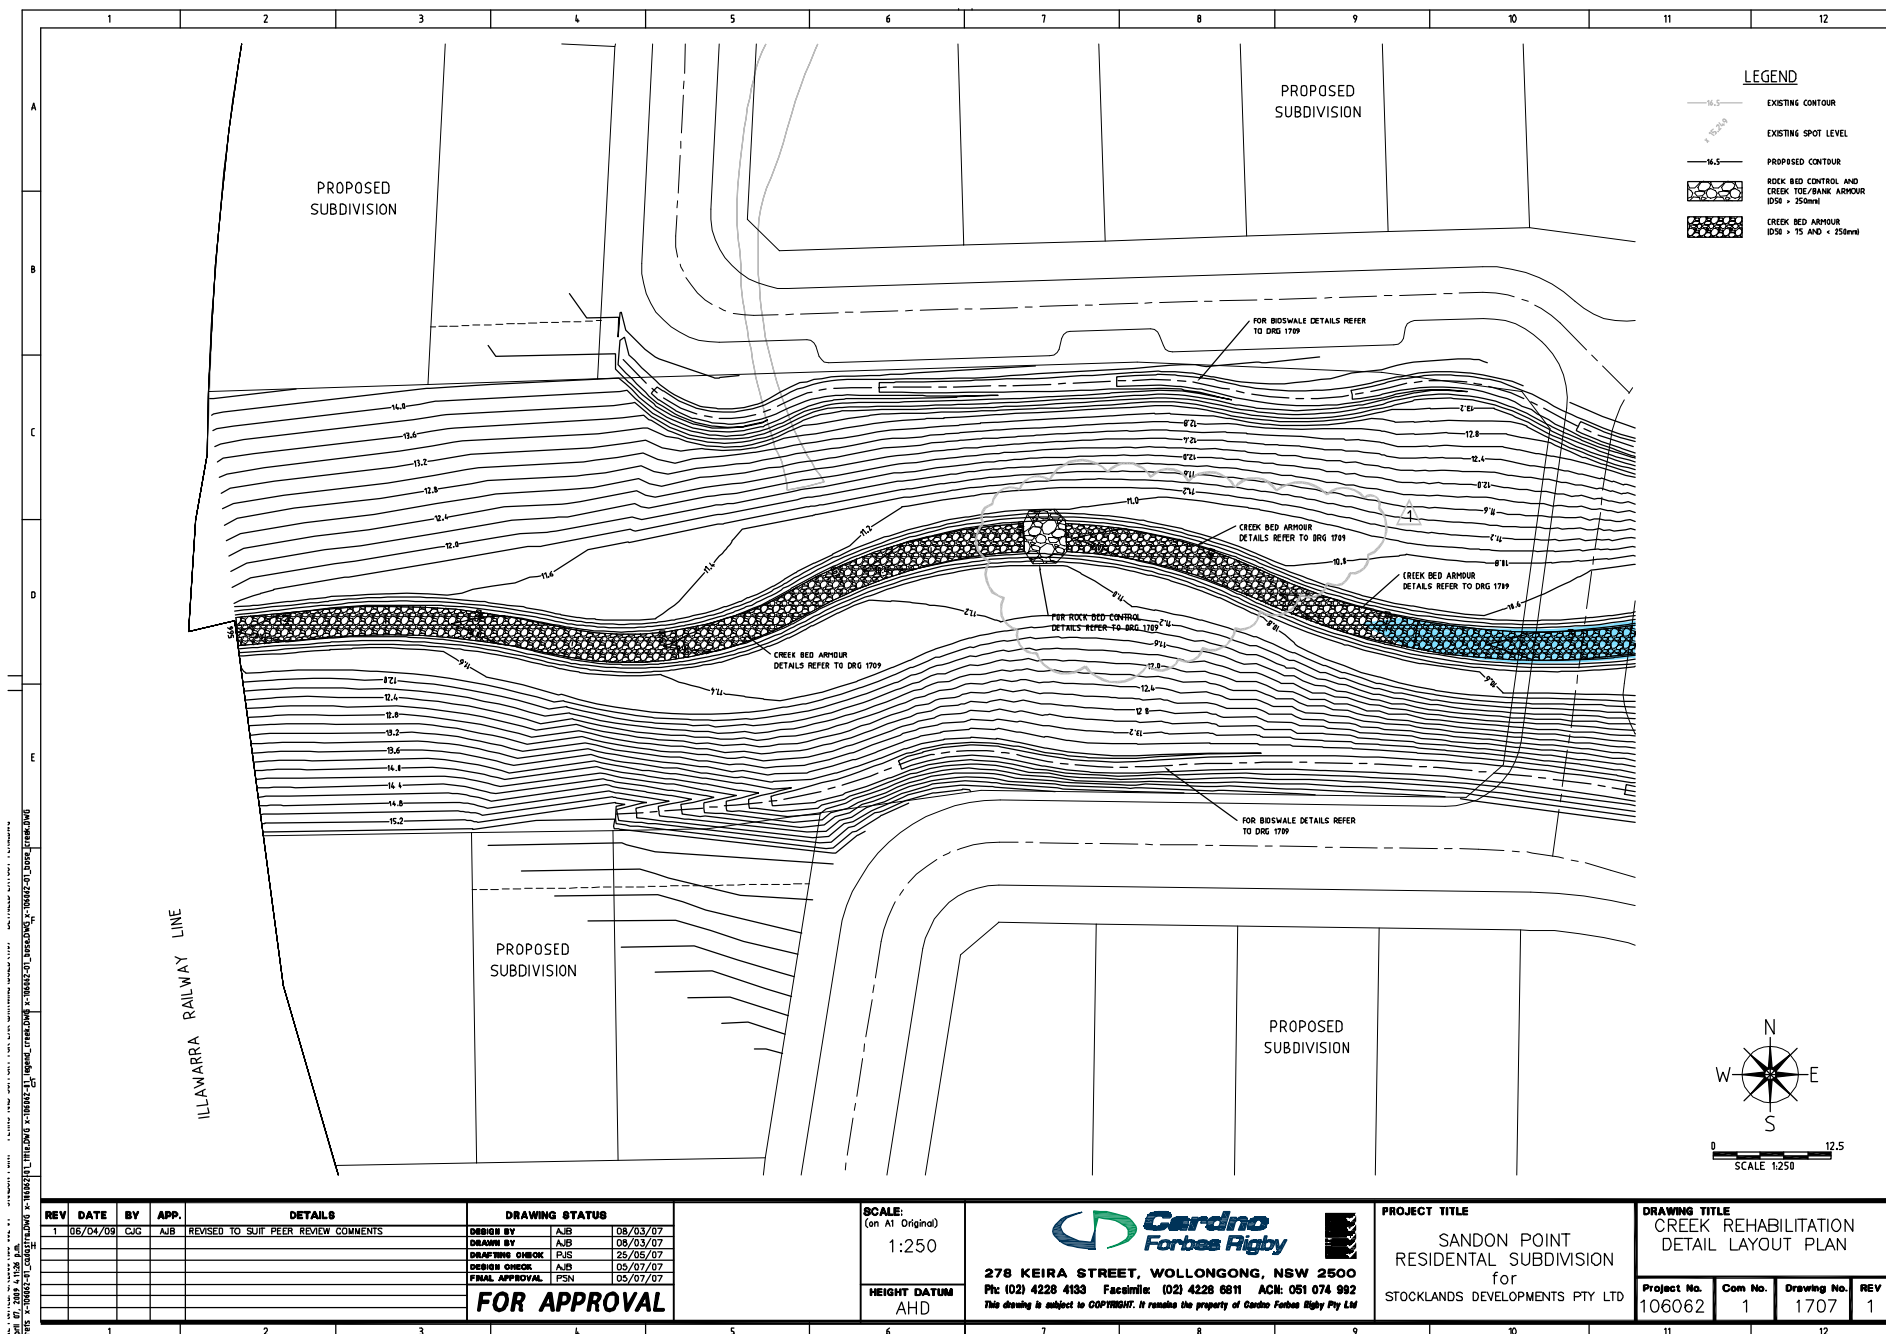


| | | | | | | | | | | | |
|---|---|---|---|---|---|---|---|---|----|----|----|
| 1 | 2 | 3 | 4 | 5 | 6 | 7 | 8 | 9 | 10 | 11 | 12 |
|---|---|---|---|---|---|---|---|---|----|----|----|

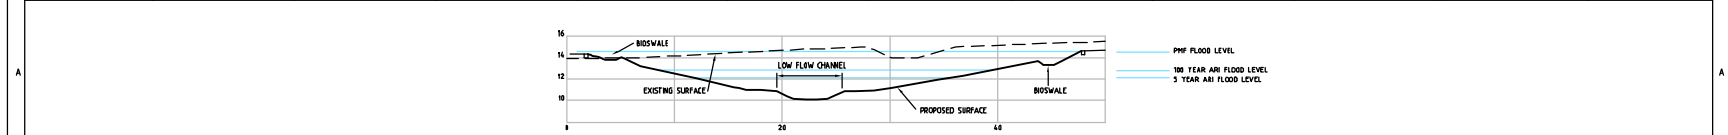


SECTION A
SCALE 1/200 1701

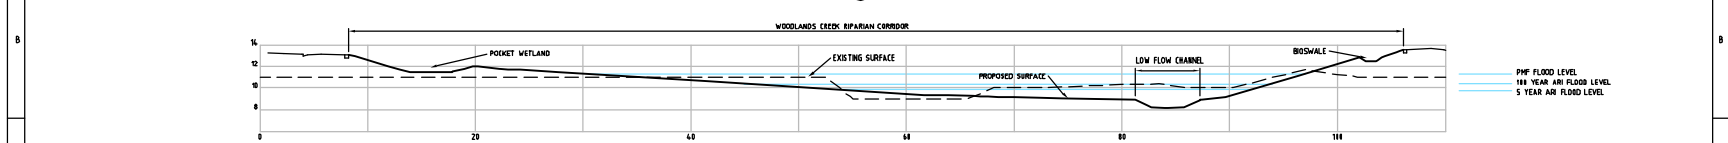



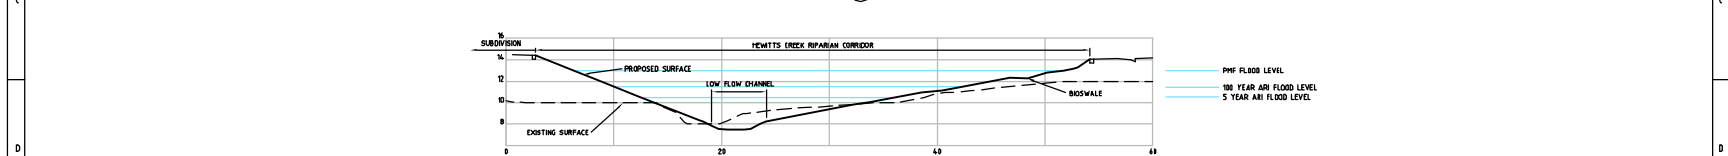


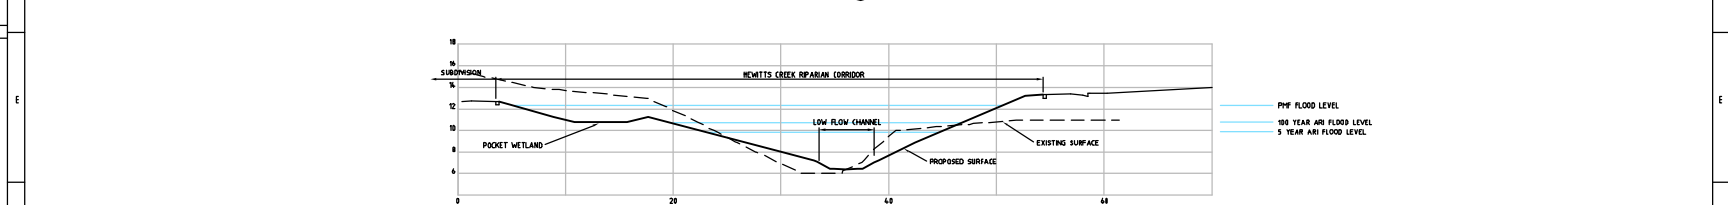


SECTION D
SCALE 1:200 1701

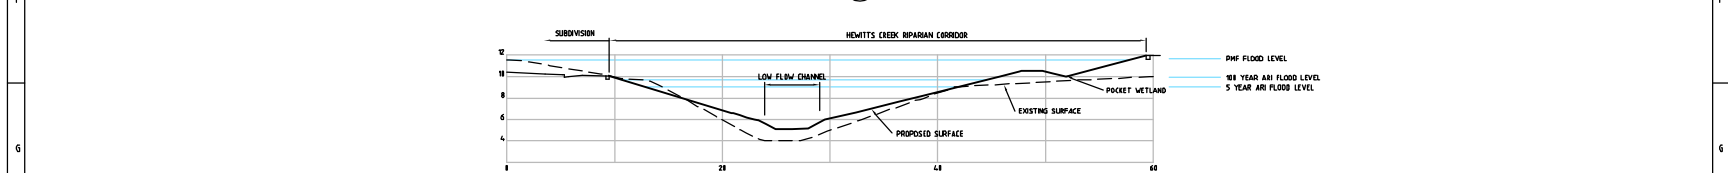

SECTION E
SCALE 1:200


0 10
SCALE 1:200

| | | | | | | | | | | | | |
|-----|------|----|------|---------|---|--|---|---|-------------------------|---------|-------------|-----|
| REV | DATE | BY | APP. | DETAILS | DRAWING STATUS | SCALE: (con A11 Original) 1:200N |  FORBES RIGBY PTY LTD Engineers, Planners & Scientists <i>Dually Licensed Company, R001 P91 QIC 0006, (Standard Australia)</i> 278 KEIRA STREET, WOLLONGONG, NSW 2500 Ph: (02) 4228 4133 Facsimile: (02) 4228 8811 ACN 008 936 981 <i>This drawing is subject to COPYRIGHT. It remains the property of Forbes Rigby Pty Ltd</i> | PROJECT TITLE | DRAWING TITLE | | | |
| | | | | | DESIGNED BY AJB 08/03/07 DRAWN BY AJB 08/03/07 CHECKED BY PJS 23/05/07 DESIGNED BY AJB 08/07/07 FINAL APPROVAL PJS 09/07/07 | HEIGHT DATUM AHD | | SANDON POINT RESIDENTIAL SUBDIVISION for STOCKLANDS DEVELOPMENTS PTY LTD | CREEK CROSS SECTIONS | | | |
| | | | | | | | | | Project No. | Com No. | Drawing No. | REV |
| | | | | | | | | | 106062 | 1 | 1708 | 0 |


| | | | | | | | | | | | |
|---|---|---|---|---|---|---|---|---|----|----|----|
| 1 | 2 | 3 | 4 | 5 | 6 | 7 | 8 | 9 | 10 | 11 | 12 |
|---|---|---|---|---|---|---|---|---|----|----|----|

1888

| | | | | | | | | | | | |
|---|---|---|---|---|---|---|---|---|----|----|----|
| 1 | 2 | 3 | 4 | 5 | 6 | 7 | 8 | 9 | 10 | 11 | 12 |
|---|---|---|---|---|---|---|---|---|----|----|----|

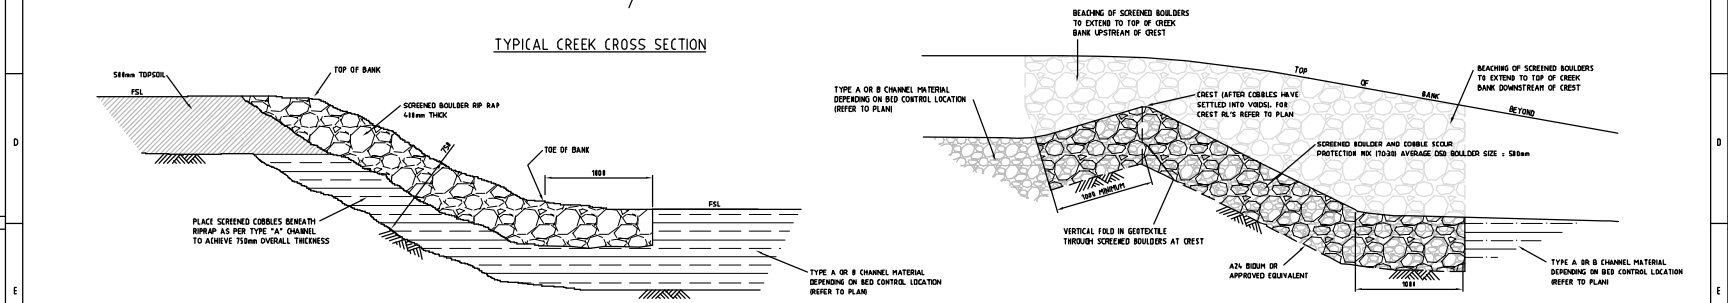


TYPICAL ROCK BED CONTROL

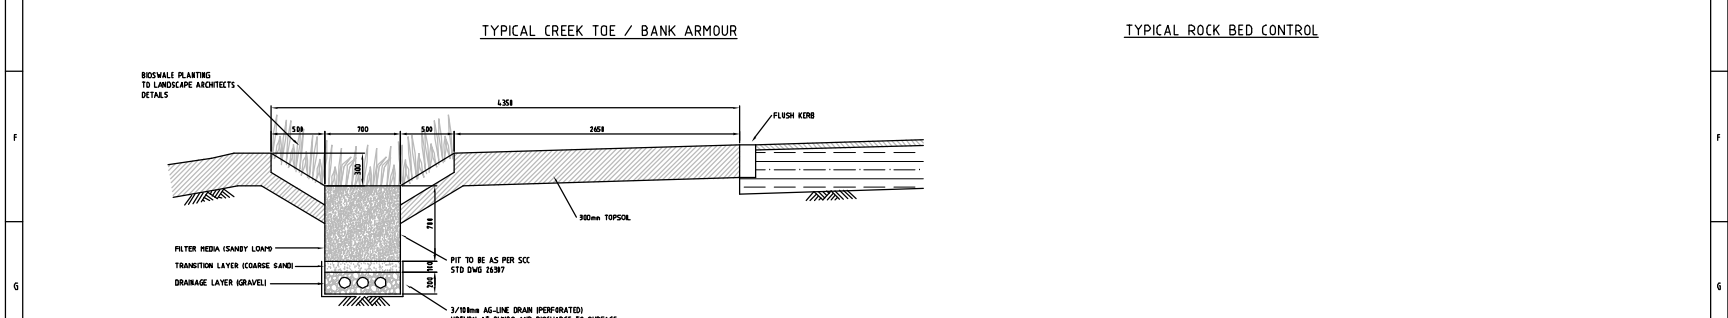


TYPICAL BIOSWALE DETAIL



DO NOT SCALE IF IN DOUBT ASK

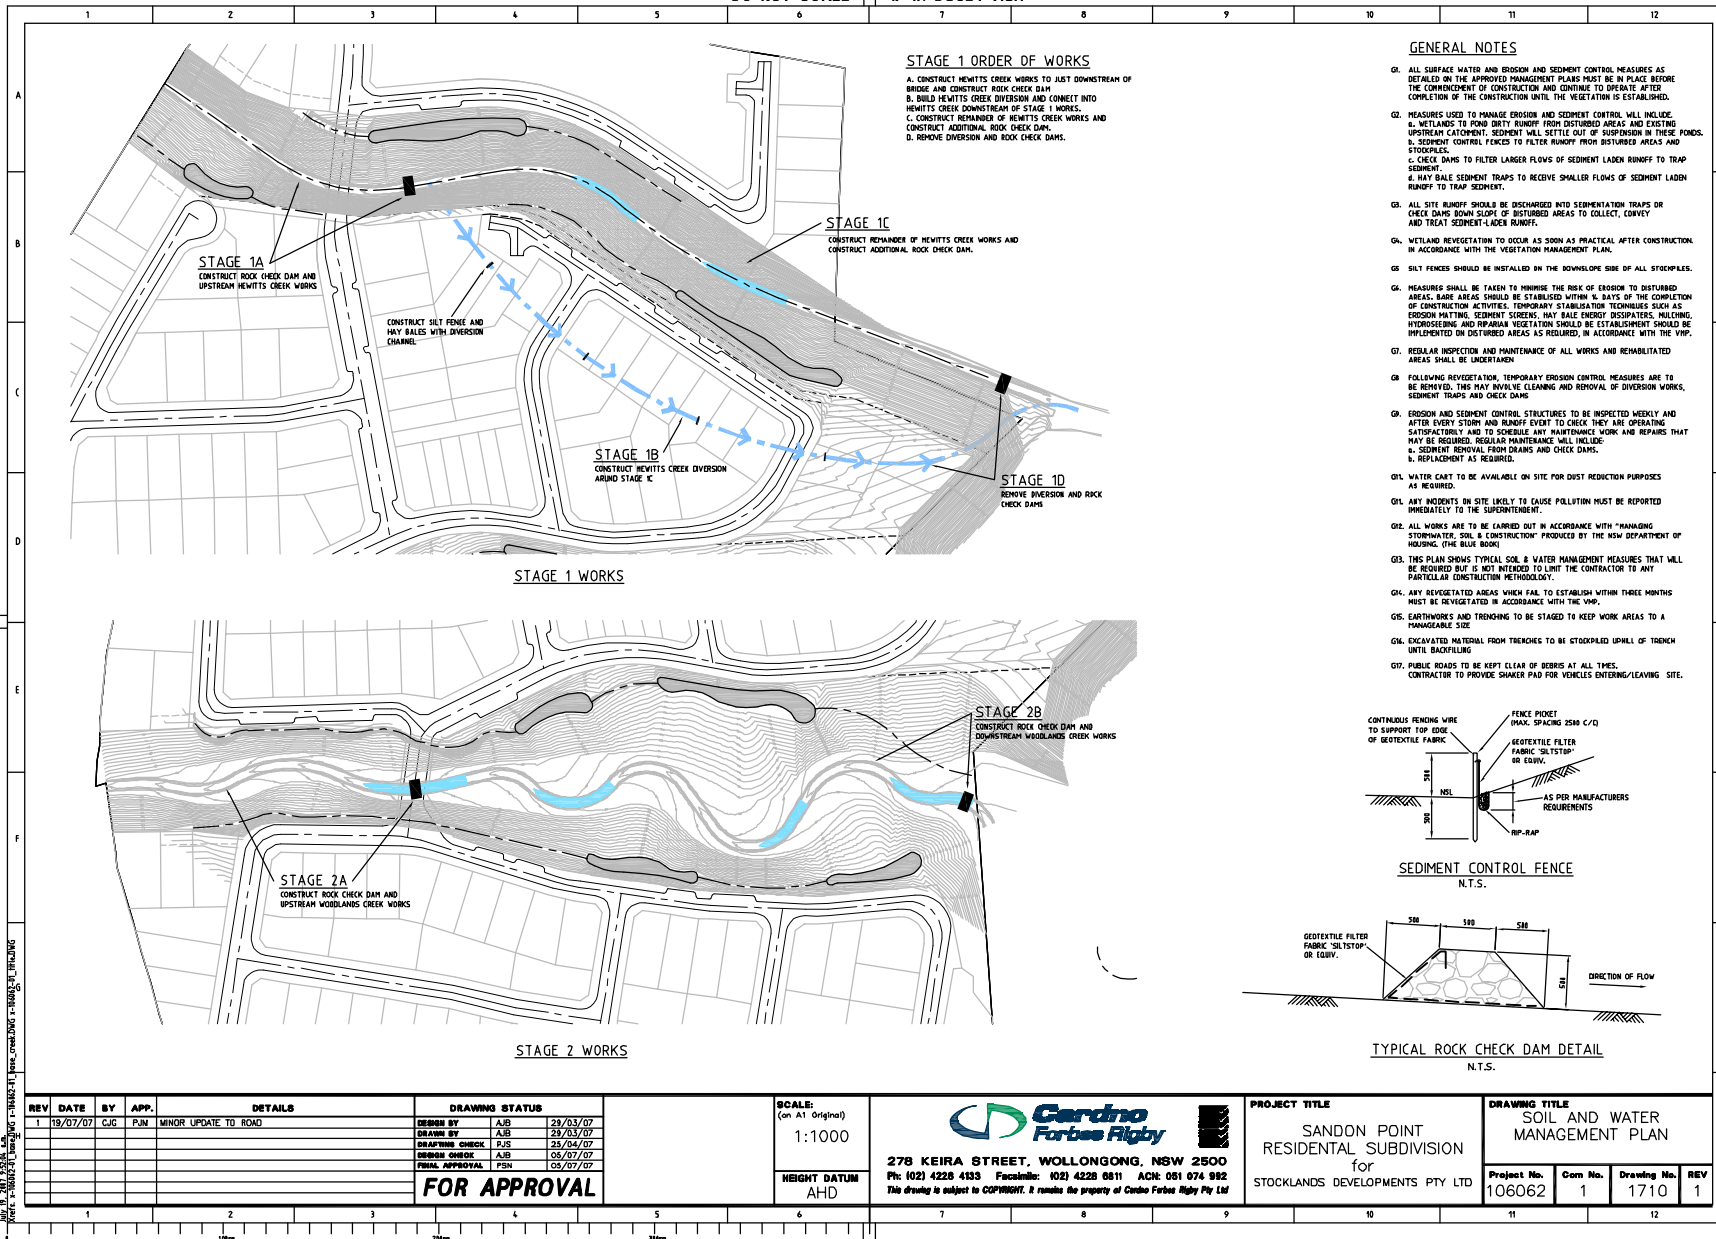

DO NOT SCALE IF IN DOUBT ASK

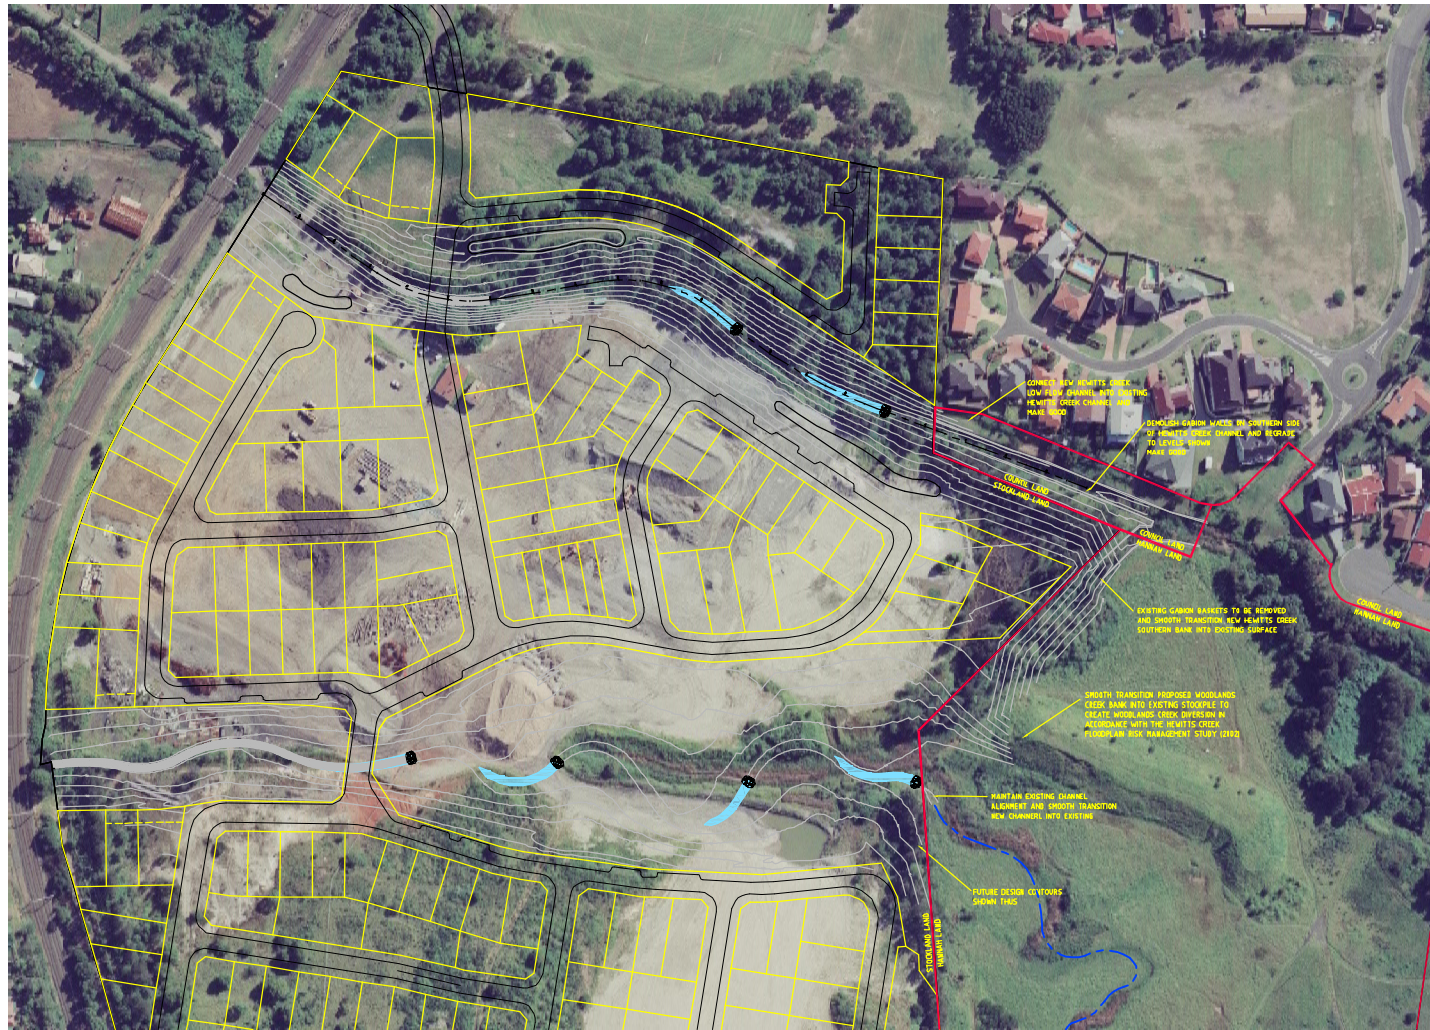

FILE PATH: I:\SUBMIT-42-41 - SANDON POINT - PLANS AND SUPPORT FOR EAS/UNIMOD/DA/1711 - TAIL OUT WORKS ON DOWNSTREAM LANDS
POINT - 1711-41 - SANDON POINT - PLANS AND SUPPORT FOR EAS/UNIMOD/DA/1711 - TAIL OUT WORKS ON DOWNSTREAM LANDS

| REV | DATE | BY | APP. | DETAILS | DRAWING STATUS |
|-----|------|----|------|---------|-------------------------------|
| | | | | | DESIGN BY AJS 12/04/07 |
| | | | | | DRAWING CHECK AJS 12/04/07 |
| | | | | | DESIGN CHECK |
| | | | | | FINAL APPROVAL |
| | | | | | PRELIMINARY |

SCALE:
(on A1 Original)
1:1000
HEIGHT DATUM
AHD


Cardno
Forbes Rigby
278 KEIRA STREET, WOLLONGONG, NSW 2500
Ph: 021 4225 4133 Facsimile: 021 4228 6811 ACN: 051 074 982
This drawing is subject to COPYRIGHT. It remains the property of Cardno Forbes Rigby Pty Ltd

PROJECT TITLE
SANDON POINT
RESIDENTIAL SUBDIVISION
for
STOCKLANDS DEVELOPMENTS PTY LTD

DRAWING TITLE
TAILOUT WORKS ON
DOWNSTREAM LAND
Project No. 106062
Com No. 1
Drawing No. 1711
REV P2

Annex C

C. Additional Plans

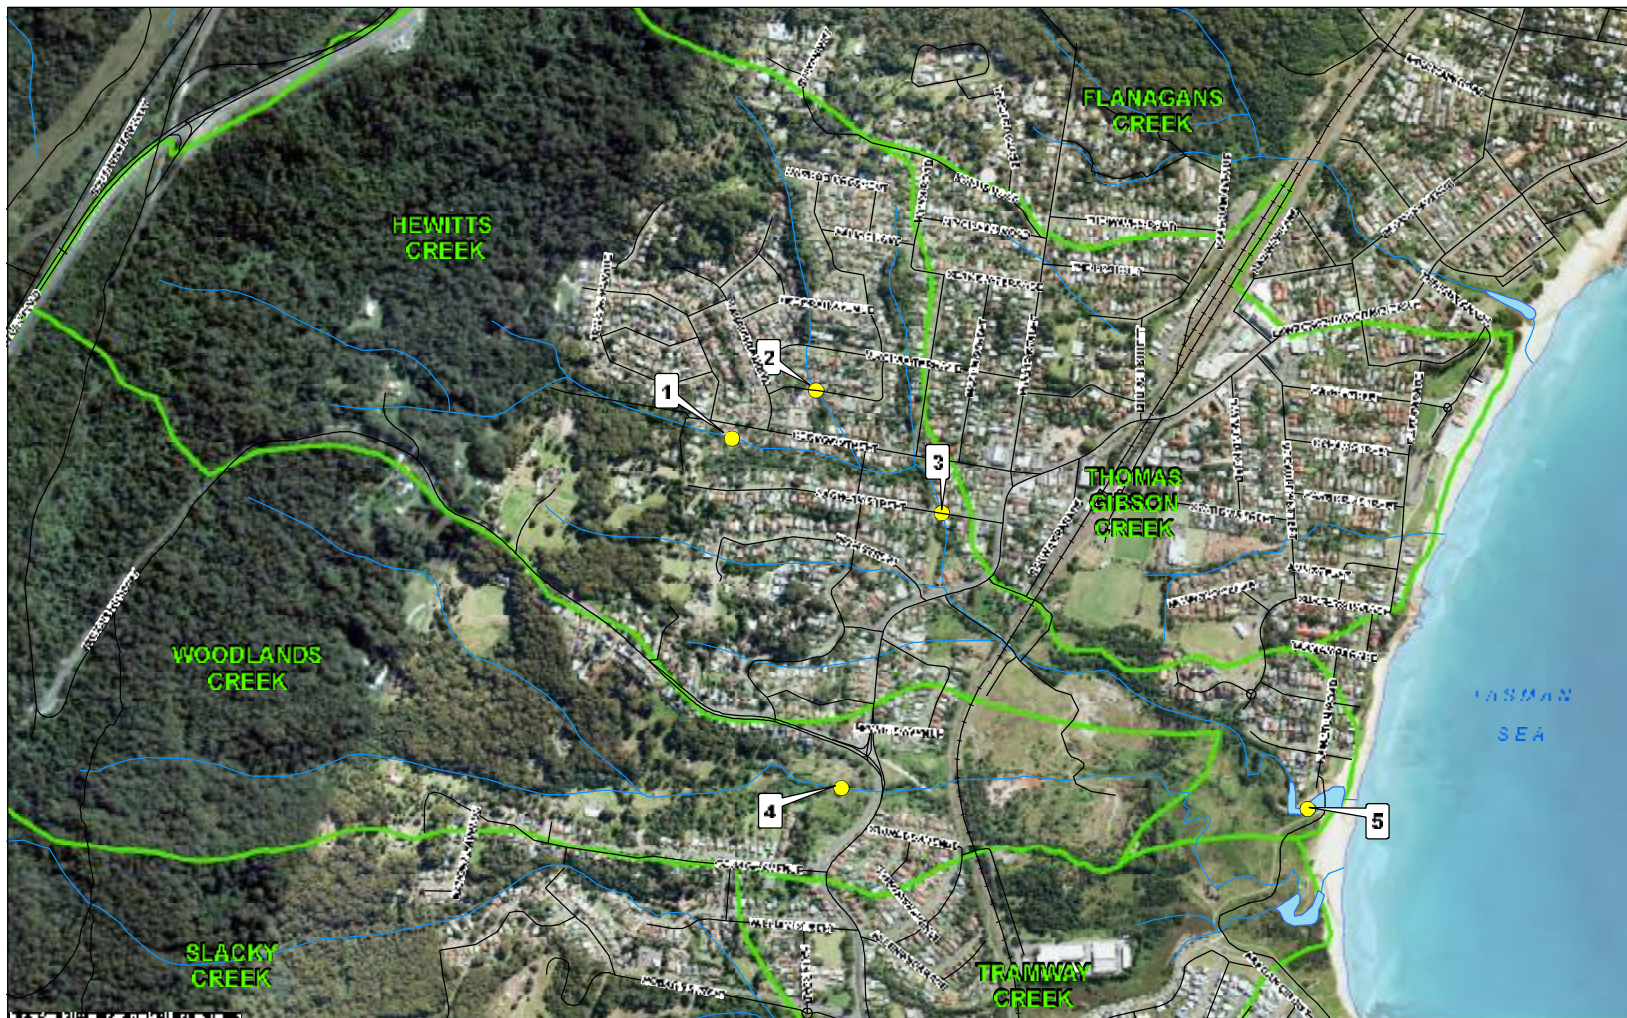

1 - Hewitts Creek at George St Residence



2 - Hewitts Creek at Jennifer St



3 - Hewitts Creek at Lachlan St Culvert



4 - Woodlands Ck at Princes Highway



5 - Hewitts Ck at footbridge downstream of Site



Distribution of Sediment in the Hewitts Creek Catchment

AUGUST 1998 FLOOD EVENT

Legend


- ROAD LANE
- FLOOD LANE
- CATCHMENT BOUNDARY
- OVERFLOW LANE
- SEDIMENT DEPOSIT



Hewitts Creek 17 August 1998 Flood Event

IFD PLOT

AT 07:30 PM

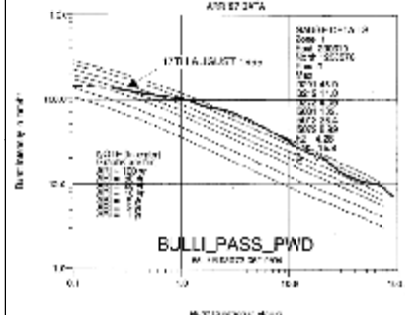

| Date | Total Rainfall | Duration | Flooding | Approx. ARI |
|-----------|----------------|----------|-------------|-------------|
| 4-Mar-78 | 293mm | 5 days | Severe | |
| 20-Mar-78 | 321mm | 3 days | Severe | |
| 14-Oct-83 | 195mm | 1 day | Severe | |
| 6-Aug-86 | 170mm | 3 days | Serious | |
| 20-Aug-87 | 106mm | 3 days | Minor | |
| 29-Aug-88 | 600mm | 5 days | Severe | 5 |
| 2-Feb-90 | 300mm | 3 days | Severe | |
| 31-Jul-90 | 264mm | 3 days | Severe | |
| 6-Jun-91 | 310mm | 6 days | Severe | 10 |
| 8-Feb-92 | 142mm | 6 hrs | Serious | |
| 14-May-95 | 134mm | 6 hrs | Severe | |
| 31-Aug-96 | 230mm | 6 hrs | Very severe | |
| 17-Aug-98 | 316mm | 3 hrs | Extreme | 100 |
| 24-Oct-99 | 118mm | 1 hr | Severe | |