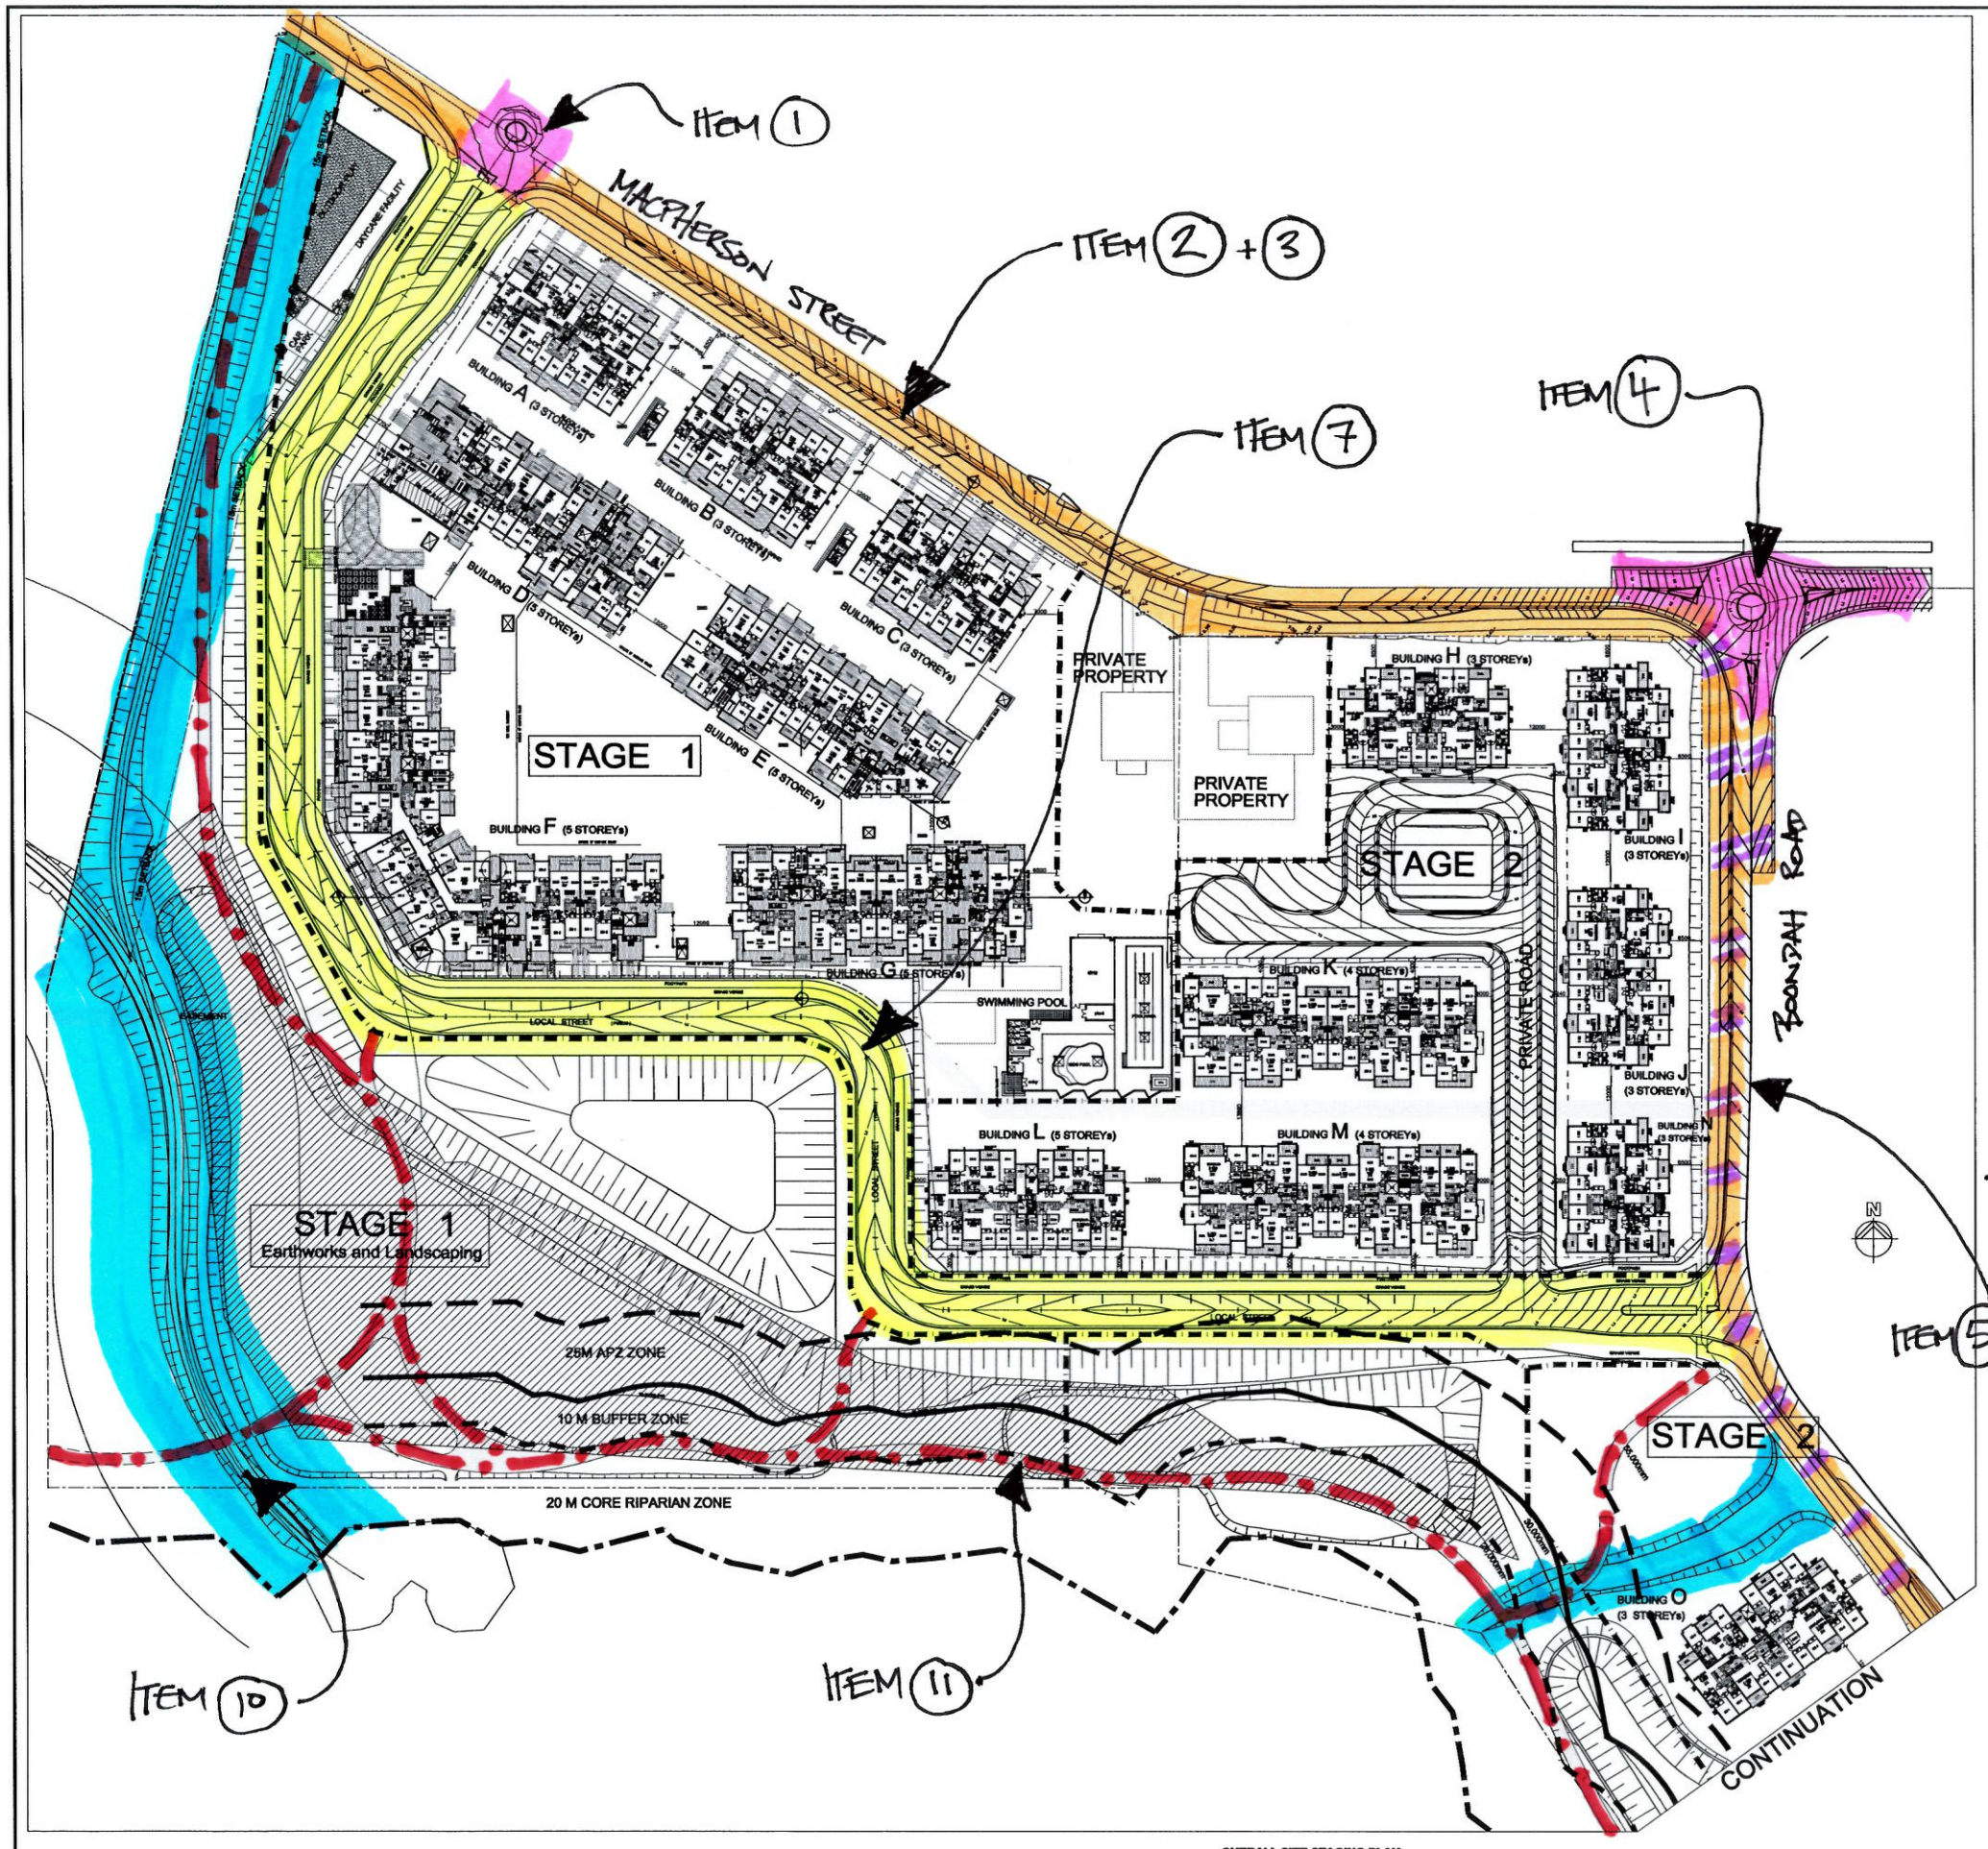

KEY TO PLAN

PROPOSED WORKS IN KIND ITEMS

ITEM 1 = ROUNDABOUT ON MACPHERSON ST.

ITEM 2 = ROADWIDENING ON MACPHERSON ST

ITEM 3 = UNDERGROUNDING ON MACPHERSON ST

ITEM 4 = ROUNDABOUT ON BOONDAH RD

ITEM 5+6 = ROAD WIDENING ON BOONDAH

ITEM 7 = NEW PUBLIC ROAD

~~ITEM 8~~ - (DELETED)

~~ITEM 9~~ - (DELETED)

ITEM 10 = FERN CREEK REHABILITATION AND OVERLAND FLOW.

ITEM 11 = CYCLEWAY INCL BRIDGE OVER CREEK.

~~ITEM 12~~ - (DELETED)

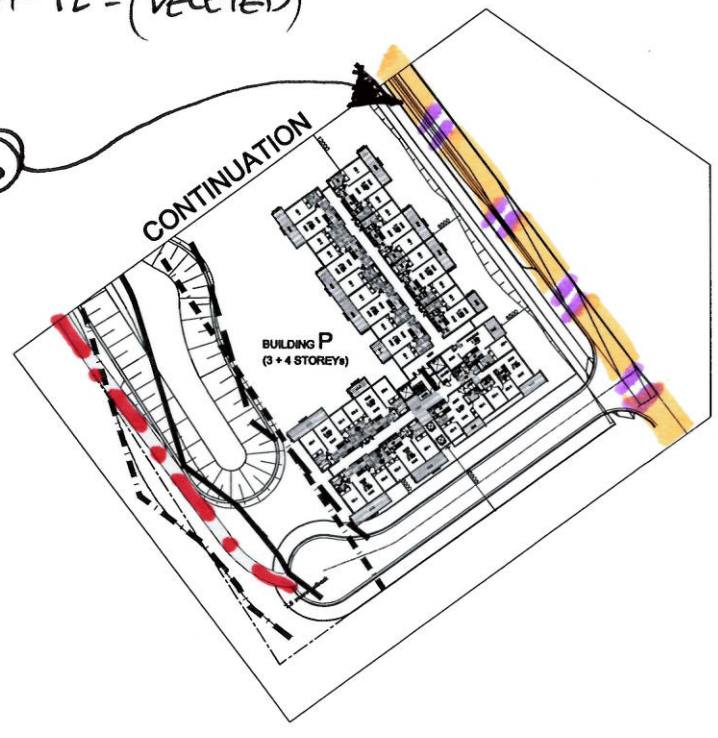

OVERALL SITE-STAGING PLAN

SCALE 1:500

ISSUE	DATE	REVISION	BY	ISSUE	DATE	REVISION	BY
B	———	AMENDMENTS MADE AT COUNCIL REQUEST	AJH				
A	12.05.10	ISSUE FOR DA	AH				

DO NOT SCALE
USE FIGURED DIMENSIONS AT ALL TIMES. IF IN DOUBT CHECK WITH MERITON APARTMENTS PTY. LTD. CONTRACTORS TO CHECK AND VERIFY ALL LEVELS, DATUMS AND DIMENSIONS ON SITE AND SHALL REPORT ANY DISCREPENCIES OR OMMISSIONS TO MERITON APARTMENTS PTY. LTD. PRIOR TO COMMENCEMENT OF WORK AND DURING THE CONSTRUCTION PHASE.

NORTH:

GENERAL NOTES:
THIS DRAWING IS THE EXCLUSIVE PROPERTY OF MERITON APARTMENTS PTY. LTD. AND THE REPRODUCTION OF ANY PART WITHOUT THE PRIOR WRITTEN CONSENT OF MERITON APARTMENTS PTY. LTD. IS A VIOLATION OF APPLICABLE LAWS. IN NO EVENT SHALL MERITON APARTMENTS PTY. LTD. BE HELD LIABLE FOR SPECIAL COLLATERAL, INCIDENTAL OR CONSEQUENTIAL LIABILITY IN CONNECTION WITH THE USE OF THIS DIGITAL DATA ONCE RELEASED FROM THE MERITON APARTMENTS PTY. LTD. TO THE CLIENT.
THIS DRAWING IS TO BE READ AND UNDERSTOOD IN CONJUNCTION WITH THE STRUCTURAL, MECHANICAL, ELECTRICAL AND / OR ANY OTHER CONSULTANTS DOCUMENTATION AS MAY BE APPLICABLE TO THE PROJECT PRIOR TO THE START OF ANY WORKS AND FOR ITS DURATION.

Meriton Apartments Pty. Ltd.
Builders & Developers
Level 11, 888 Kent Street, Sydney NSW 2000
Tel: (02) 9287 2000 Fax: (02) 9287 2777
Email: info@meriton.com.au
Internet: http://www.meriton.com.au

PROJECT:
PROPOSED RESIDENTIAL DEVELOPMENT
NEW RESIDENTIAL DEVELOPMENT
14-18 BOONDAH STREET
WARRIEWOOD, NSW

DRAWING TITLE:
OVERALL SITE-STAGING PLAN

PROJECT No.	DATE	DRAWING No.	REV.
607	9/3/2010	DA01	B
DRAWN BY: AJH	SCALE: 1:500		

CAD FILE: S:\14-18-BOONDAH-RD\ARCH\DA01 OVERALL SITE-STAGING PLAN.DWG